


HAROLD H. KOLB
REGISTERED PROFESSIONAL LAND SURVEYOR
LAKE GENEVA, WISCONSIN

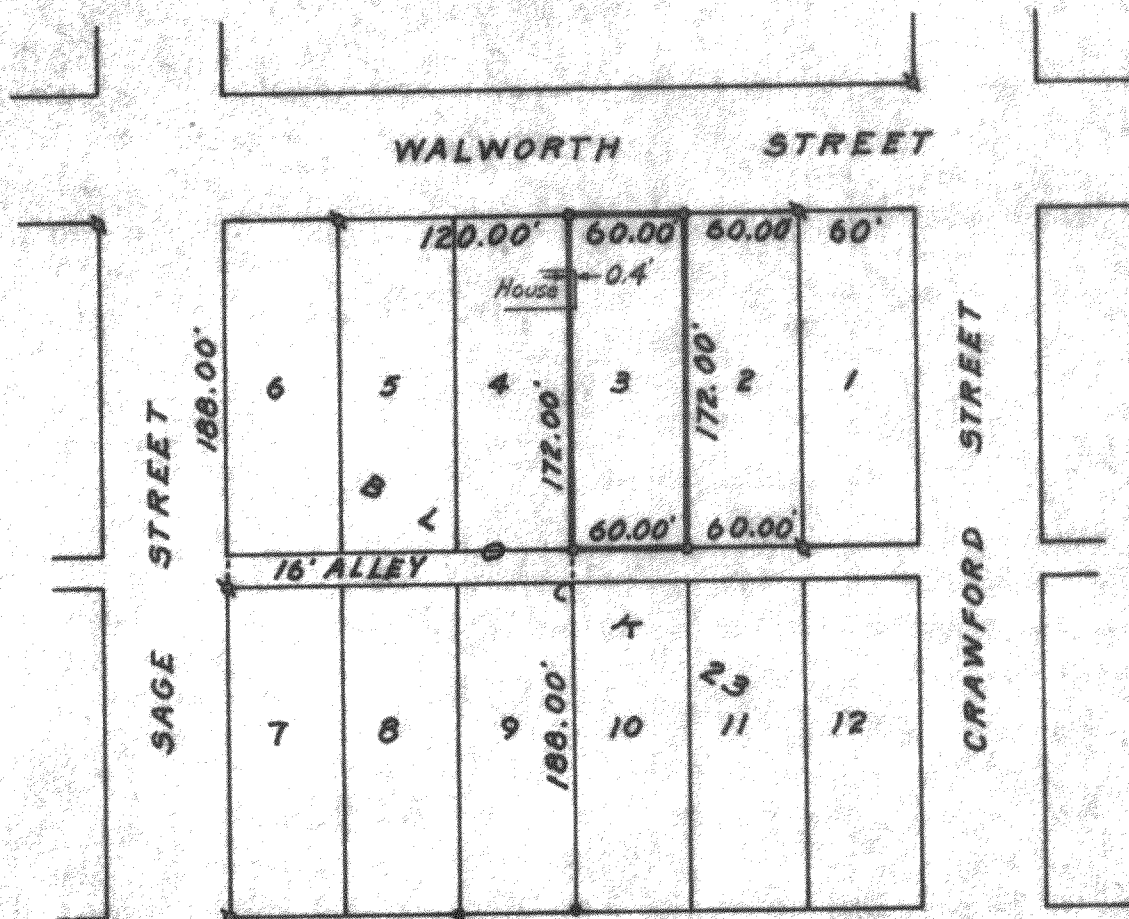

PLAT OF SURVEY OF

Lot 3, Block 23, Geneva Lake Crawford
Manufacturing Company Addition to the
City of Lake Geneva, Walworth County,
Wisconsin.

Harold H. Kolb
Harold H. Kolb, Wisconsin Surveyor, S-187



Scale 1"=100'

- ▲ - Iron Pipe Found
 - - Conc. Monument Found
 - - Iron Pipe Placed
- 4-30-63

7-121