


WALWORTH COUNTY SURVEYING & MAPPING

727 HENRY STREET
LAKE GENEVA, WISCONSIN
414-248-0505

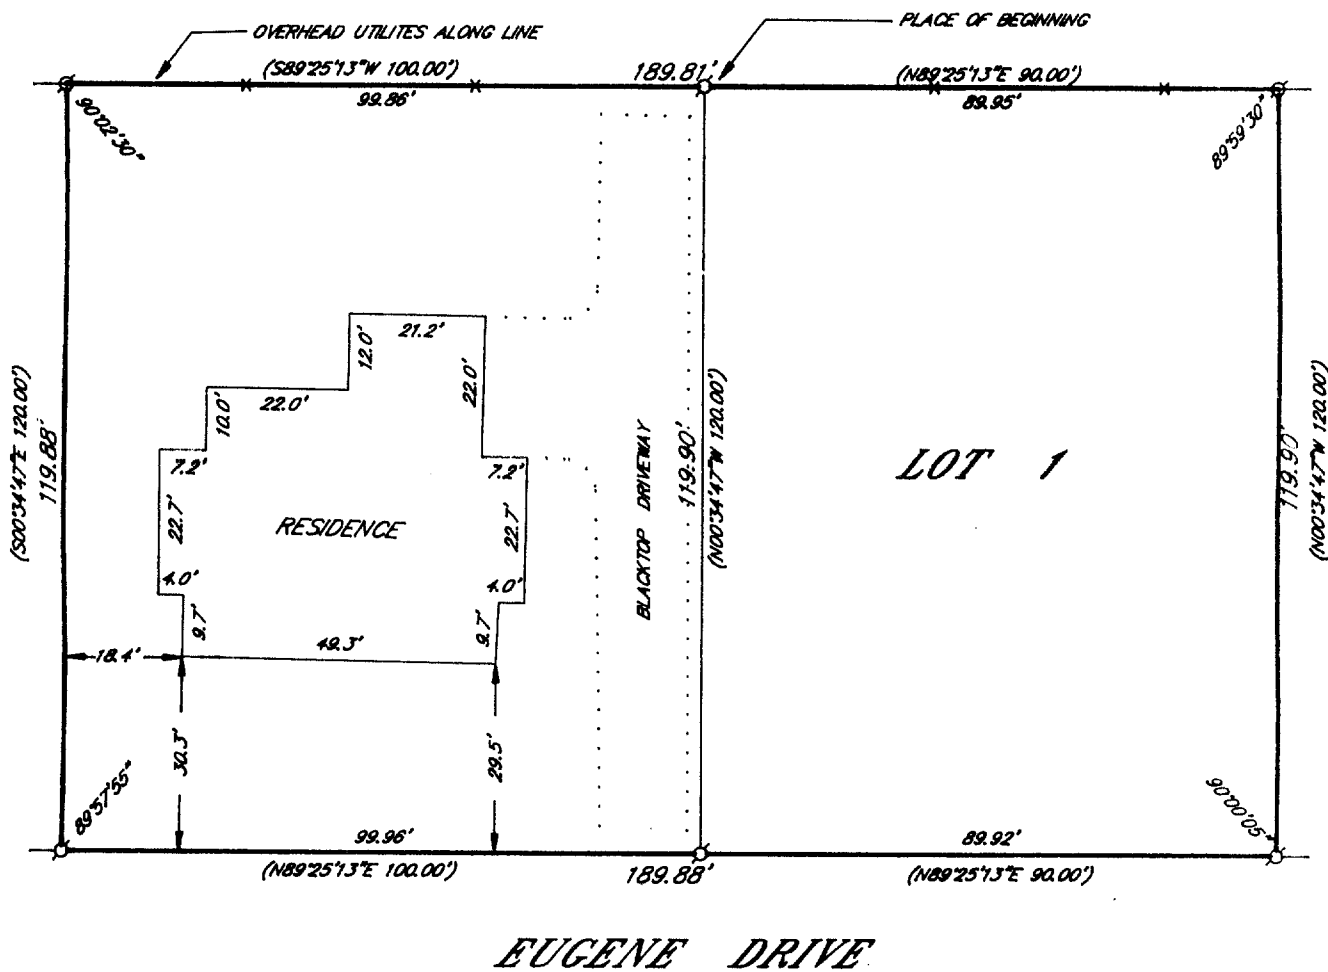

PLAT OF SURVEY OF

LOT 1 IN CERTIFIED SURVEY MAP NO. 1231, BEING A PART OF THE NE 1/4 OF SECTION 1, IN T 1 N, R 17 E, IN THE CITY OF LAKE GENEVA, RECORDED ON JUNE 25, 1982 IN VOLUME 5 OF CERTIFIED SURVEY MAPS AT PAGE 343, AS DOCUMENT NO. 79131.

ALSO, BEGINNING AT A POINT 919.75 FEET NORTH AND 1125.96 FEET WEST OF THE SE CORNER OF THE NE 1/4 OF SECTION 1, T 1 N, R 17 E, THENCE NORTH ALONG THE WEST LINE OF DOORWOOD DRIVE 627.65 FEET TO A POINT; THENCE S89°25'13"W 812.06 FEET TO THE PLACE OF BEGINNING; THENCE CONTINUE S89°25'13"W 100.00 FEET; THENCE S00°34'47"E 120.00 FEET; THENCE N89°25'13"E 100.00 FEET; THENCE N00°34'47"W 120.00 FEET TO THE PLACE OF BEGINNING.

ORDERED BY: VACATION PROPERTIES NETWORK
101 BROAD STREET
LAKE GENEVA, WISCONSIN 53147



I HEREBY CERTIFY THAT I HAVE SURVEYED THE ABOVE DESCRIBED PROPERTY AND THAT THE ABOVE MAP IS A TRUE REPRESENTATION THEREOF AND SHOWS THE SIZE AND LOCATION OF THE PROPERTY, ITS EXTERIOR BOUNDARIES, THE LOCATION OF ALL VISIBLE STRUCTURES AND DIMENSIONS OF ALL PRINCIPAL BUILDINGS THEREON, BOUNDARY FENCES, APPARENT EASEMENTS, ROADWAYS AND VISIBLE ENCROACHMENTS, IF ANY, TO THE BEST OF MY KNOWLEDGE AND BELIEF.

THIS SURVEY IS MADE FOR THE USE OF THE PRESENT OWNER OF THE PROPERTY AND ALSO THOSE WHO PURCHASE, MORTGAGE OR GUARANTEE THE TITLE THEREIN WITHIN ONE (1) YEAR FROM DATE HEREOF.

ROBERT M. BAERENWALD
WISCONSIN REGISTERED LAND SURVEYOR, S-1508

DATE JUN. 31, 1990 JOB NO. 2337

NOTE: THIS IS NOT A CERTIFIED COPY UNLESS SEALED.

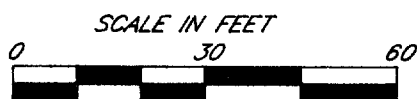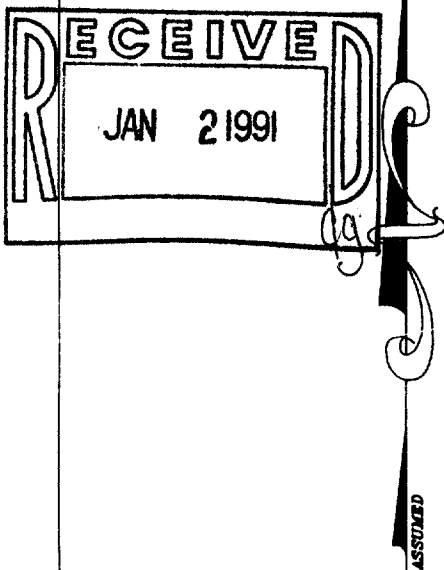

LEGEND

- IS-IRON PIPE FOUND
- IS-IRON ROD FOUND
- CONCRETE MONUMENT FOUND
- O-IRON PIPE PLACED
- ()-RECORDED AS

Survey # 007-1214

TAX KEY #
ZA 123100001