



LAKE GENEVA BLVD.

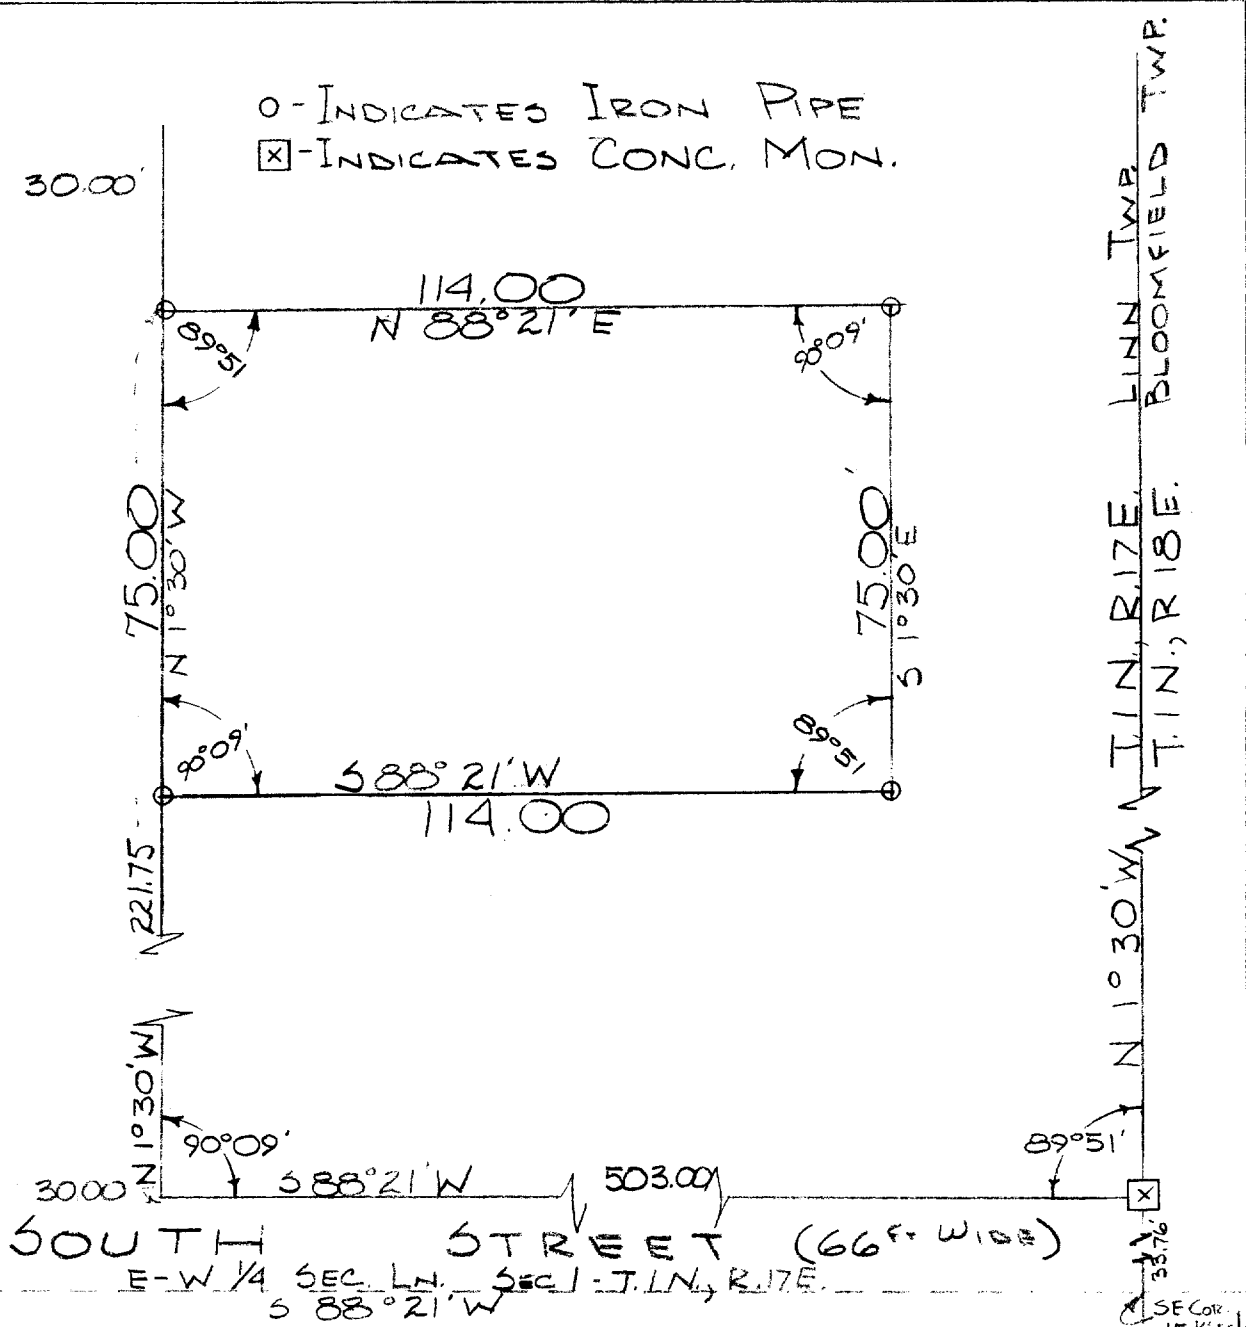

DESCRIPTION: Commencing at a concrete monument that is 33.76 feet North of the SE corner of the NE 1/4 of Section 1 T. 1 N., R. 17 E., in the City of Lake Geneva, Walworth County, Wisconsin; run thence west parallel to the E-W 1/4 Sec. line of said Sec. 1 503.00 ft. to the Easterly line of Lake Geneva Blvd., thence run North parallel to the easterly line of said section 1, 221.75 feet to the place of beginning of the lands hereinafter described; thence easterly parallel to the E-W 1/4 line, 114.00 feet to an iron stake, thence southerly parallel to the east line of said section 75.00 feet to an iron stake, thence westerly parallel to the E-W 1/4 section line 114.00 feet to the east line of Lake Geneva Blvd., thence north parallel to the east line of said section 75.00 feet to the place of beginning.

CERTIFICATE: I, James F. Biagi, surveyor, do hereby certify that I have surveyed the property hereon described on this 26th day of December 1961.

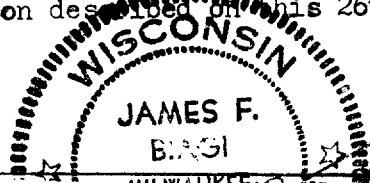

James F. Biagi RLS 272

Part of Lot 61 + 62 Blad Sub.

ZBL-61

BL-35

7-121B