



HAROLD H. KOLB

REGISTERED PROFESSIONAL LAND SURVEYOR
LAKE GENEVA, WISCONSIN

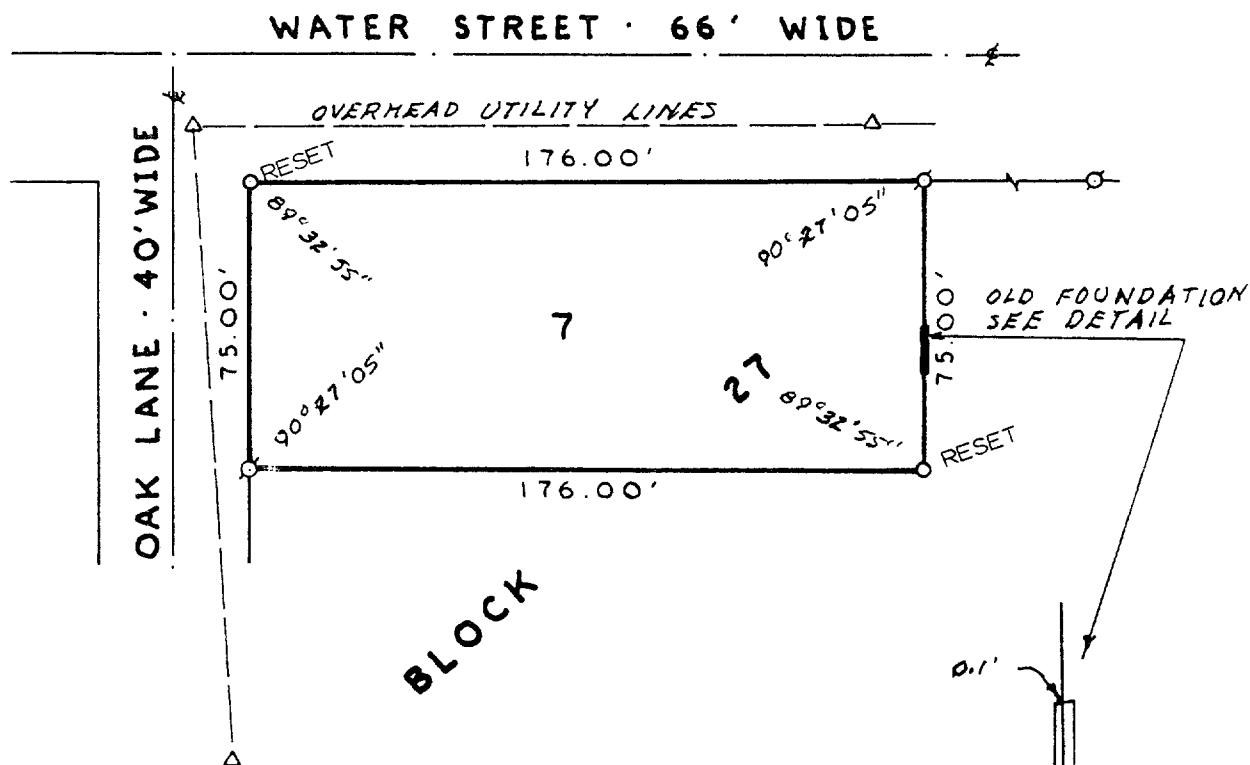

N

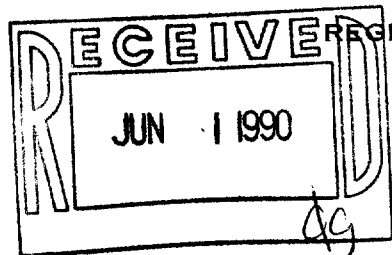

SCALE: 1" = 50'

LEGEND


- φ — IRON PIPE FOUND
- — IRON PIPE PLACED
- — CONCRETE MONUMENT
- x — SPIKE

PLAT OF SURVEY OF

Lot 7, Block 27, Geneva Lake Crawford
Manufacturing Company Addition, Lake
Geneva, Wisconsin.

RESURVEYED MAY 11, 1990

HAROLD H. KOLB

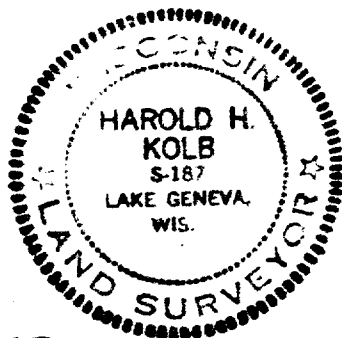

I, HAROLD H. KOLB, DO HEREBY CERTIFY THAT I HAVE
SURVEYED THE PROPERTY HEREON DESCRIBED ACCORDING
TO THE OFFICIAL RECORDS, AND THAT THE PLAT HEREON
IS A CORRECT REPRESENTATION OF THE LOT LINES, AND
THE IMPROVEMENTS THEREON.

Harold H. Kolb

HAROLD H. KOLB
WISCONSIN REGISTERED LAND SURVEYOR, S-187
DATE January 4, 1972

REVISED: Feb. 7, 1974
Revised: July 19, 1978

007-1253