


PLAT OF SURVEY OF

Lot 38 and the West 5' of Lot 37 of WATSON'S BOULEVARD ADDITION
TO THE VILLAGE OF LAKE GENEVA, located in Section 25, T 2 N, R 17 E,
City of Lake Geneva, Walworth County, Wisconsin.

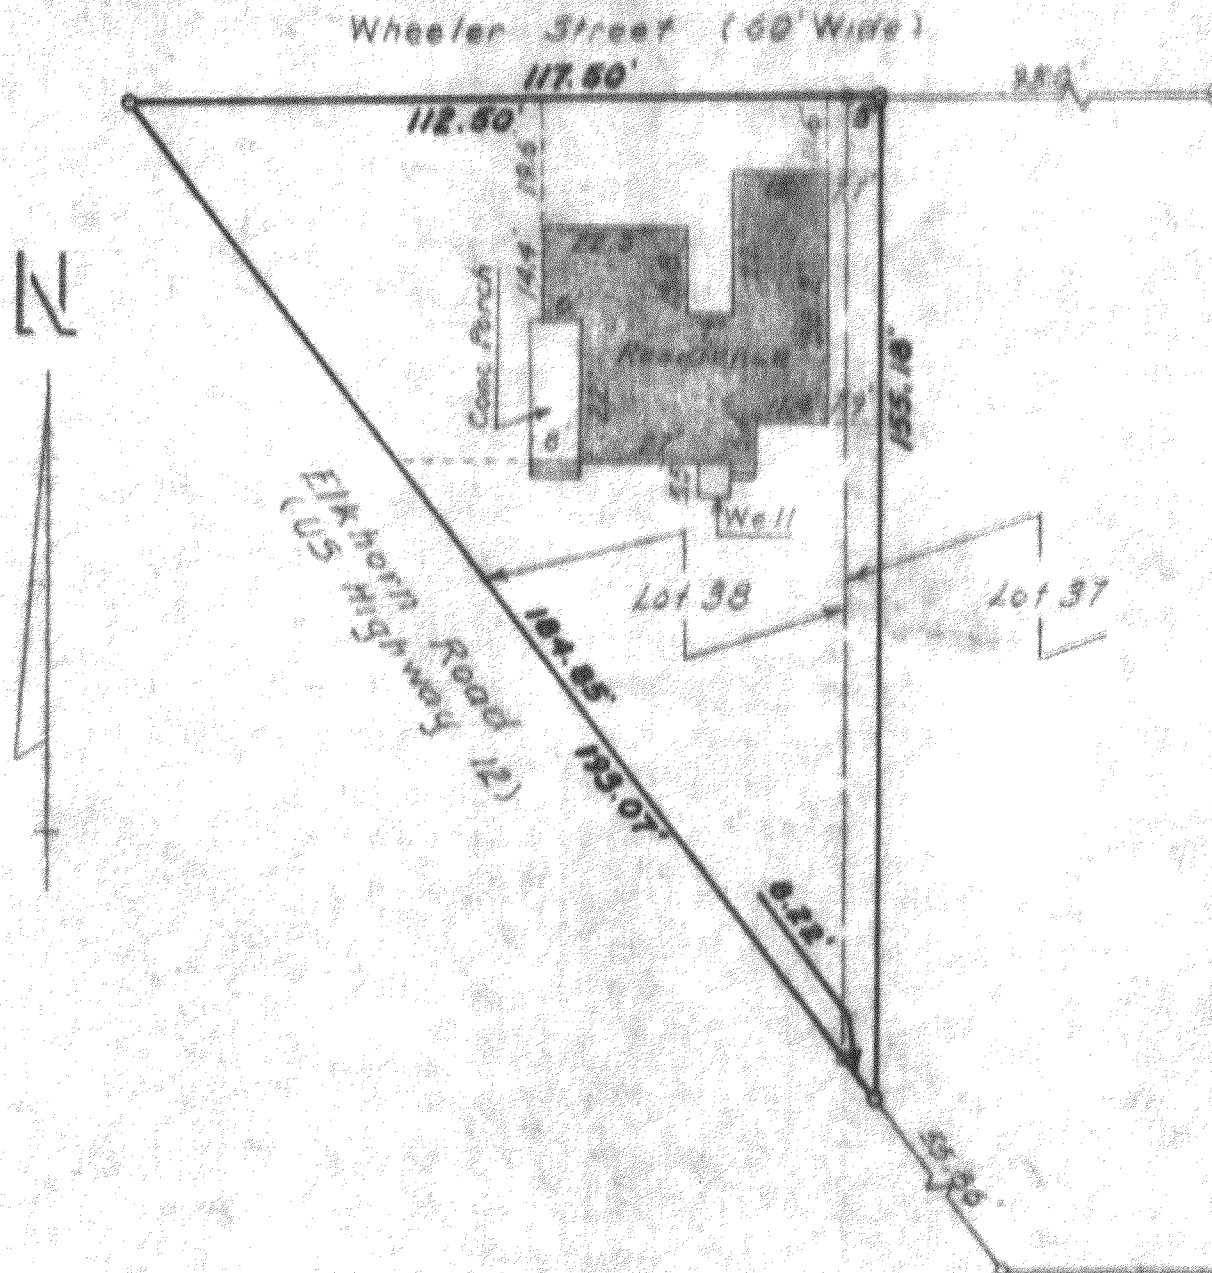

o - Iron Pipe Placed
o - Iron Pipe Found

March, 1962

Harold H. Kolb

Harold H. Kolb
Registered Land Surveyor S-187

WB-27A

7-126