

928 WILLIAMS STREET LAKE GENEVA, WISCONSIN 53147 414-248-3887

LOT 12



LEGEND

Ø - IRON PIPE FOUND
 ■ - IRON ROD FOUND
 X - CUT CROSS IN CONCRETE
 ○ - IRON PIPE SET

B _ L _ O _ C _ K _

COMMERCIAL BUILDING

BUILDING 0.8'
EAST OF LINE

BUILDING 0.8'
EAST OF LINE

BUILDING 0.9¹
EAST OF LINE

BUILDING 1.0'
EAST OF LINE

BUILDING 1.2
EAST OF LINE

CANOPY SUPPORT 1.3'
EAST OF LINE

CANOPY SUPPORT 1.3
EAST OF LINE

SIDEWALK
SIGN 0.4'
EAST OF LINE


PLAT OF SURVEY OF

PART OF LOTS 11 AND 12, BLOCK 12 OF THE
ORIGINAL PLAT OF THE VILLAGE, NOW CITY
OF LAKE GENEVA, WALWORTH COUNTY, WISCONSIN.

ORDERED BY: CITIZENS NATIONAL BANK
OF LAKE GENEVA
401 BROAD STREET
LAKE GENEVA, WI 53147

BROAD STREET

00' 00" WIDE

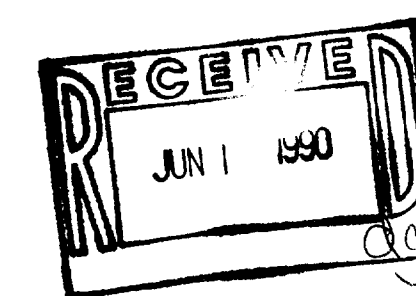

I, HAROLD H. KOLB, DO HEREBY CERTIFY THAT I HAVE SURVEYED THE PROPERTY HEREON DESCRIBED ACCORDING TO THE OFFICAL RECORDS, AND THAT THE PLAT HEREON IS A CORRECT REPRESENTATION OF THE LOT LINES TO THE BEST OF MY KNOWLEDGE AND BELIEF

NOTE: SURVEY IS NOT VALID UNLESS SURVEYOR'S
SIGNATURE IS IN RED.

HAROLD H KOLB

WISCONSIN REGISTERED LAND SURVEYOR, S-187

DATE APRIL 18, 1990

WISCONSIN STREET

80' WIDE

007-1260

ZOP 00105
ZOP 00106