

WANAGAS SURVEYING
P.O. BOX 572 HEBRON, IL. 60034
PLAT OF SURVEY

P.O. BOX 572 HEBRON, IL, 60034




SCALE 1" = 20'

DESCRIPTION SUPPLIED

LOT 7 IN BLOCK 22 IN GENEVA - LAKE CRAWFORD MFG. CO.'S ADDITION IN PART OF SECTION 25, TOWNSHIP 2 NORTH, RANGE 17 EAST OF THE FOURTH PRINCIPAL MERIDIAN, IN WALWORTH COUNTY, WISCONSIN.

WORK ORDER NO. 900909

SHEET 1 OF 1

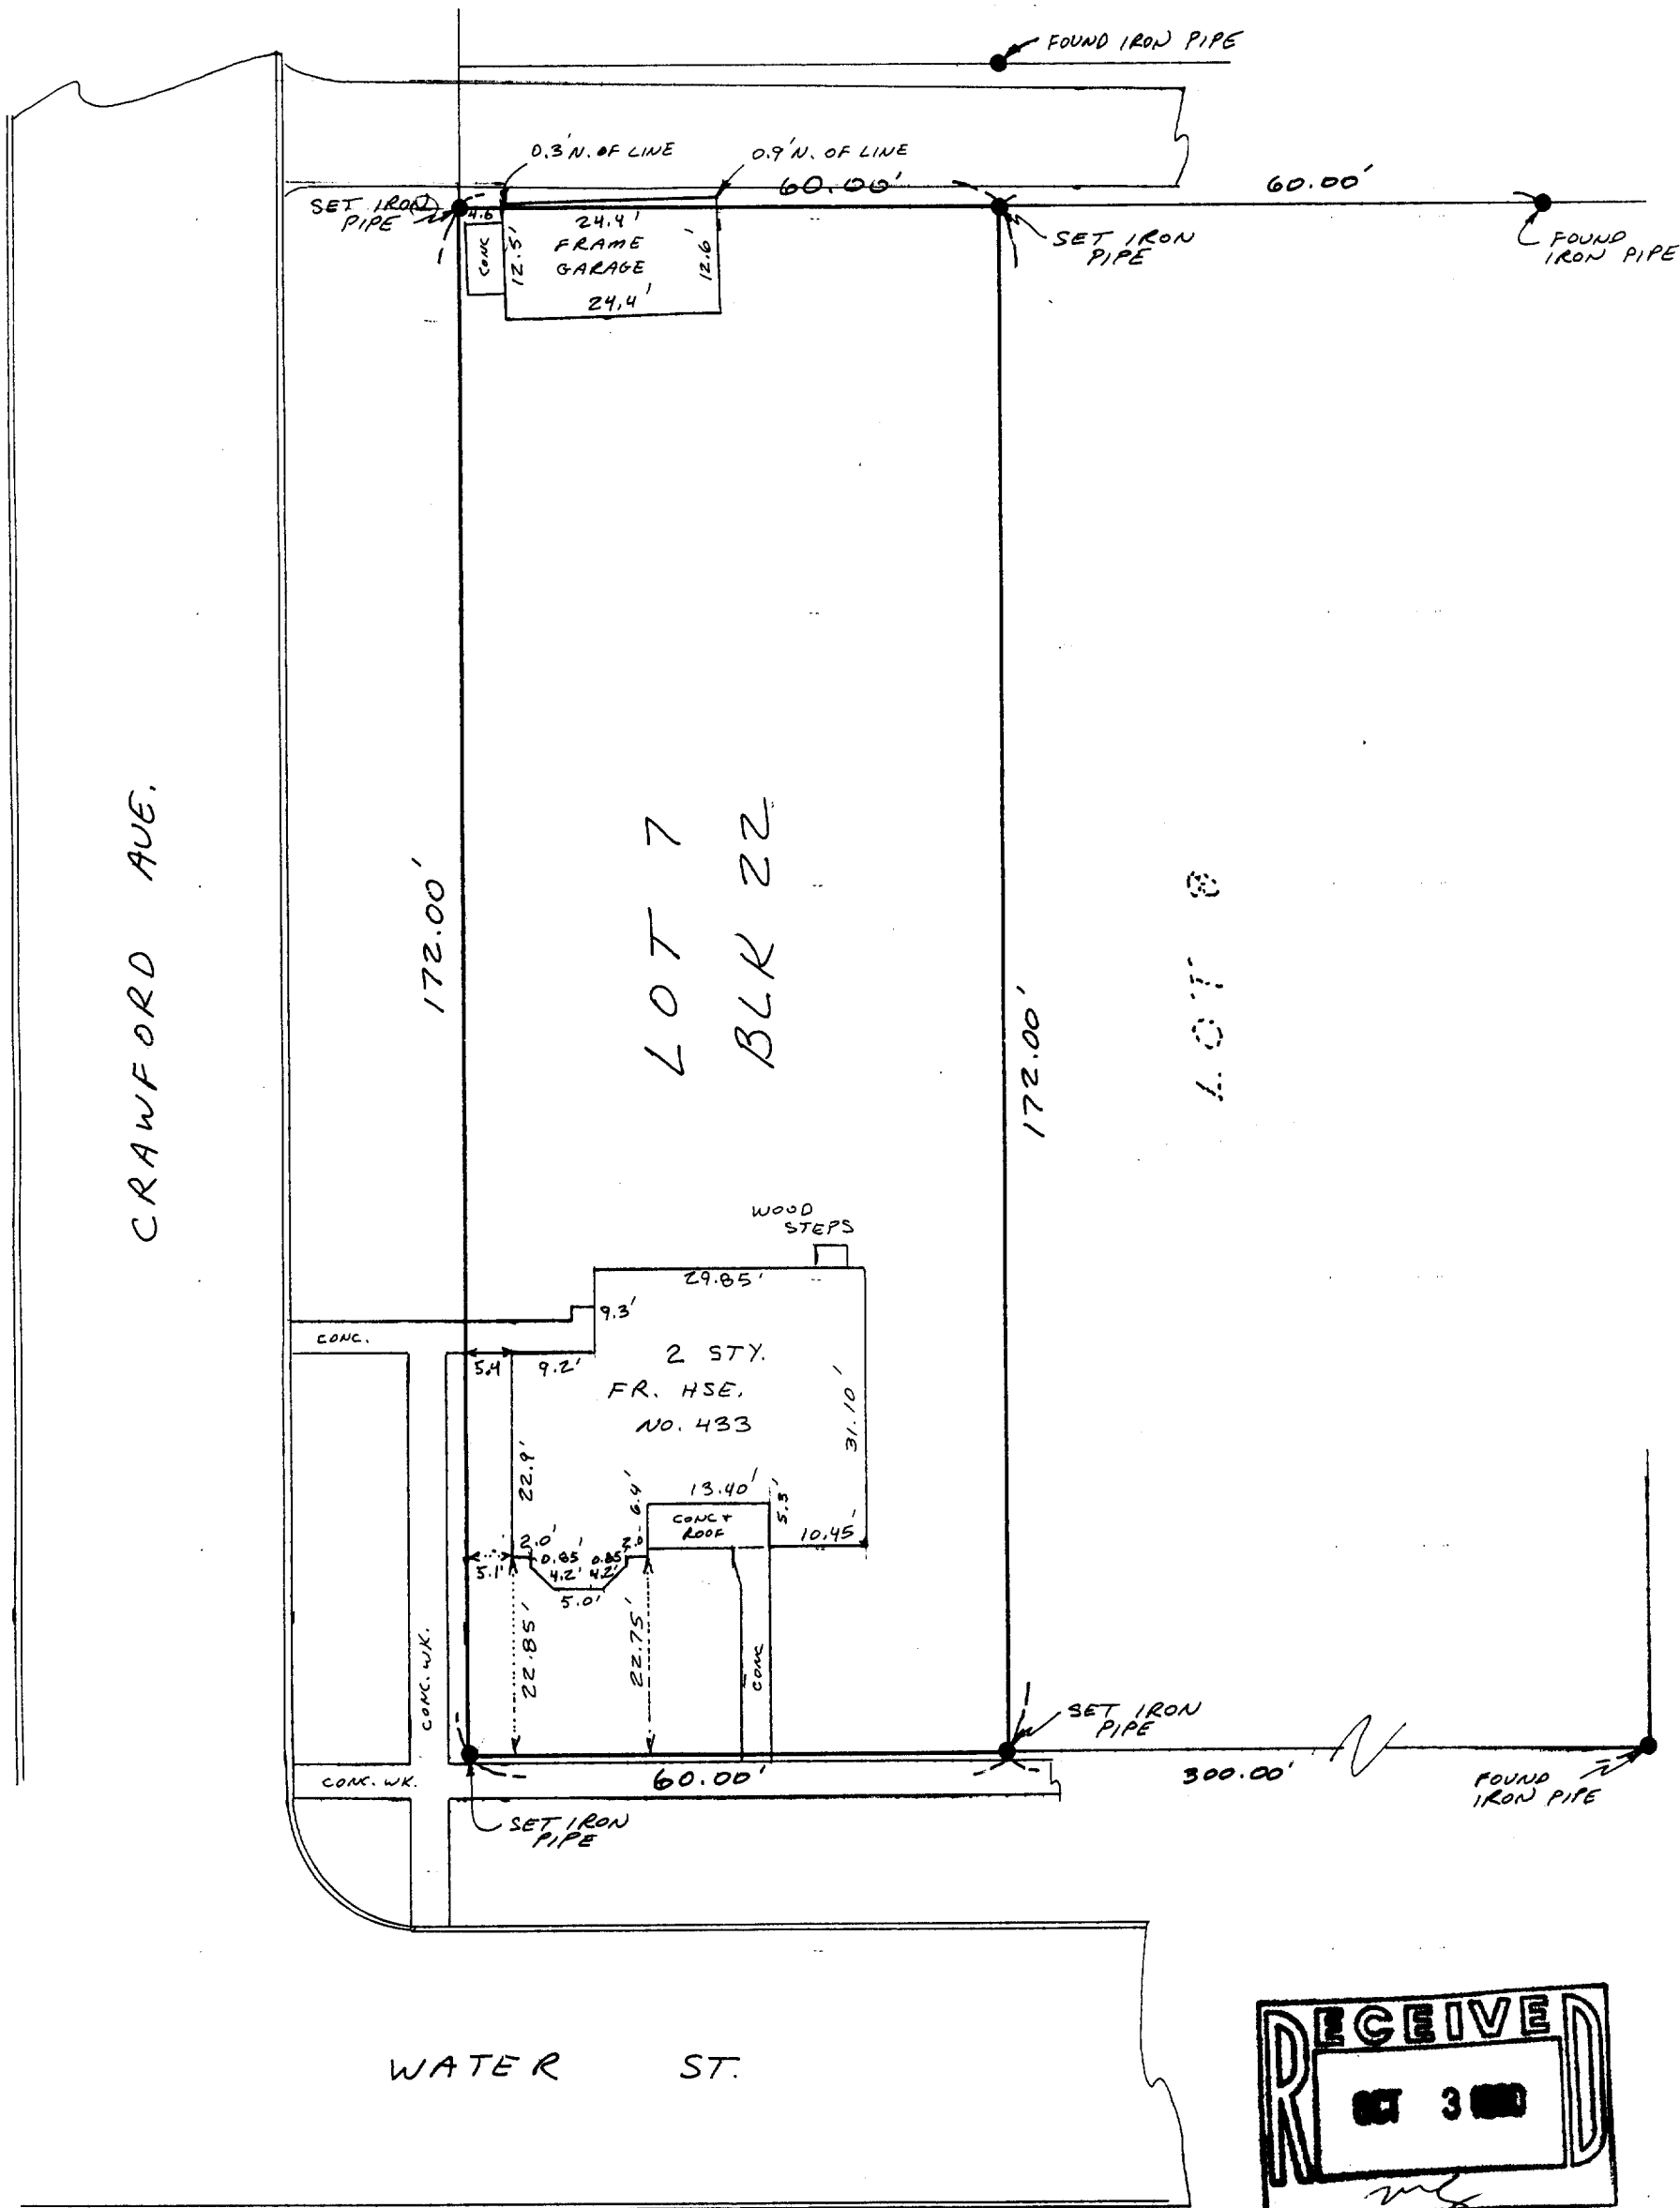

STATE OF ILLINOIS)
COUNTY OF MCHENRY)

I HEREBY CERTIFY THAT I HAVE SURVEYED THE ABOVE DESCRIBED
PROPERTY, AND THAT THE PLAT HEREON DRAWN IS A CORRECT
REPRESENTATION OF SAID SURVEY. DATED 9-25-90

Kenneth B. Wanzon

KENNETH B. WANAGAS
PROFESSIONAL LAND SURVEYOR
WISCONSIN NO. 1420

NOTES:

- NOTES:
1. Please refer to your Deed, Title Policy, or local building and zoning restrictions for building lines, restrictions, and/or easements not shown hereon.
 2. On receipt of this survey and your inspection of the survey markers, report any apparent discrepancy to the surveyor immediately.

DD 7-1270

ZGC $\phi\phi 125$