




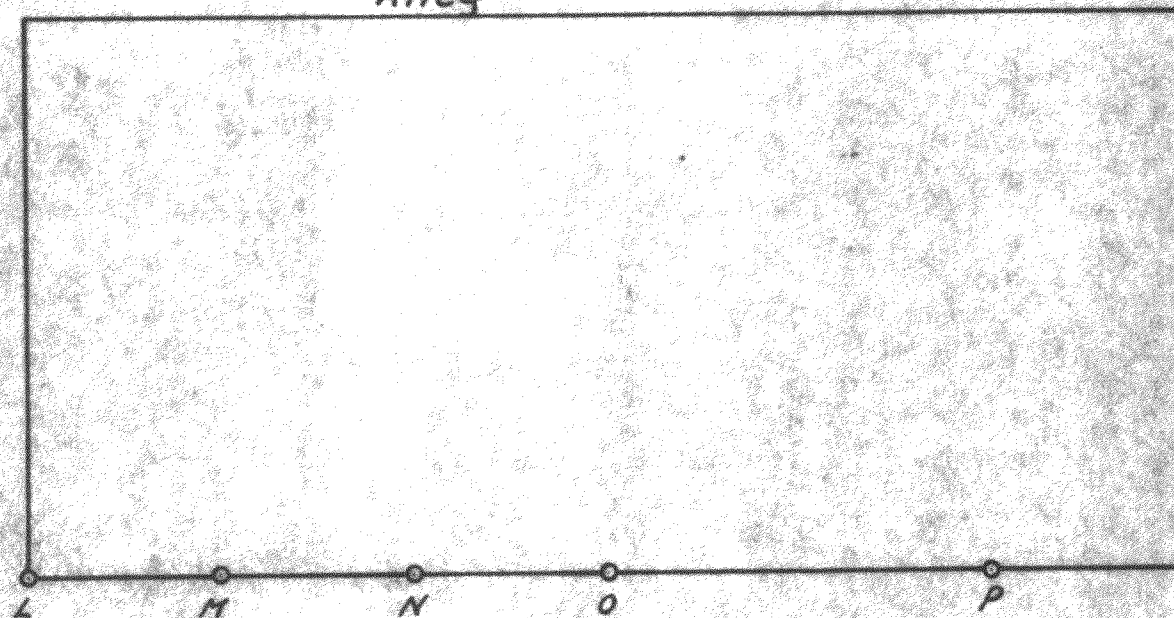

Street

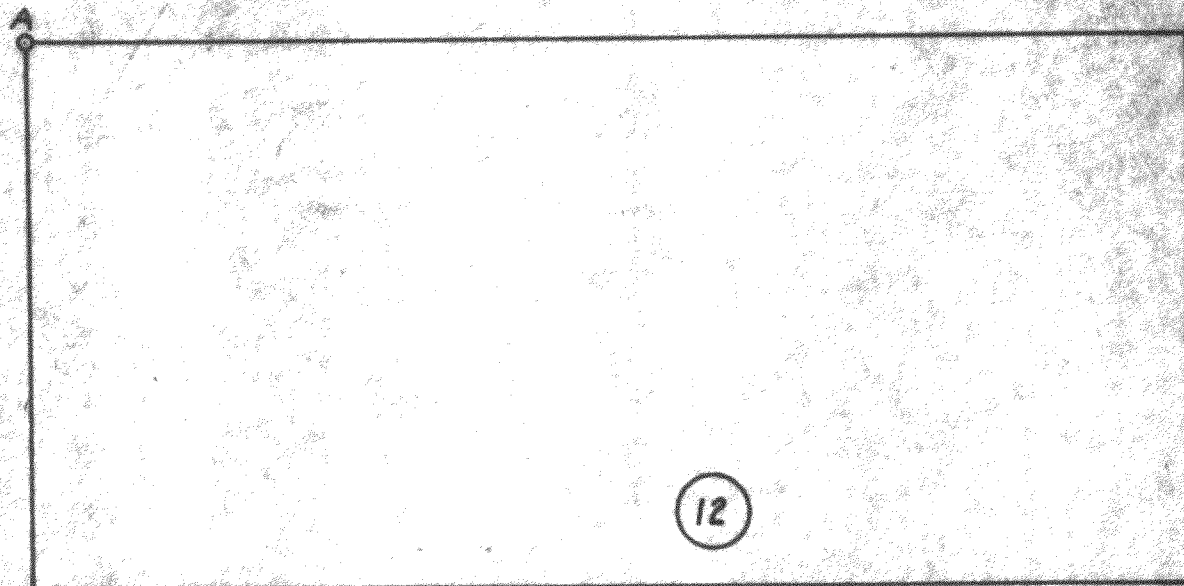

Cook

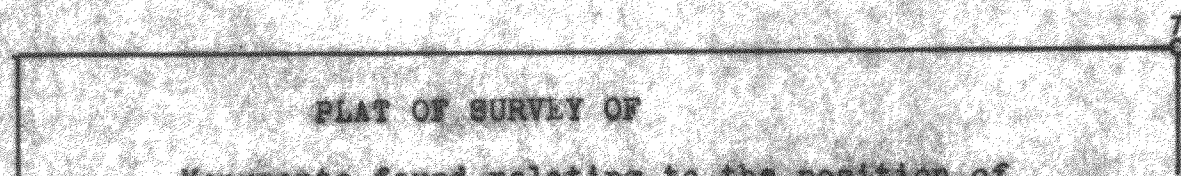


PLAT OF SURVEY OF
Monuments found relating to the position of
Lots 7 & 8, Block 13. Original plat of the Village
(now City) of Lake Geneva, Walworth County, Wis.


Harold H. Kolb
Harold H. Kolb
Wis. Reg. Surveyor 8-187

2P-116, 117


Street

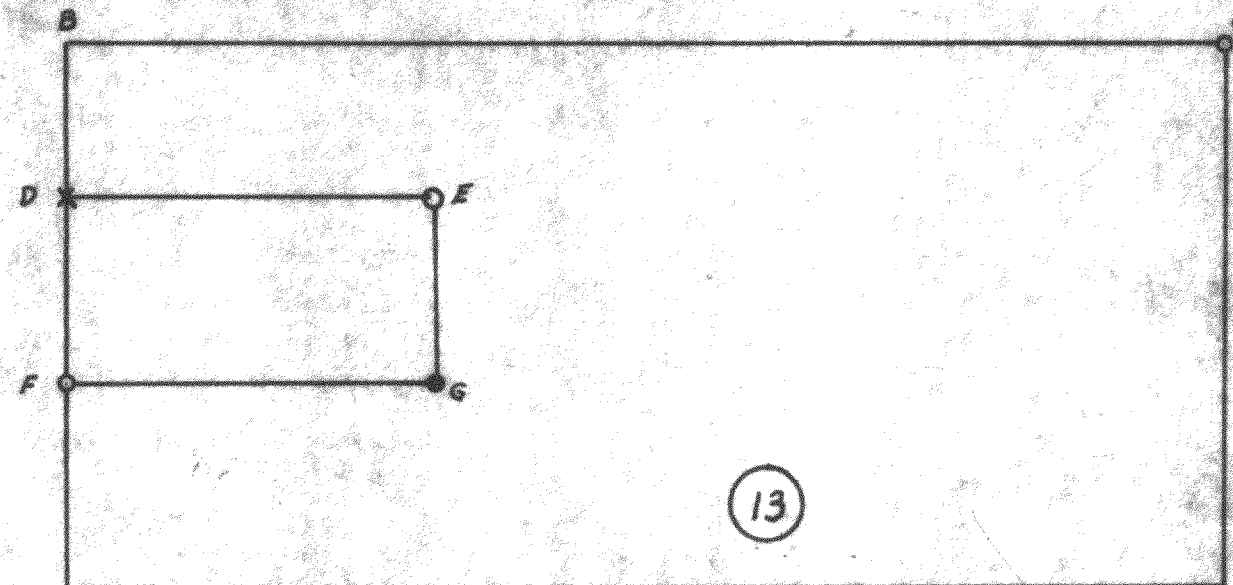

Broad Street

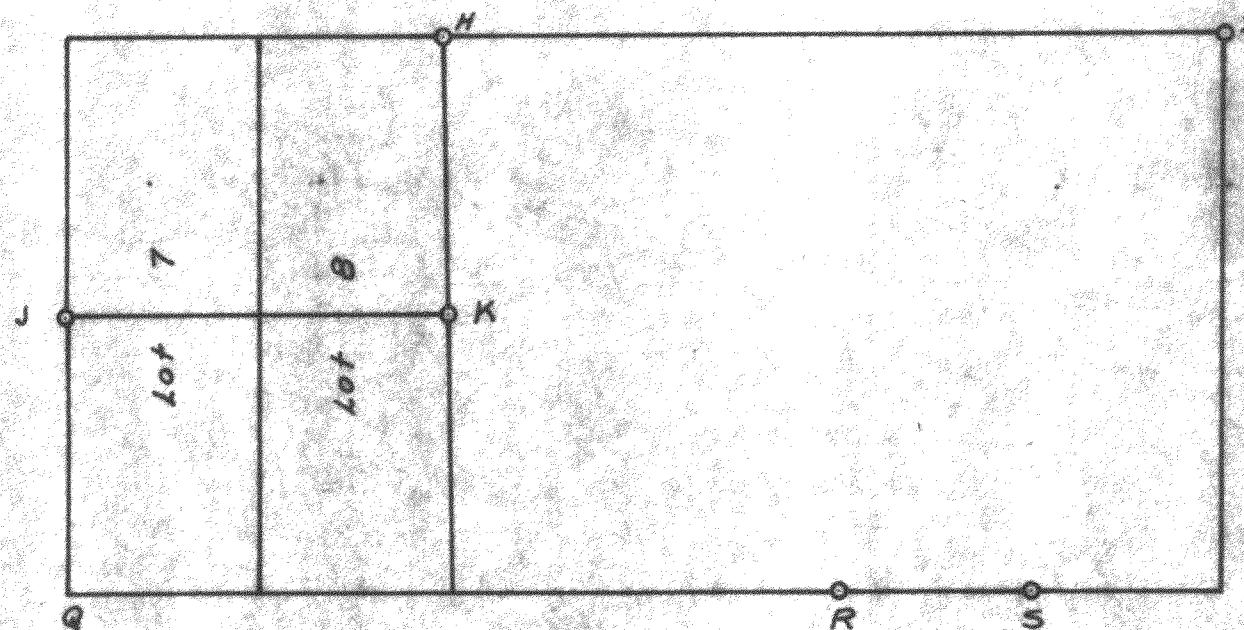

Street

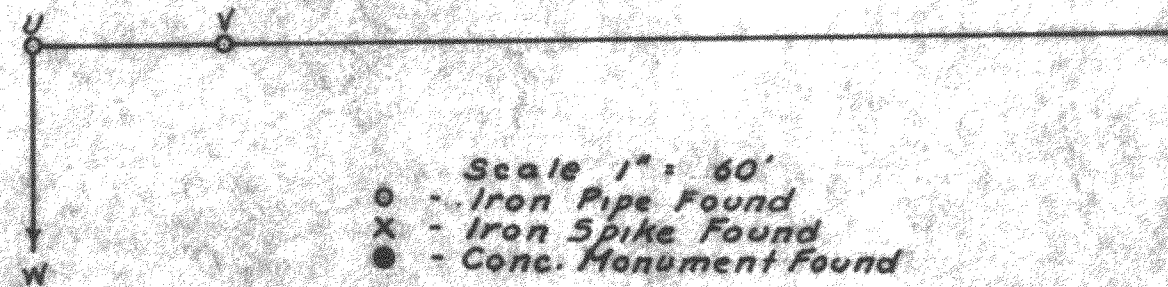

Scale 1" = 60'
O - Iron Pipe Found
X - Iron Spike Found
● - Conc. Monument Found

7-130
4-25-62