

ABELL SURVEYING & MAPPING

DELAVER, WISCONSIN 53115

414-728-6737

DODGE

STREET


N



SCALE 1"=20'


LEGEND

- - IRON PIPE FOUND
- - IRON ROD FOUND
- ✕ - CUT CROSS IN CONCRETE FOUND
- CS - CONCRETE STOOP
- BE - BASEMENT ENTRY
- - OVERHEAD UTILITY LINES
- ✕ - FENCE
- () - RECORDED AS

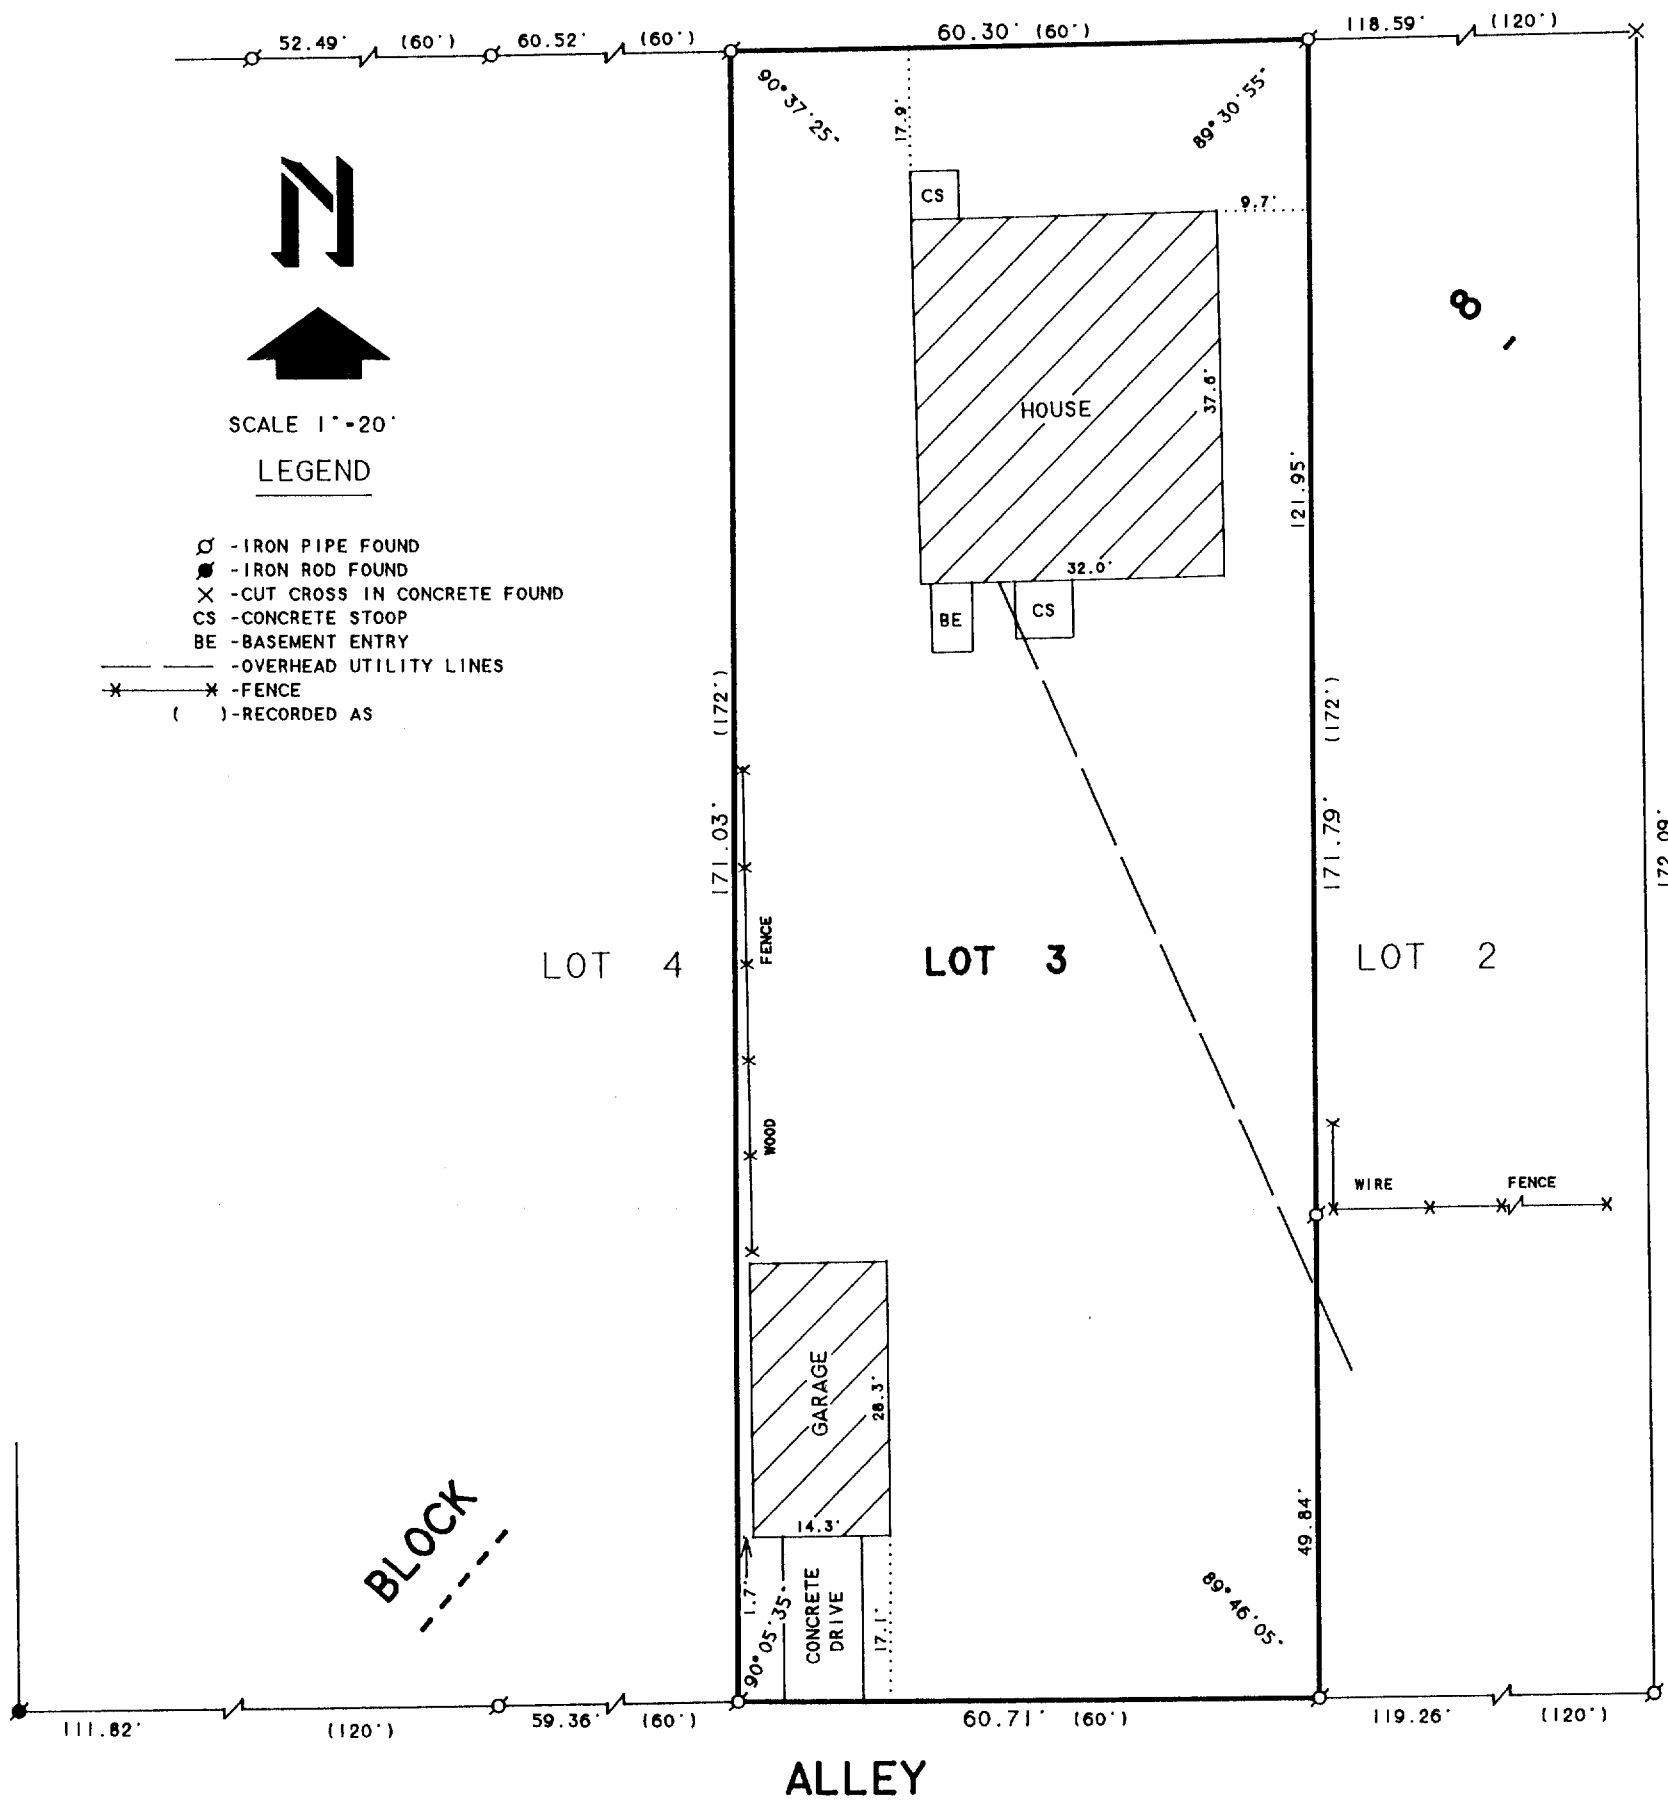

PLAT OF SURVEY OF

LOT 3, BLOCK 8, OF THE ORIGINAL PLAT, CITY
OF LAKE GENEVA, WALWORTH COUNTY, WISCONSIN.

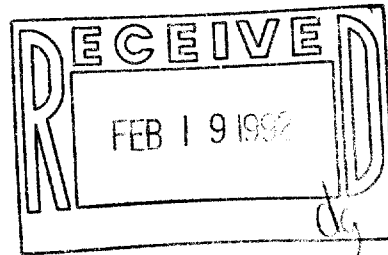

I HEREBY CERTIFY THAT I HAVE SURVEYED THE ABOVE DESCRIBED PROPERTY AND THAT THE ABOVE MAP IS A TRUE REPRESENTATION THEREOF AND SHOWS THE SIZE AND LOCATION OF THE PROPERTY, ITS EXTERIOR BOUNDARIES, THE LOCATION OF ALL VISIBLE STRUCTURES AND DIMENSIONS OF ALL PRINCIPAL BUILDINGS THEREON, BOUNDARY FENCES, APPARENT EASEMENTS, ROADWAYS AND VISIBLE ENCROACHMENTS, IF ANY, TO THE BEST OF MY KNOWLEDGE AND BELIEF.

THIS SURVEY IS MADE FOR THE USE OF THE PRESENT OWNERS OF THE PROPERTY, AND ALSO THOSE WHO PURCHASE, MORTGAGE, OR GUARANTEE THE TITLE THERETO WITHIN ONE (1) YEAR FROM DATE HEREON.

David F. Abell

DAVID F. ABELL
WISCONSIN REGISTERED LAND SURVEYOR. S-1596

ORDERED BY: KEEFE REAL ESTATE
704 MAIN STREET
LAKE GENEVA, WI. 53147

January 20, 1992

DATE: JOB NUMBER - 92009
NOTE: THIS IS NOT A CERTIFIED COPY UNLESS SEALED.

007-1304

20P-50