


HAROLD H. KOLB
REGISTERED PROFESSIONAL LAND SURVEYOR
LAKE GENEVA, WISCONSIN

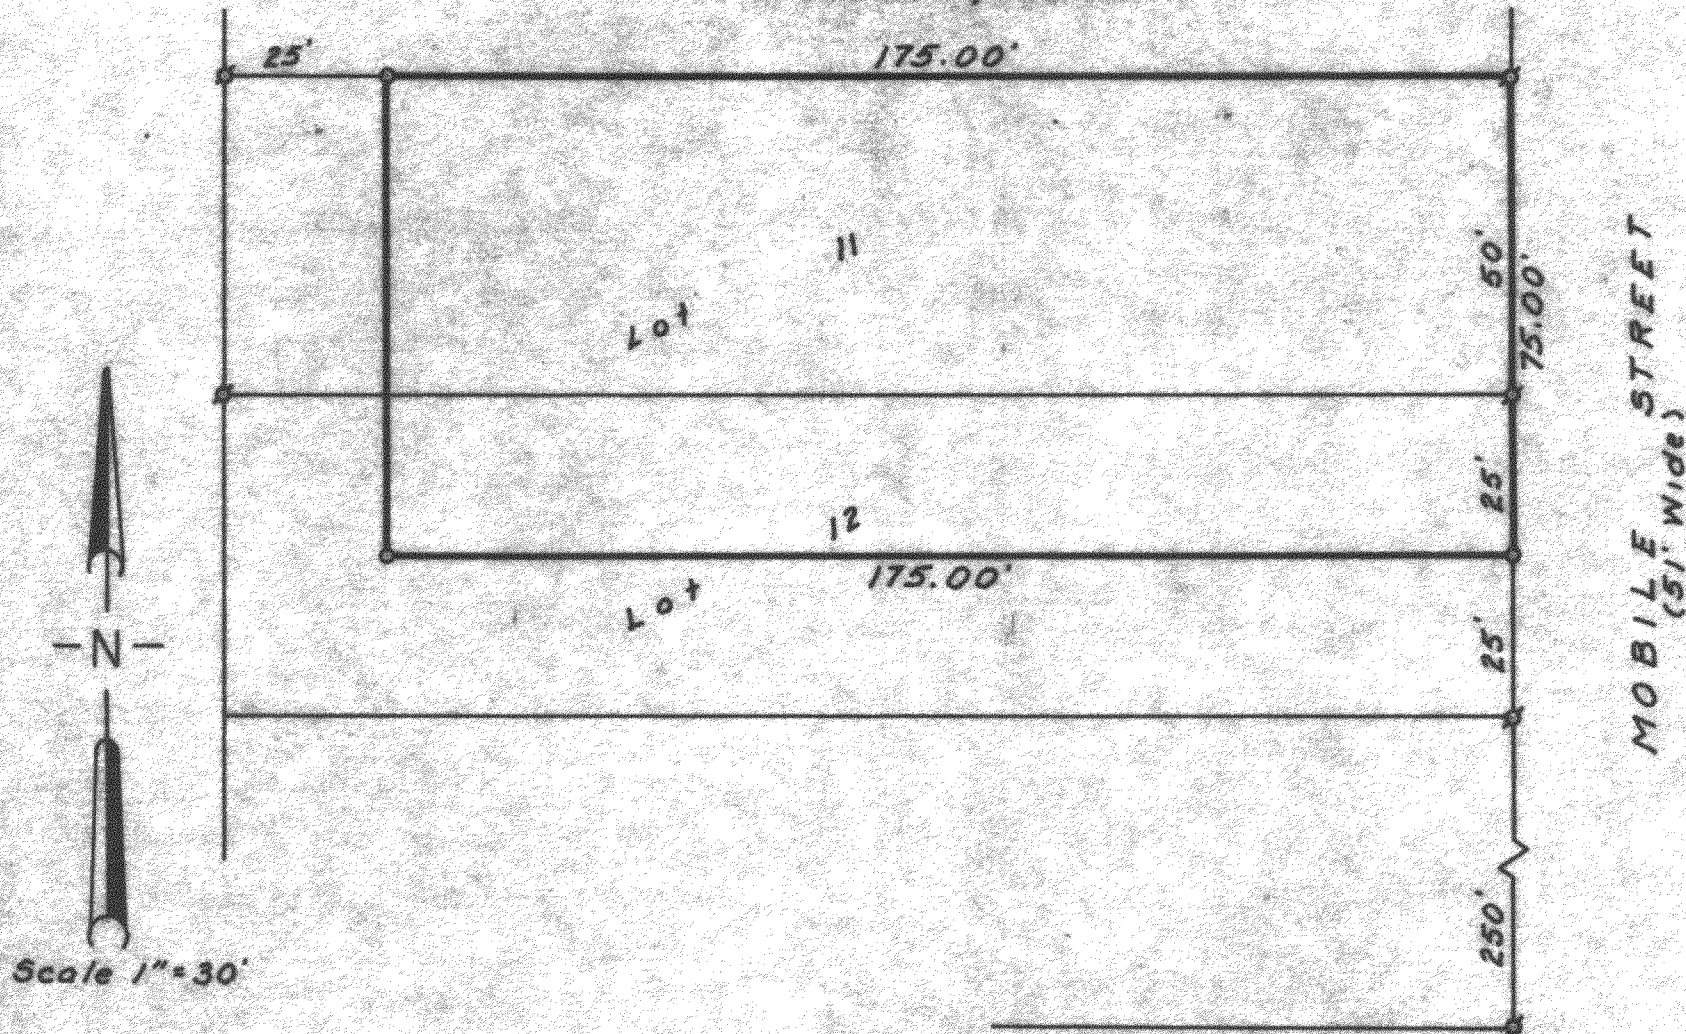

Scale 1"=30'

RUSH STREET
(50' Wide)

PLAT OF SURVEY OF

The East 175 feet of Lot 11 and the East 175 feet of the
North 1/2 of Lot 12, Boulevard Subdivision, City of Lake Geneva,
Walworth County, Wisconsin

Harold H. Kolb

Harold H. Kolb, Wisconsin Surveyor, S-187

o - Iron Pipe Found
o - Iron Pipe Placed

8-29-62

7-134

66-73

BL-13