


KOLB LAND CONSULTING, INC.
LAND SURVEYING • SUBDIVIDING • LAND PLANNING

WHITEWATER, WISCONSIN 53190

LAURIE STREET - 50' WIDE

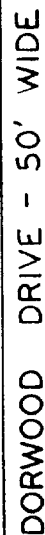

BONNIE BRAE LANE - 50' WIDE

NOTE: SURVEY NOT VALID UNLESS
SURVEYOR'S SIGNATURE IS IN RED.

PLAT OF SURVEY OF

LOT 89 AND THE NORTH 1/2 OF LOT 90, H. E. WELLS ADDITION TO THE CITY OF LAKE GENEVA, WALWORTH COUNTY, WISCONSIN.

ORDERED BY: REDELL REALTY
6-29-90 ROUTE 5, BOX 1074
LAKE GENEVA, WI. 53147

ORDERED BY: CARL L. WOODWARD
750 WELLS STREET
LAKE GENEVA, WI 53147



SCALE: 1"=50'

LEGEND

ø - IRON PIPE FOUND
o - IRON PIPE SET

SW-- SIDE WALK

OVERHEAD UTILITY LINES

I HEREBY CERTIFY THAT I HAVE SURVEYED THE ABOVE DESCRIBED PROPERTY AND THAT THE ABOVE MAP IS A TRUE REPRESENTATION THEREOF AND SHOWS THE SIZE AND LOCATION OF THE PROPERTY, ITS EXTERIOR BOUNDARIES, THE LOCATION OF ALL VISIBLE STRUCTURES AND DIMENSIONS OF ALL PRINCIPAL BUILDINGS THEREON, BOUNDARY FENCES, APPARENT EASEMENTS, ROADWAYS AND VISIBLE ENCROACHMENTS, IF ANY.

THIS SURVEY IS MADE FOR THE USE OF THE PRESENT OWNERS OF THE PROPERTY, AND ALSO THOSE WHO PURCHASE, MORTGAGE, OR GUARANTEE THE TITLE THERETO WITHIN ONE (1) YEAR FROM DATE HEREOF.

Harold H. Roll

HAROLD H. ROED
WISCONSIN REGISTERED LAND SURVEYOR, S-187

DATE Nov. 19, 1979

REvised JUNE 29, 1990

007-1352

ZWE-89 LG-112