

KOLB LAND CONSULTING, INC.
LAND SURVEYING • SUBDIVIDING • LAND PLANNING

929 WILLIAMS STREET



LAKE GENEVA, WISCONSIN 53147

414-248-3697

PLAT OF SURVEY OF

THE EAST 118.00 FEET OF THE SOUTH
118.00 FEET OF LOTS 1 AND 2, BLOCK 2,
WHEELERS ADDITION, CITY OF LAKE
GENEVA, WALWORTH COUNTY, WISCONSIN.

OWNERS: MARK J. & KAREN I. HINCE
1212 HORACE STREET
LAKE GENEVA, WI 53147

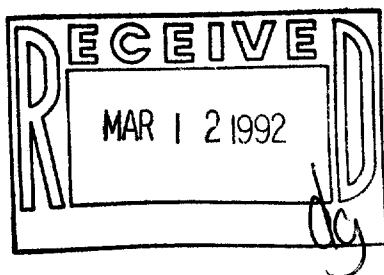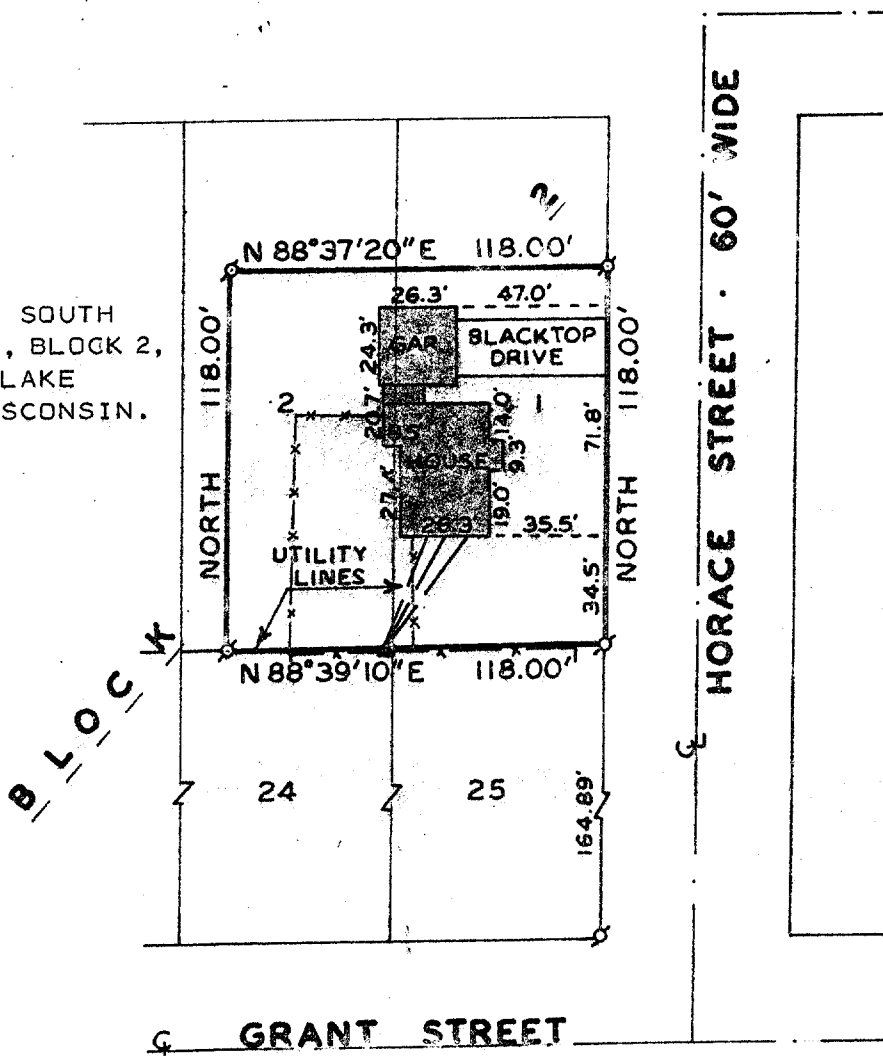

SCALE : 1" = 60'

LEGEND

- Ø - IRON PIPE FOUND
- - IRON PIPE SET
- Δ - UTILITY POLE
- x- - FENCE

I HEREBY CERTIFY THAT I HAVE SURVEYED THE
ABOVE DESCRIBED PROPERTY AND THAT THE ABOVE
MAP IS A TRUE REPRESENTATION THEREOF AND
SHOWS THE SIZE AND LOCATION OF THE PROPERTY,
ITS EXTERIOR BOUNDARIES, THE LOCATION OF ALL
VISIBLE STRUCTURES AND DIMENSIONS OF ALL
PRINCIPAL BUILDINGS THEREON, BOUNDARY FENCES,
APPARENT EASEMENTS, ROADWAYS AND VISIBLE
ENCROACHMENTS, IF ANY, TO THE BEST OF MY
KNOWLEDGE AND BELIEF.

THIS SURVEY IS MADE FOR THE USE OF THE
PRESENT OWNERS OF THE PROPERTY, AND ALSO
THOSE WHO PURCHASE, MORTGAGE, OR GUARANTEE
THE TITLE THERETO WITHIN ONE (1) YEAR FROM
DATE HEREOF. SURVEY NOT VALID UNLESS
SURVEYOR'S SIGNATURE IS IN RED.

HAROLD H. KOLB

WISCONSIN REGISTERED LAND SURVEYOR, S-187

DATE OCTOBER 26, 1988

REVISED FEBRUARY 25, 1991

REVISED _____

007-1358

LG 533 ZWH-6A