


CASS STREET

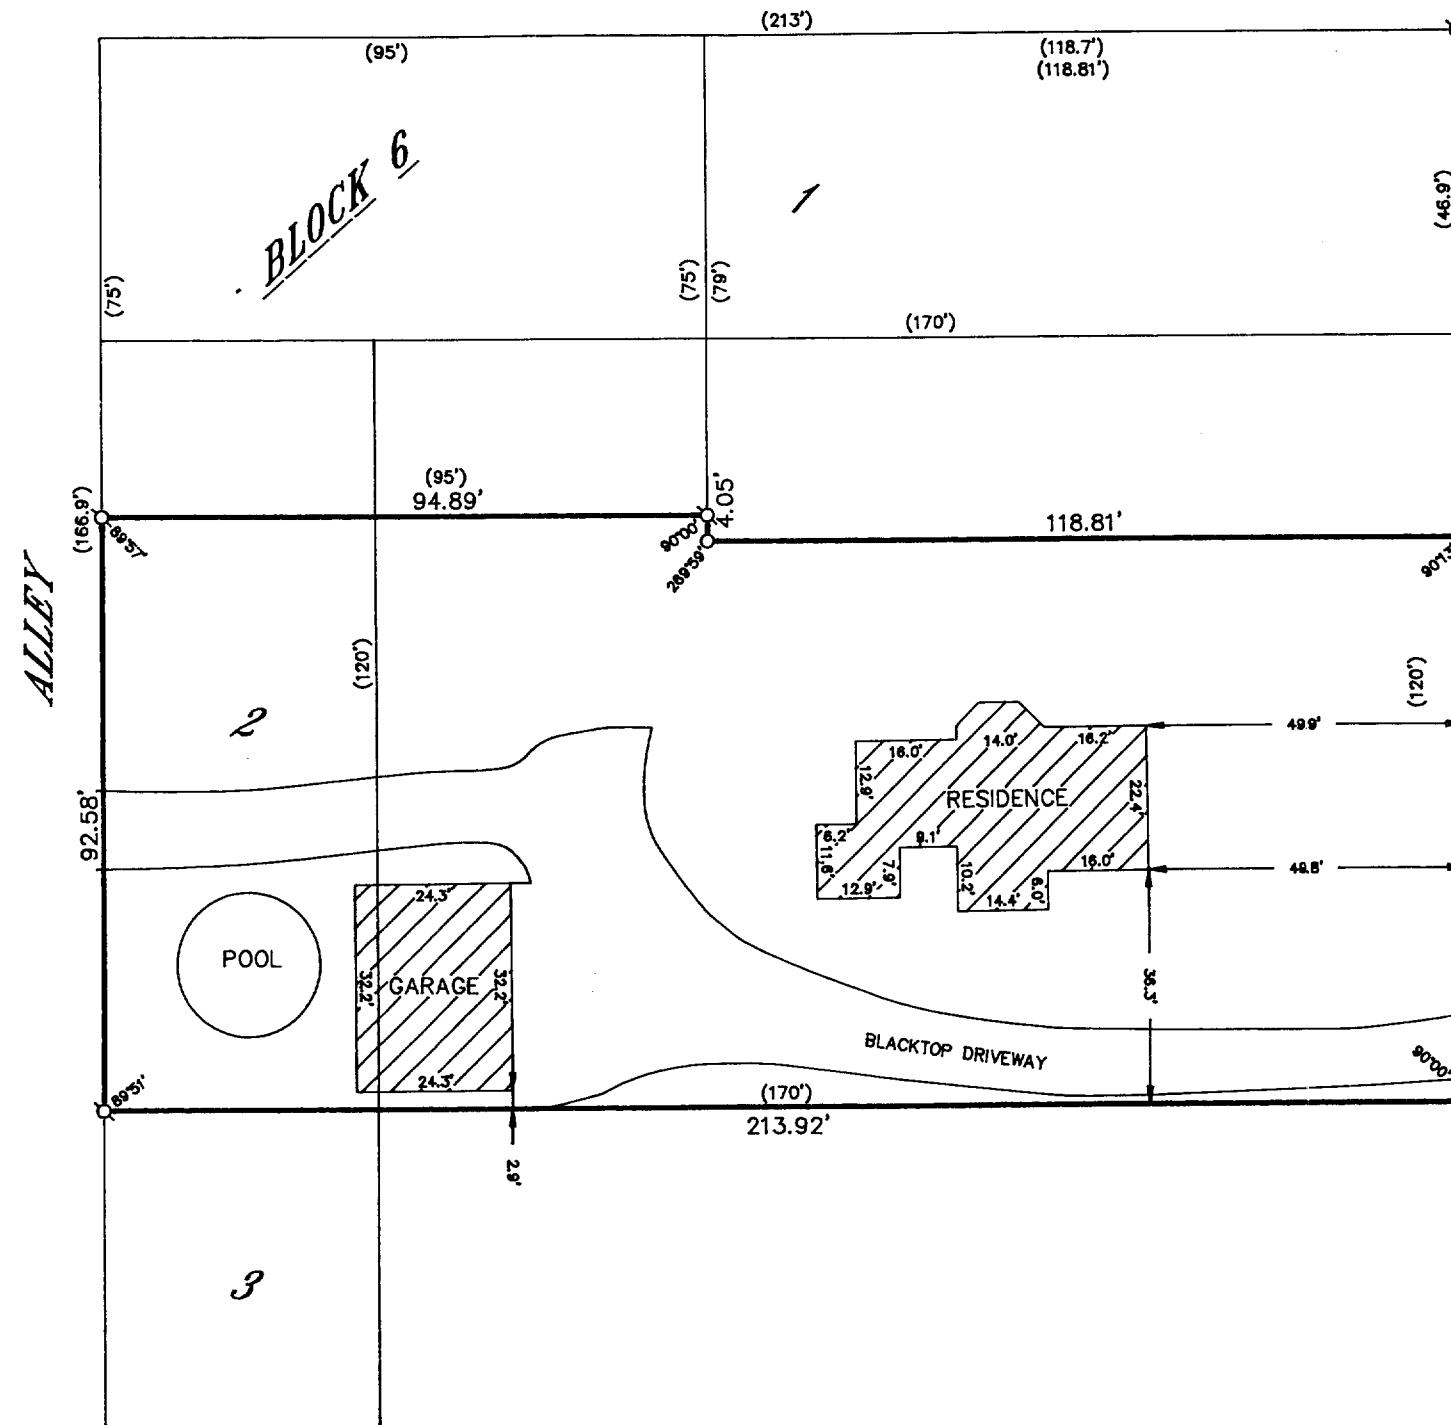


corner thereof, in the West line of Curtis Street (Ave.); thence North in the West line of said Street 240 feet, to point of commencement; thence North in the West line of said Curtis Street 120 feet; thence West at right angles 170 feet; thence South parallel to the first line 120 feet to the North line of lands conveyed by Nettie Phillips to Geo. A. Button; thence East in the said Geo. A. Button's North line 170 feet to the place of commencement.

Excepting from said Parcels 1 and 2 the following parcels of land:

Tract A: That part of lots 1 and 2, block 6, Phillips & Purvis Subdivision to the City of Lake Geneva, and part of large lot 4 in said city described as follows: Beginning at the N. E. corner of block 6 of Phillips & Purvis Subdivision, thence W. along the S. line of Cass Street, 118.70 feet to the place of beginning; thence continue W. along the S. line of Cass Street, 95 feet more or less to the E. line of an alley; thence S'ly along the E. line of the alley 75 feet; thence E. 95 feet more or less to a point directly S. of the place of beginning; thence N. 75 feet to the place of beginning.

Tract B: A parcel of land located in Phillips and Purvis Subdivision and also the original plat of the City of Lake Geneva, Walworth County, Wisconsin and described as follows: Beginning at the Northeast corner of Lot 1, Block 6 of said Phillips and Purvis Subdivision, thence Southerly along the Westerly line of Curtis Street 79.00 feet; thence Westerly parallel with the Southerly line of Cass Street 118.81 feet; thence Northerly 79.00 feet to the Southerly line of Cass Street; thence Easterly along said Southerly line 118.81 feet to the place of beginning.

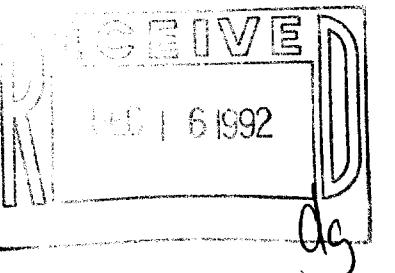

Robert M. Baerenwald
ROBERT M. BAERENWALD
WISCONSIN REGISTERED LAND SURVEYOR, S-1508
NOV. 18, 1992
DATE JOB NO. 3651
NOTE: THIS IS NOT A CERTIFIED COPY UNLESS SEALED.