


DESCRIPTION: Commencing at an iron stake at the southeast corner of Lot #43 Riches Addition to the Village of Geneva (now City of Lake Geneva), Walworth County, Wisconsin; thence North in the west line of Williams Street 180.3 feet to an iron stake, thence West parallel with the north line of Lot #40 of said subdivision, 151.0 feet to an iron stake, thence North along the west lines of Lots #40 and #39 of said subdivision, 100.0 feet to an iron stake in the south line of the alley in said subdivision, thence West along the south line of said alley 258.5 feet to an iron stake in the easterly line of the Chicago and Northwestern Rail Road, R.O.W. thence S. 43° E. along said rail road right of way line 386.0 feet to an iron stake at the southwest corner of said Lot #43, thence East along the south line of said Lot #43, 143.0 feet to the place of beginning.

CERTIFICATE: This is to certify that I have on this the 12th day of December, 1942, surveyed the above described property, according to the official records on file in the office of the Recorder of Deeds in and for Walworth County, Wisconsin, and the plat hereon portrayed is a correct and true representation of the lot lines, boundaries, and principal measurements of said property, and that there are no existing encroachments at the present time.

Signed this 16th day of December 1942.

Joseph W. Biagi
Elkhorn Wisconsin.

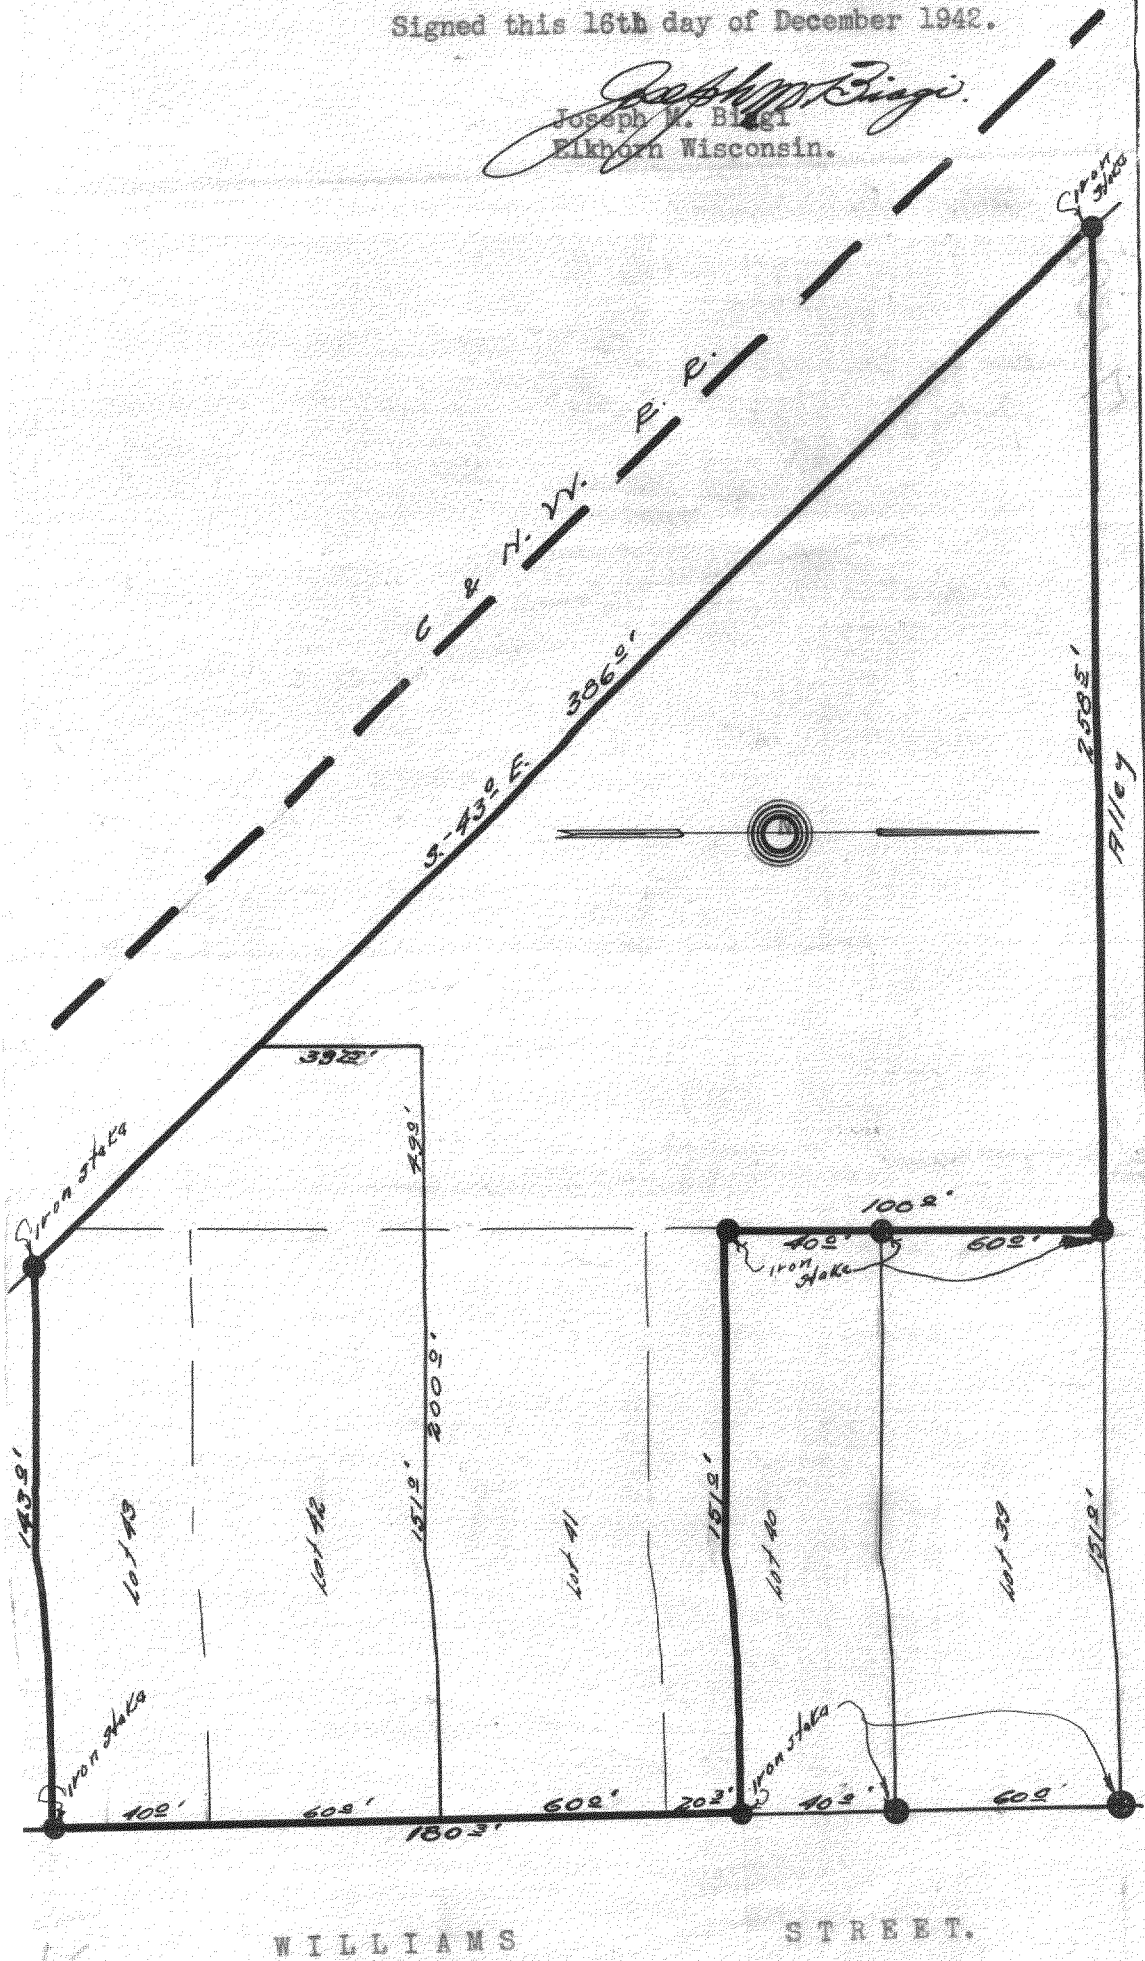

WILLIAMS

STREET.

200-113-70-370-371-372

RA-35

7-139B