


HAROLD H. KOLB
REGISTERED PROFESSIONAL LAND SURVEYOR
LAKE GENEVA, WISCONSIN

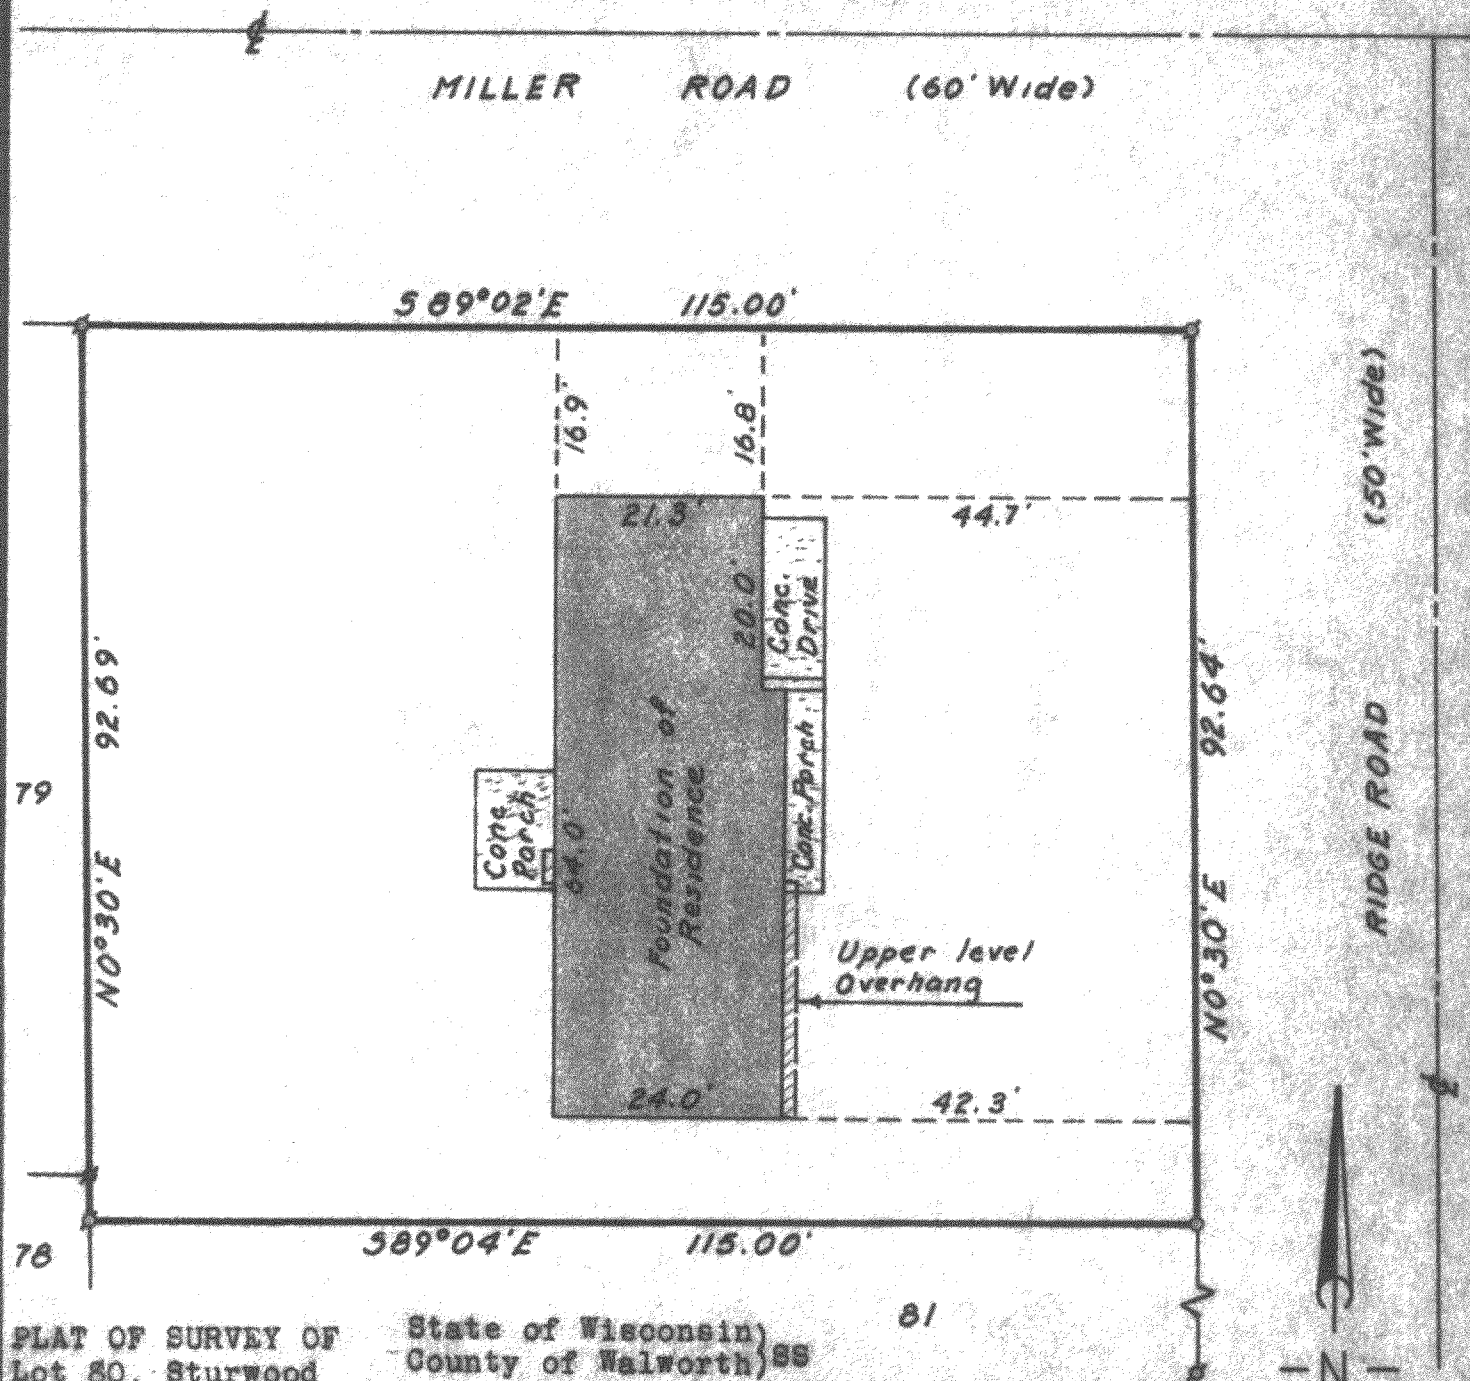

PLAT OF SURVEY OF
Lot 80, Sturwood
Addition No. 3 to
the City of Lake
Geneva, Walworth
County, Wisconsin

State of Wisconsin)
County of Walworth) SS

I, Harold H. Kolb do hereby certify
that I have surveyed the property hereon
described according to the official records,
and that the plat hereon is a correct
representation of the lot lines and the
principal lines of the buildings thereon.

Date Feb. 15, 1963

Harold H. Kolb

Harold H. Kolb, S-187
Wisconsin Surveyor

Scale 1"=20'

8 - Iron Pipe Found
o - Iron Pipe Placed

ST3-16

7-141