


KOLB LAND CONSULTING, INC.
LAND SURVEYING • SUBDIVIDING • LAND PLANNING

929 WILLIAMS STREET LAKE GENEVA, WISCONSIN 53147 414-248-3697

OWNER:
CHERYL L. SPRUCE
1114 PARK ROW
LAKE GENEVA WI 53147


ORDERED BY: ALLEN FRIEDMAN
P.O. BOX 883
DELAVER, WI 53115-0883

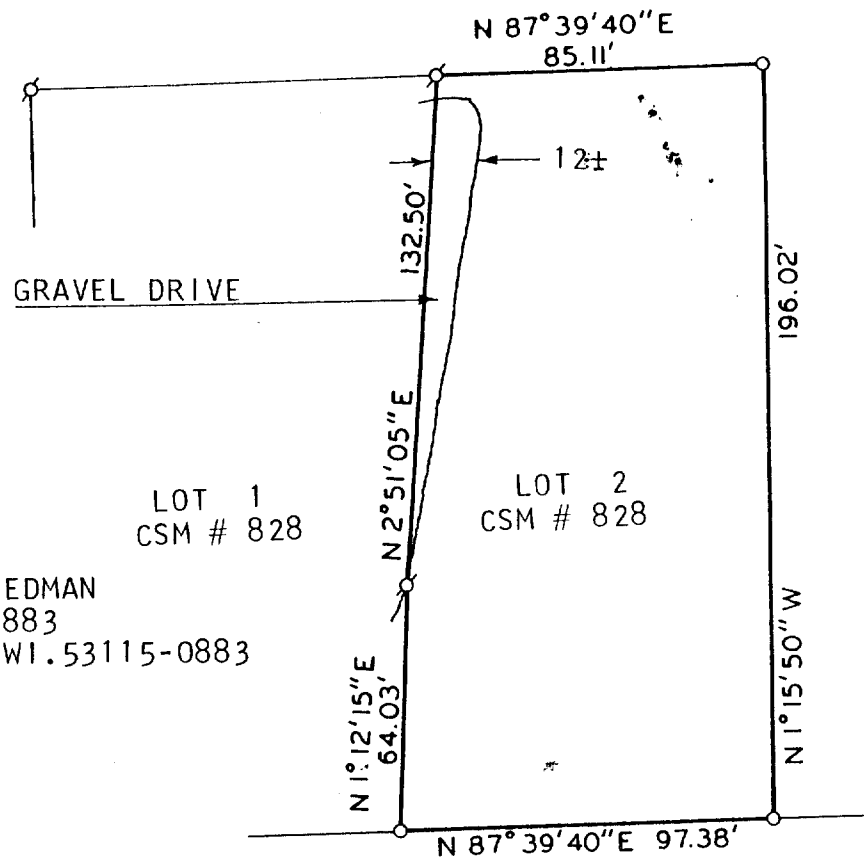

NOTE: BEARINGS ARE ASSUMED AS SHOWN
ON RECORDED CERTIFIED SURVEY
MAP 828.

PLAT OF SURVEY OF

LOT 2 OF CERTIFIED SURVEY MAP NO. 828,
LOCATED IN THE NORTHWEST 1/4 OF SECTION
6, T1N, R18E, CITY OF LAKE GENEVA, WAL-
WORTH COUNTY, WISCONSIN.

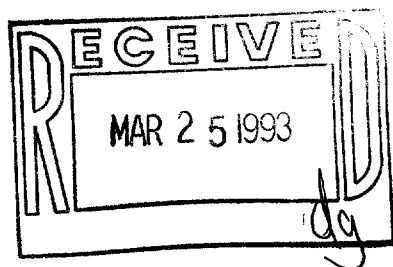

SCALE: 1" = 50'
LEGEND

ø - IRON PIPE FOUND
o - IRON PIPE SET

I HEREBY CERTIFY THAT I HAVE SURVEYED THE
ABOVE DESCRIBED PROPERTY AND THAT THE ABOVE
MAP IS A TRUE REPRESENTATION THEREOF AND
SHOWS THE SIZE AND LOCATION OF THE PROPERTY,
ITS EXTERIOR BOUNDARIES, THE LOCATION OF ALL
VISIBLE STRUCTURES AND DIMENSIONS OF ALL
PRINCIPAL BUILDINGS THEREON, BOUNDARY FENCES,
APPARENT EASEMENTS, ROADWAYS AND VISIBLE
ENCROACHMENTS, IF ANY, TO THE BEST OF MY
KNOWLEDGE AND BELIEF.

THIS SURVEY IS MADE FOR THE USE OF THE
PRESENT OWNERS OF THE PROPERTY, AND ALSO
THOSE WHO PURCHASE, MORTGAGE, OR GUARANTEE
THE TITLE THERETO WITHIN ONE (1) YEAR FROM
DATE HEREOF. THIS SURVEY IS NOT VALID UNLESS
THE SURVEYOR'S SIGNATURE IS IN RED.

HAROLD H. KOLB

WISCONSIN REGISTERED LAND SURVEYOR, S-187

DATE _____

REVISED _____

REVISED _____

ZA-828-2

607-1412