


HAROLD H. KOLB
REGISTERED PROFESSIONAL LAND SURVEYOR
LAKE GENEVA, WISCONSIN

NOTE: Iron pipe were found, slightly off and buried, at corners A, B and C. New markers were placed at surface. Iron pipe was found at corner D, one foot East of corner. New iron pipe was set at true corner, in the tree stump.

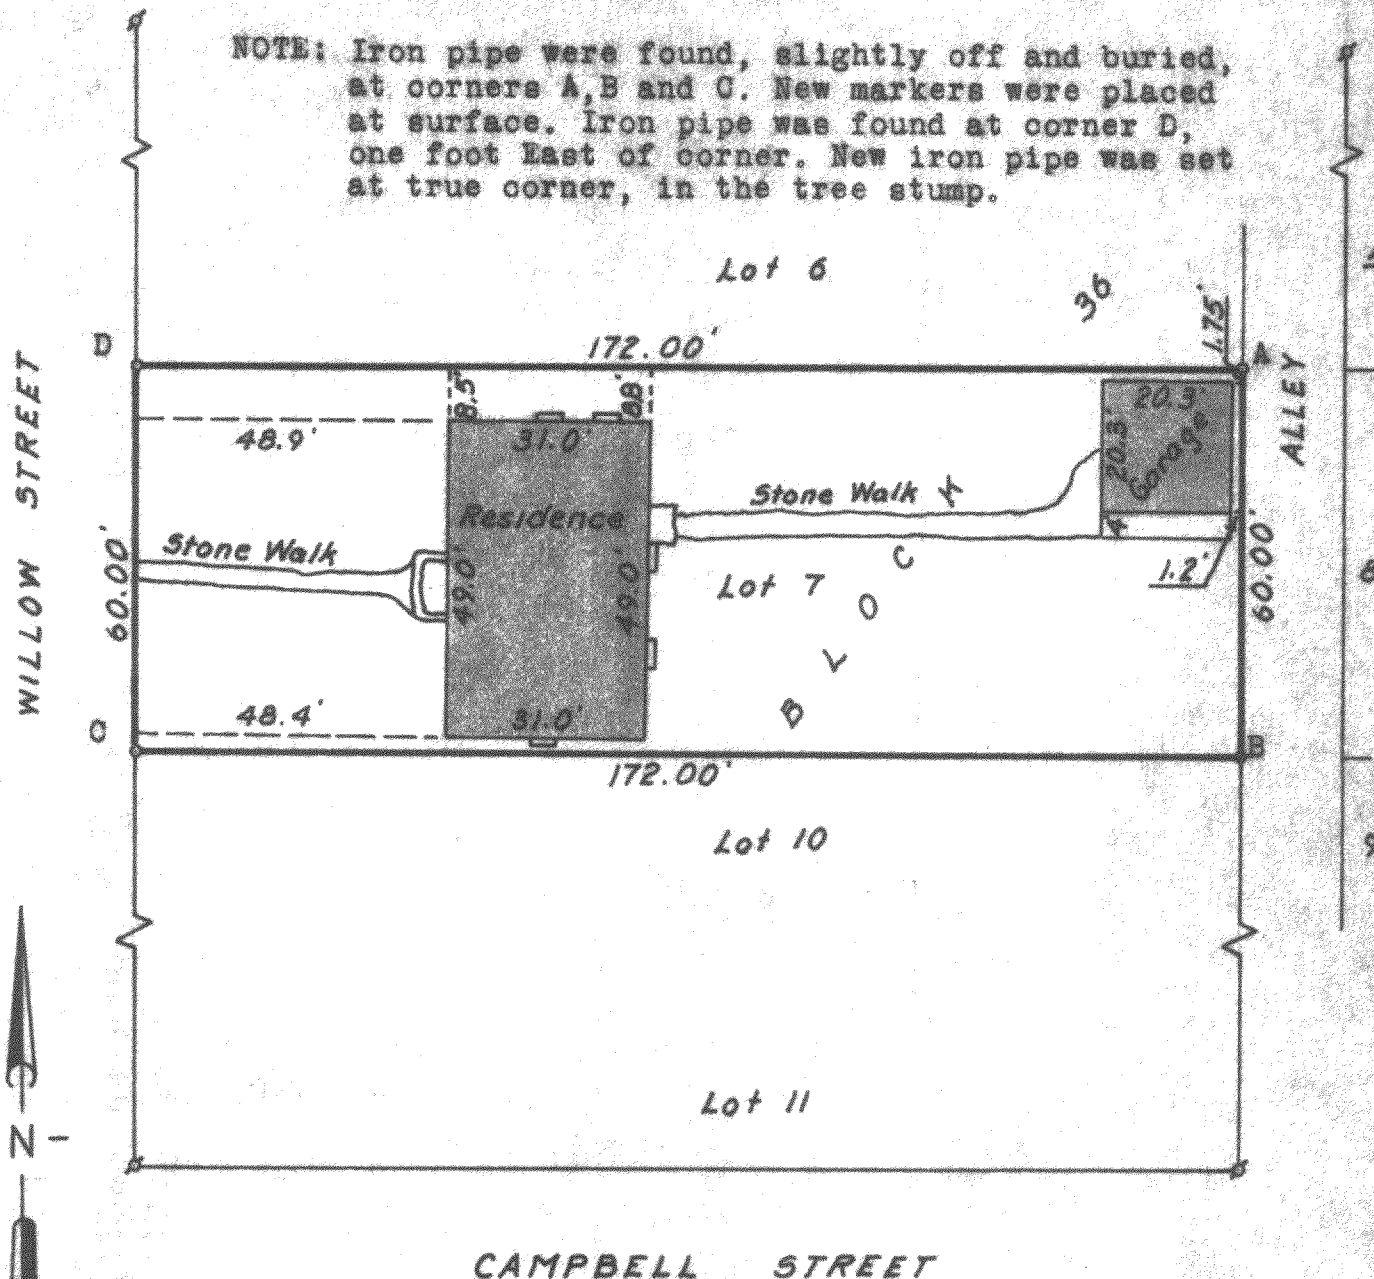

CAMPBELL STREET

PLAT OF SURVEY OF

Lot 7, Block 36, of the Original Plat of the Village (Now City) of Lake Geneva, Walworth County, Wisconsin.

State of Wisconsin)
County of Walworth)SS

I, Harold H. Kolb, do hereby certify that I have Surveyed the property hereon described according to the official records, and that the plat hereon is a correct representation of the lot lines and the principal lines of the buildings thereon.

Date February 23, 1963

Harold H. Kolb

Harold H. Kolb
Wisconsin Surveyor, S-187

- - Iron Pipe Found
- o - Iron Pipe Placed
- - RR Spike Placed

7-142