


7th PORTSMOUTH 7-1871

6325 S. KNOX AV., CHICAGO

A piece or parcel of land situate in the East 1/2 of Section 36, Township 2 North, Range 17 East, Lake Geneva, Walworth County, Wisconsin, being all of Block 33 of the original Village of Geneva, together with unplatted land lying adjacent thereto on the North and West, bounded as follows, to wit:

Commencing at the Southeast corner of Block 33 in the Village (now City) of Geneva (now Lake Geneva) in the County of Walworth, Wisconsin, according to the map thereof on record in the Office of the Register of Deeds in said County, being the intersection of the centerline of Cass and Village Streets, running thereon in the center of said Street in said Village (now City) 393 feet to an iron or set iron pin, then east, then at the East line of Lake Geneva Seminary lands, on or near enclosed and occupied; thence north 33 feet to the North line of said street, thence west to the North line of the Lake Geneva Seminary lands 442.6 feet to an iron pin set in the center of the highway extending south from the Southern end of Center Street in said Village (now City); thence northwesterly in the center of said highway 447.1 feet to the center of the W. low Street, as the same was constructed and used on the 12th day of February, A.D. 1884; thence northeasterly along the center of said Race as used on the date aforesaid to a point where the W. low Street crossed the place of land conveyed by R. W. Warren and wife to Allen J. Moore, as deed dated November 10th, A.D. 1875; thence south, along the center of said W. low Street, to the center of the line, so extended 27 feet to the North bank of said Race as constructed on the aforesaid date; thence northeasterly along the North bank of said Race 118 feet, more or less, to the South line of Main Street in said Village (now City); thence north 50 feet to the center of said street; thence east in the center of said street 20.2 feet to a point where the center line of W. low Street, extended northwesterly intersects the center line of Main Street aforesaid; thence southeasterly in the center line of W. low Street, 462.1 feet to an iron pin; thence south, still in the center of W. low Street, 507.5 feet to the place of beginning.

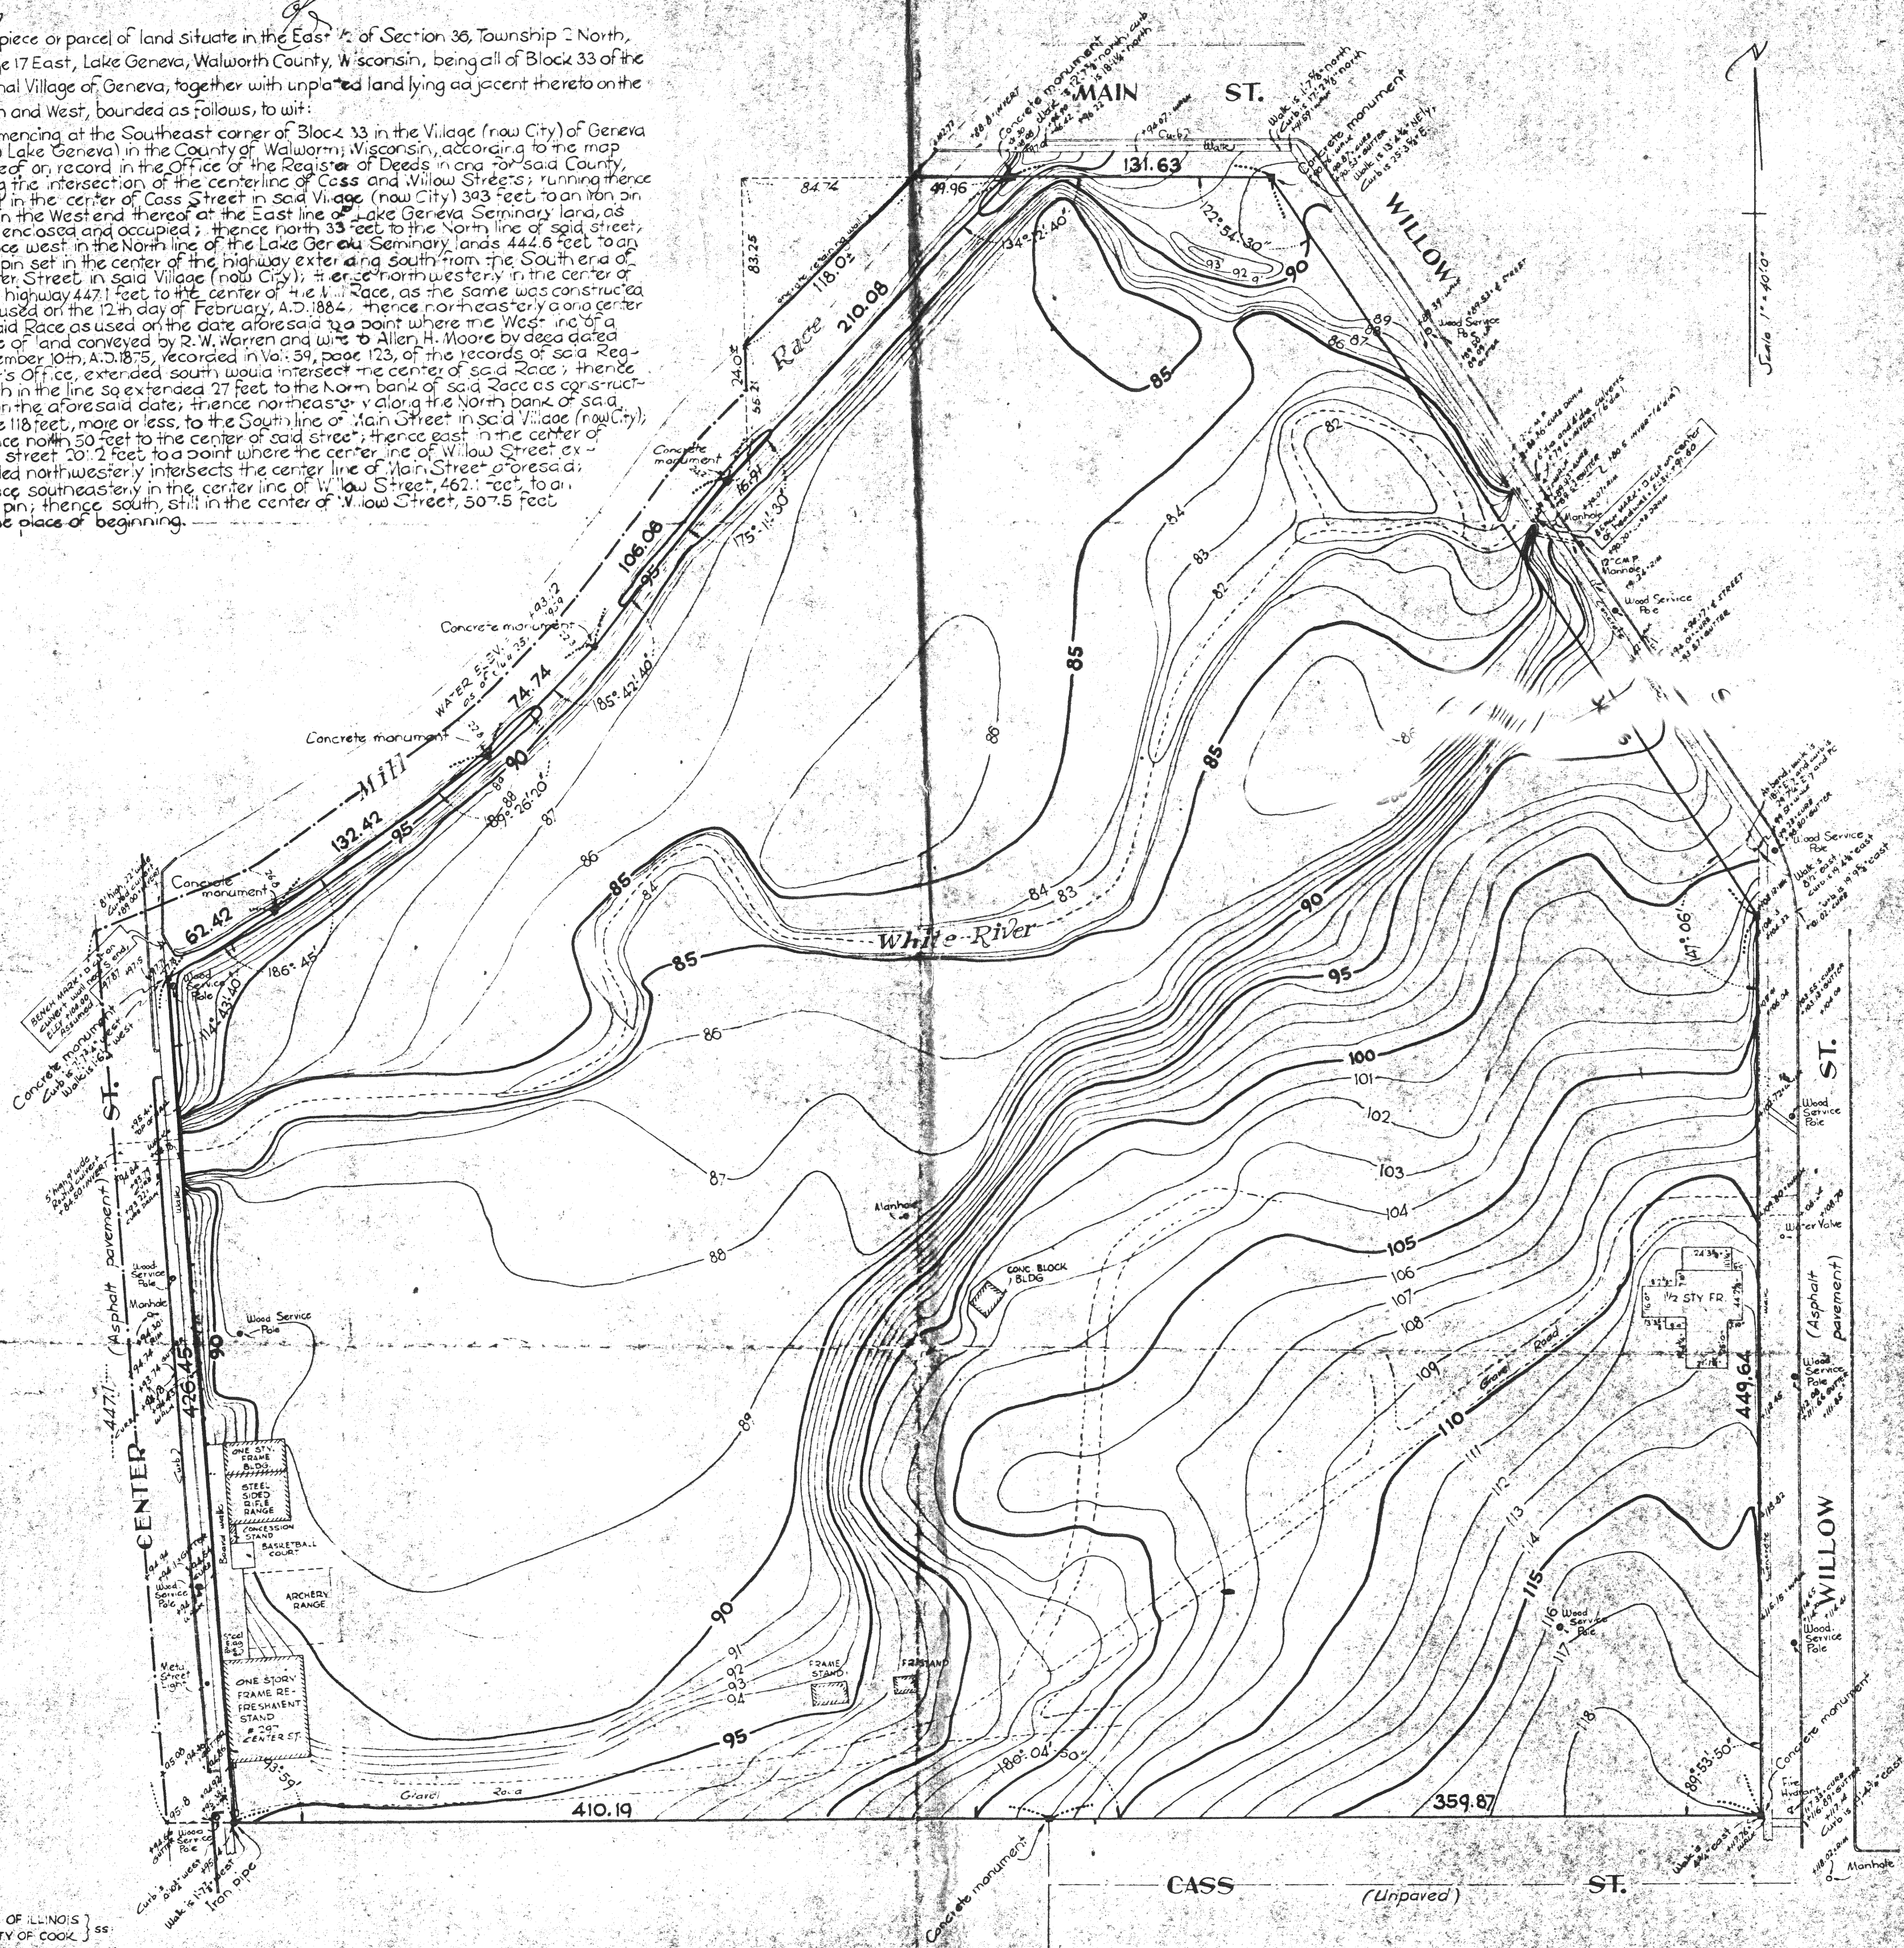

STATE OF ILLINOIS } ss
COUNTY OF COOK }

¹JAMES E. CROTTY, Registered Land Surveyor,
do hereby certify that I have surveyed the above described
property and that the plat hereon drawn is a correct repre-
sentation of said survey.

CHICAGO, ILLINOIS, *July 3rd*, A.D. 1959.

James E. Grotty
Wisconsin Registered Land Surveyor # 5642

Compare all points before building by same and at once report any difference.

ORDER N° 59.200
ZOF - 349

1.066