


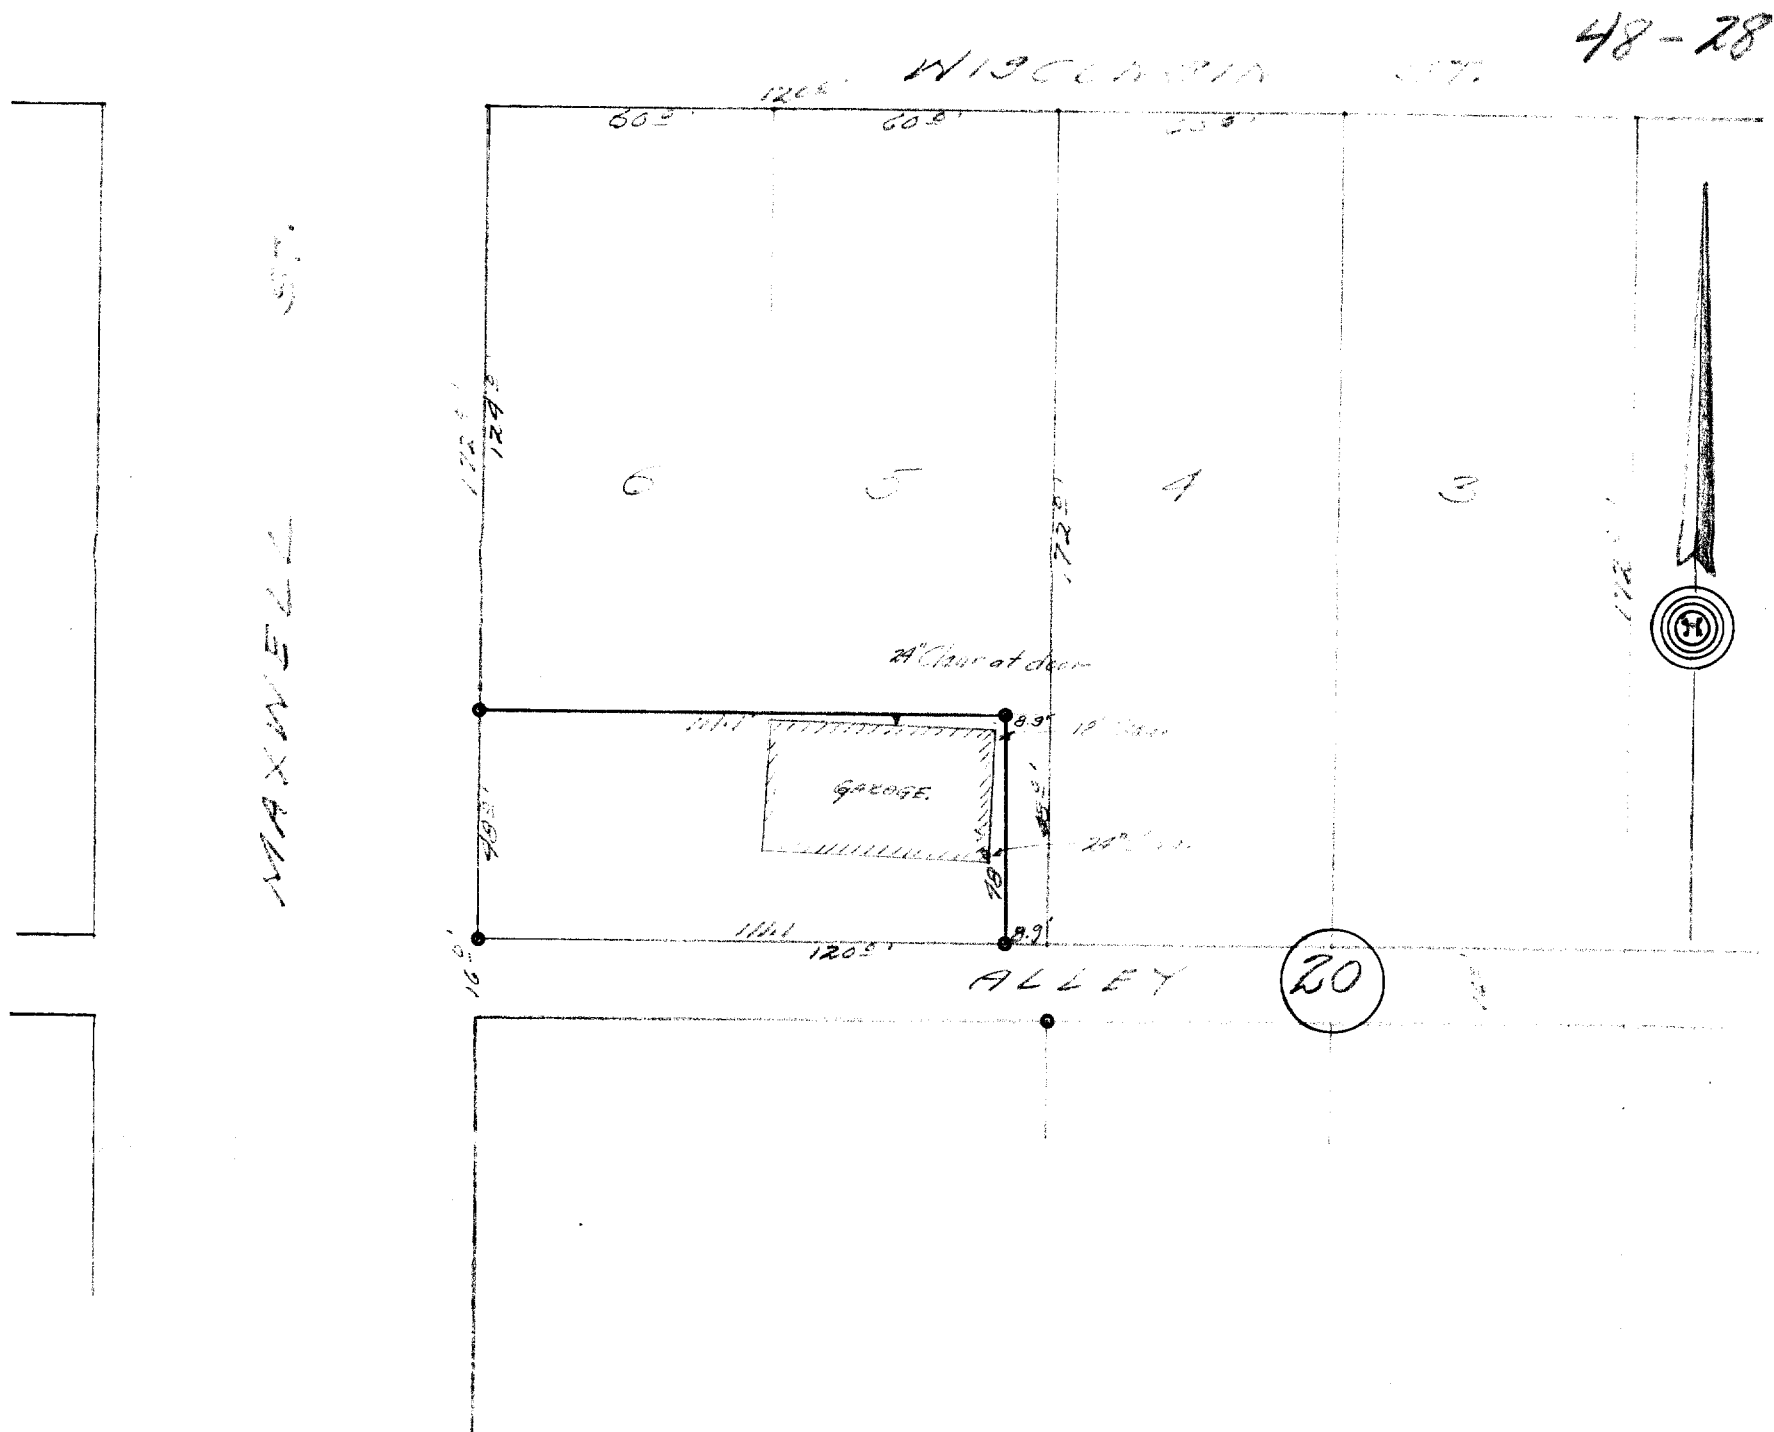


PLAT INTENT:

The South 40.3 feet of Lot 6, Block 20, of the Original Plat of the City of Lake Geneva, Walworth County, Wisconsin, and the South 40.3 feet to the West 31.1 feet of Lot 6, Block 20, Original Plat of the City of Lake Geneva, Walworth County, Wisconsin. Also right of way, in place and across the South 40.3 feet of the Lot 6.3 feet of the above is Lot 6 Block 20.

CERTIFICATE: I, hereby certify that I, here on this the 31st day of August 1940, surveyed the above described property according to the official records on file in the Office of the Recorder of Deeds in and for Walworth County, and find that the measurements and bearings of the boundary lines of said property as taken at the site on this day substantially agree with those in the above description and that no encroachments exist.

SIGNED AND SEALED ON THIS THE 1ST DAY OF SEPTEMBER 1940.

Joseph M. Biagi
Joseph M. Biagi, Professional Engineer.
Elkhorn, Wisconsin.

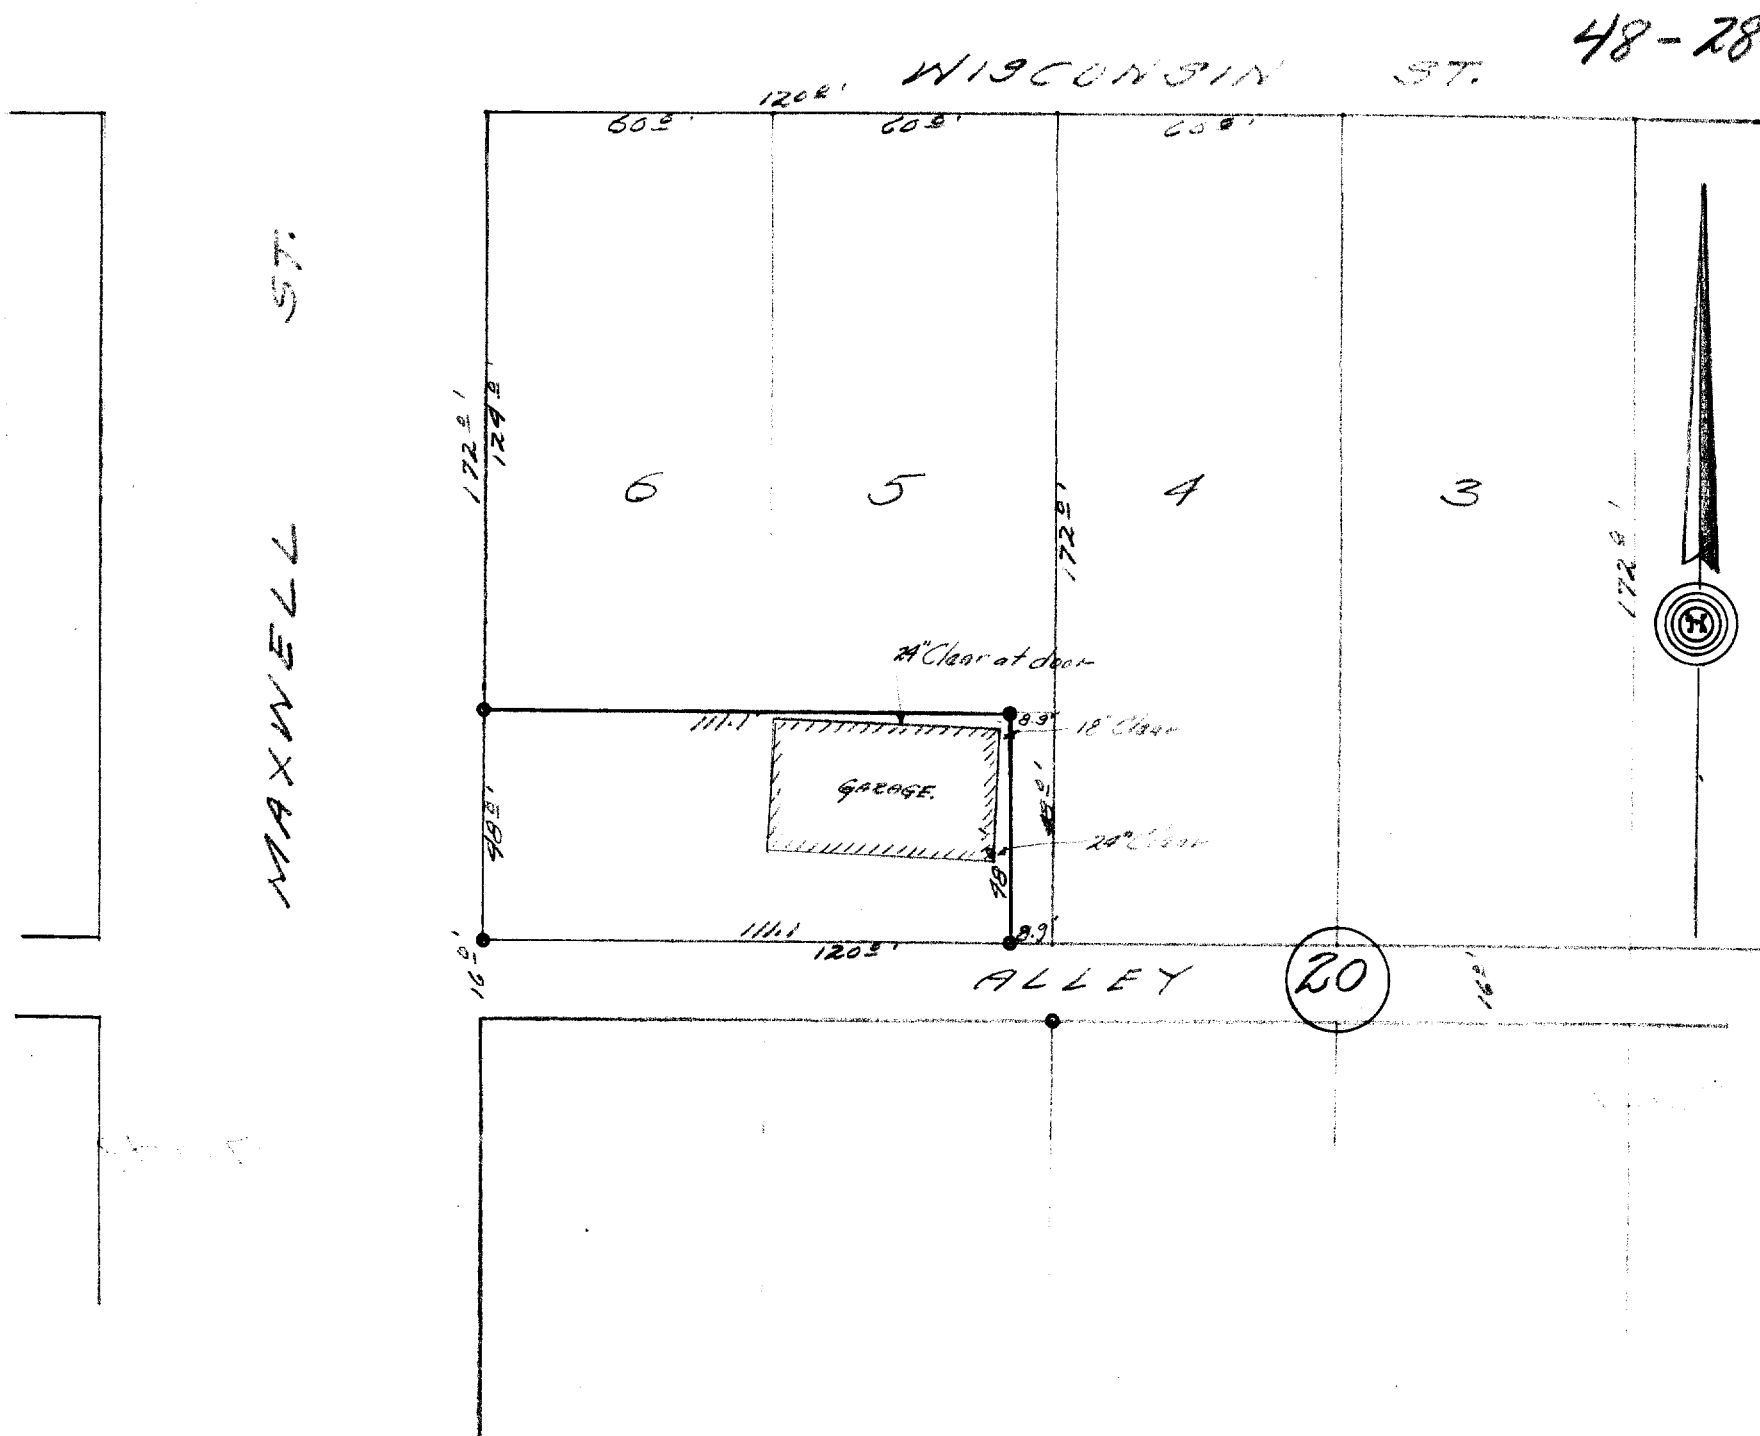

DESCRIPTION:

The South 48.0 feet of Lot 6, Block 20, of the Original Plat of the City of Lake Geneva, Walworth County, Wisconsin, and the South 48.0 feet to the West 51.1 feet of Lot 5, Block 20, Original Plat of the City of Lake Geneva, Walworth County, Wisconsin. Also a right of way, in along and across the South 48.0 feet of the East 8.9 feet of the aforesaid Lot 5 Block 20.

CERTIFICATE: I, hereby certify that I, have on this the 31st day of August 1948, surveyed the above described property according to the official records on file in the office of the Recorder of Deeds in and for Walworth County, and find that the measurements and bearings of the boundary lines of said property as taken at the site on this day substantially agree with those in the above description and that no encroachments exist.

SIGNED AND SEALED ON THIS THE 1ST DAY OF SEPTEMBER 1948.

Joseph M. Biagi. Professional Engineer.
Elkhorn Wisconsin.