

PLAT OF SURVEY OF


Harold H. Kolb
Harold H. Kolb
Wisconsin Surveyor, 8-187

Harold K. Kolb

Harold E. Kolb
Wisconsin Surveyor, 8-187

-N-

Scale 1" = 20'

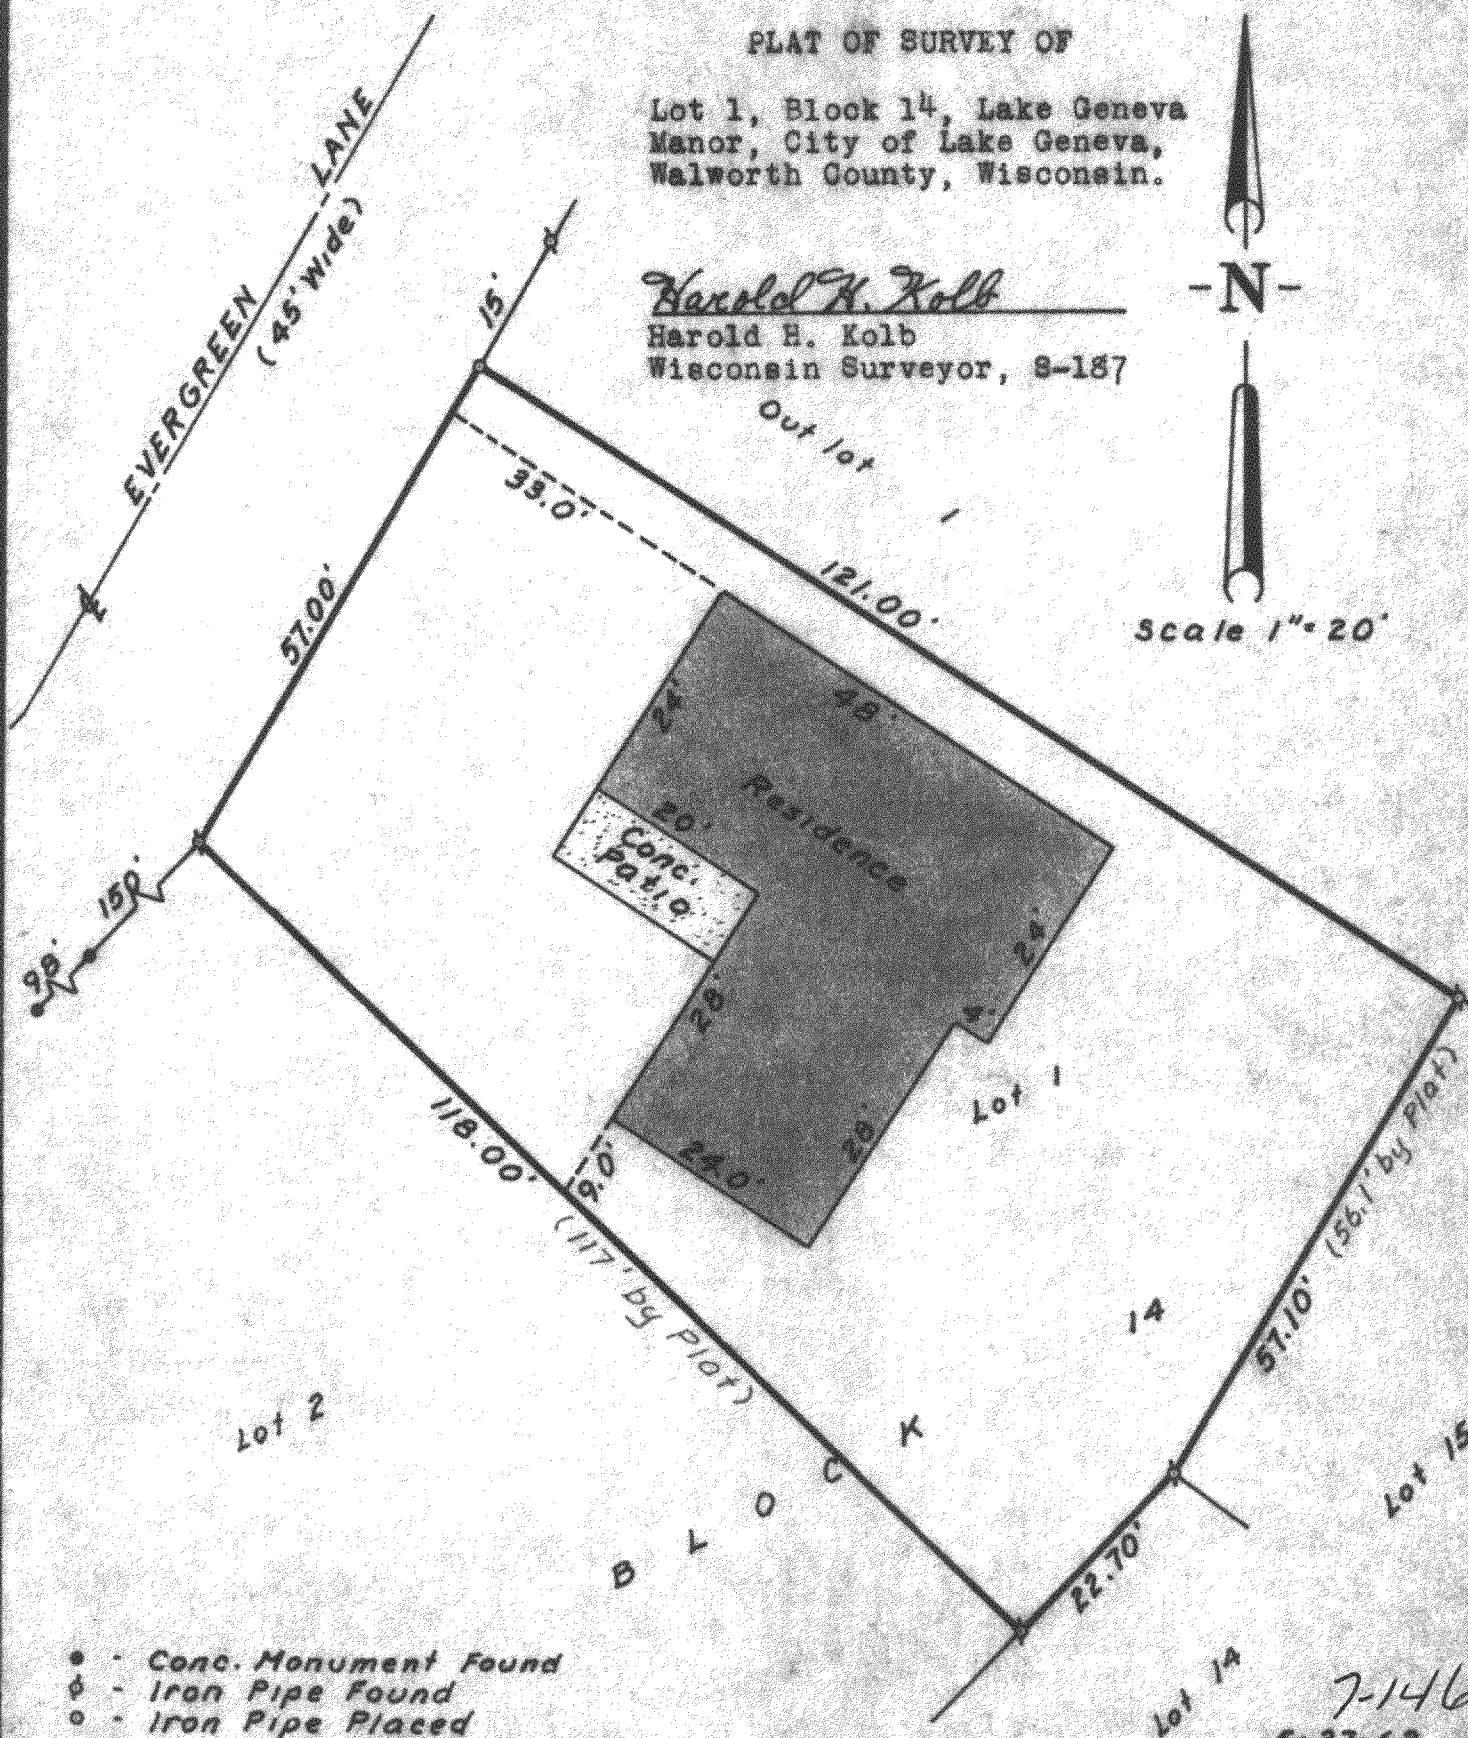

5-27-63

0025

ZLM-13