


KOLB LAND CONSULTING, INC.
929 WILLIAMS STREET LAKE GENEVA, WI. 53147 248-3697


ORDERED BY: LAKE GENEVA MANOR BOAT &
PIER COMMITTEE %
DUNCAN FLEMING
45 LAKEVIEW DR.
LAKE GENEVA, WI. 53147

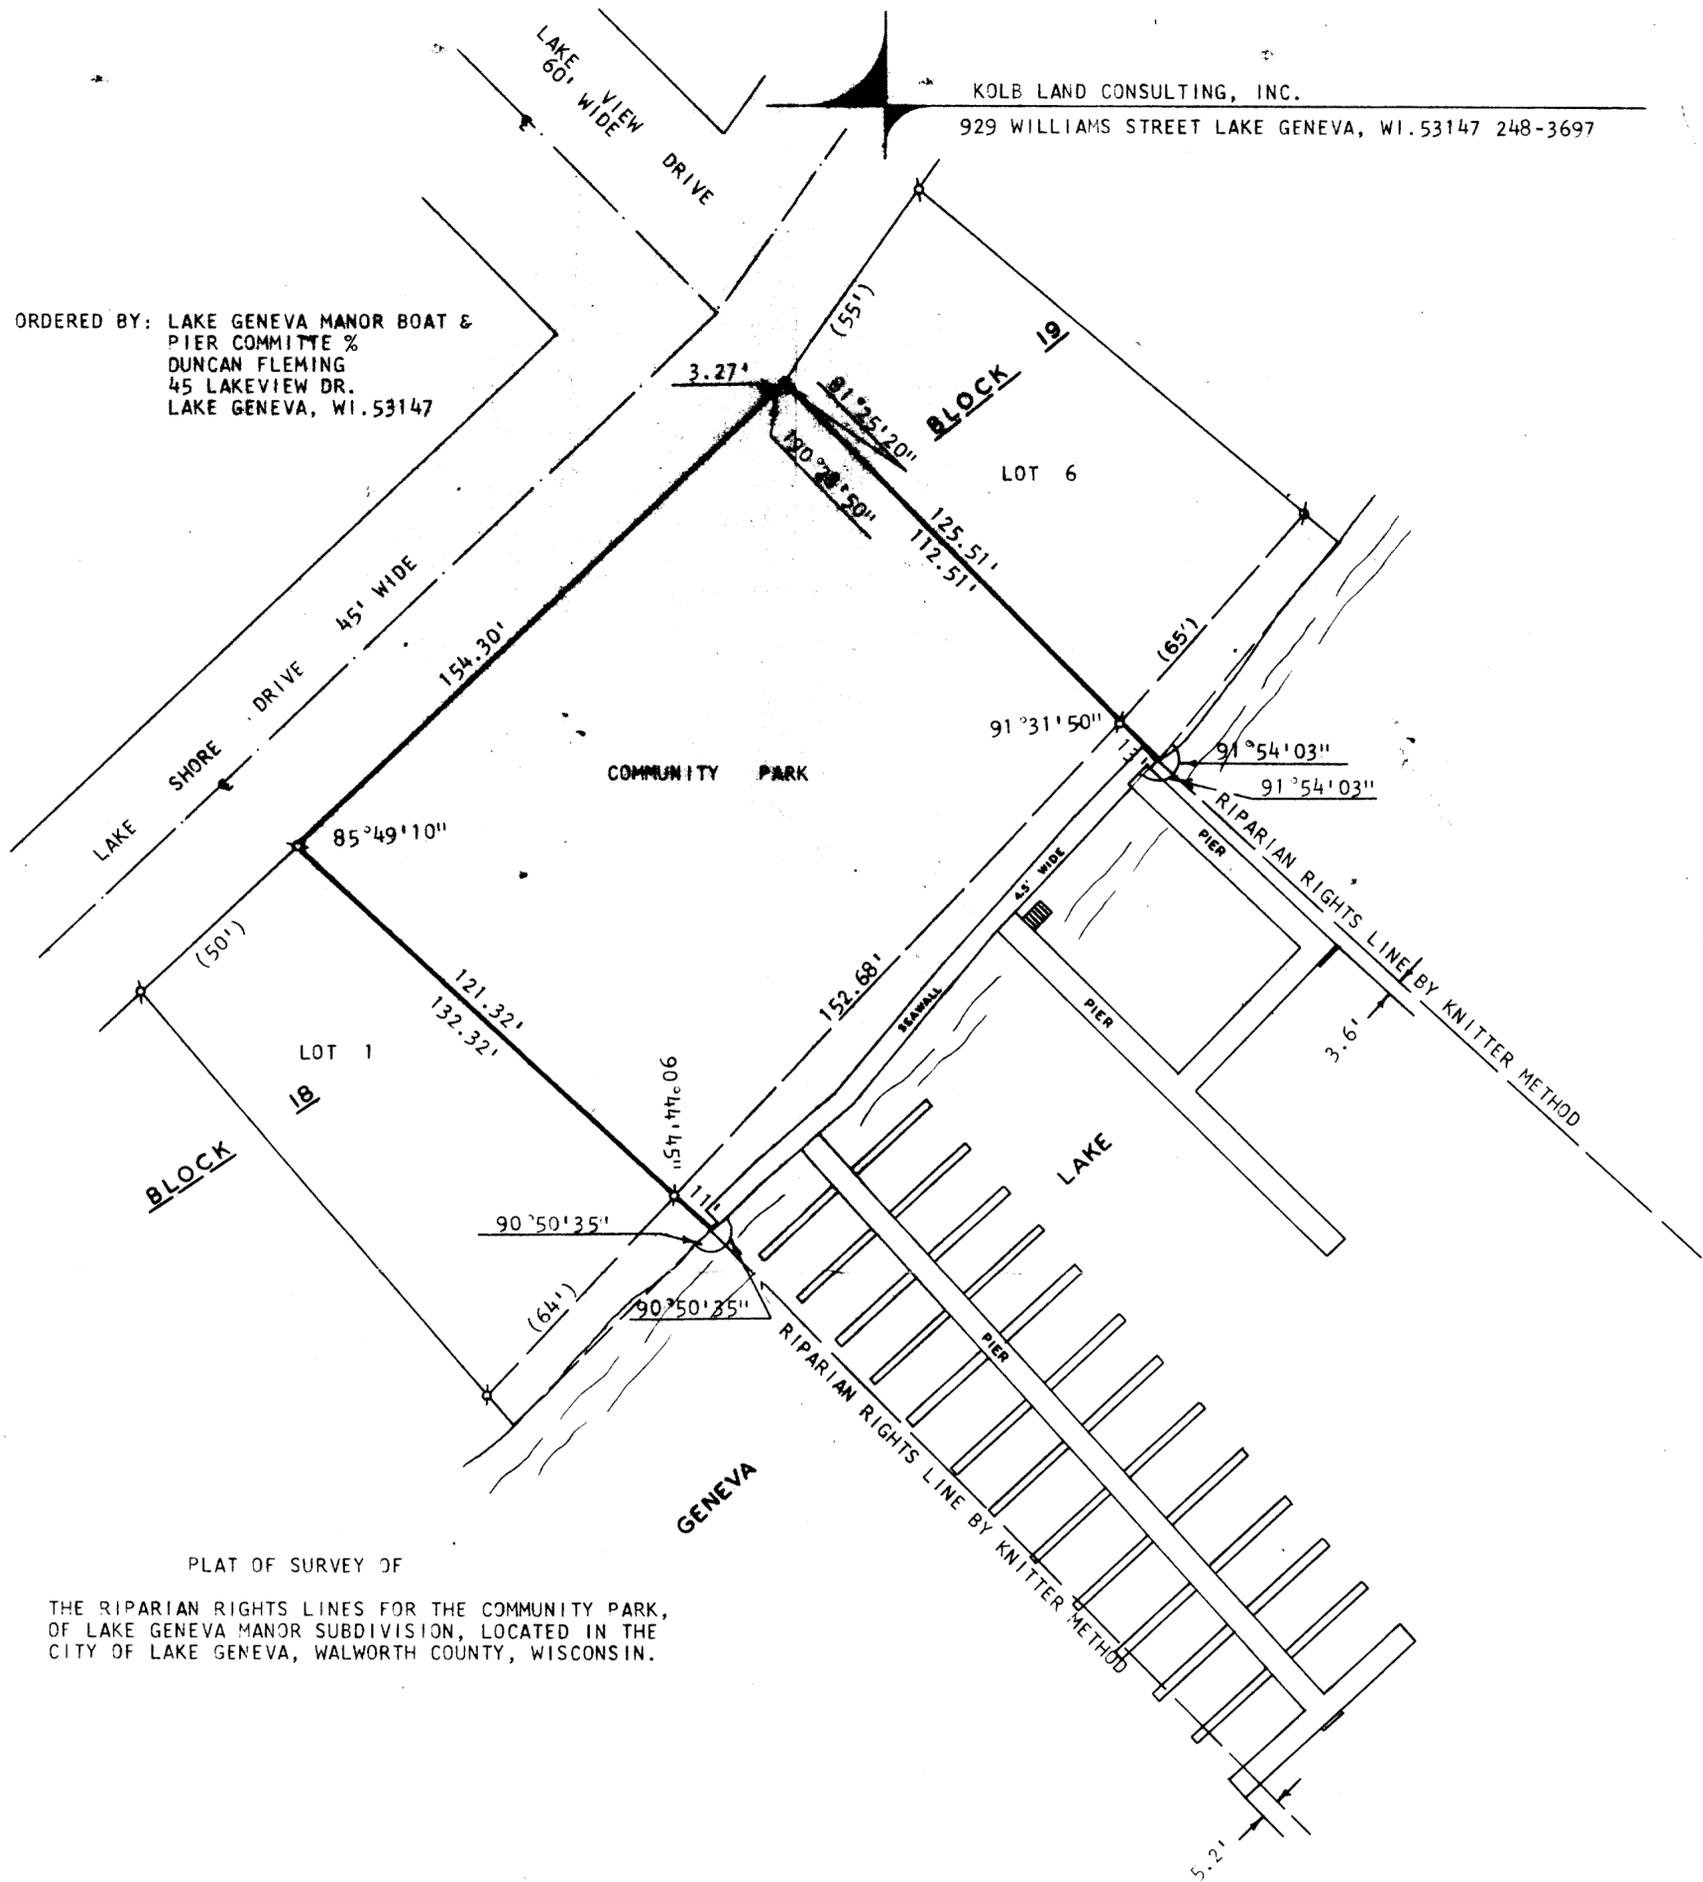

PLAT OF SURVEY OF
THE RIPARIAN RIGHTS LINES FOR THE COMMUNITY PARK,
OF LAKE GENEVA MANOR SUBDIVISION, LOCATED IN THE
CITY OF LAKE GENEVA, WALWORTH COUNTY, WISCONSIN.



SCALE: 1" = 30'
LEGEND
♂ - IRON PIPE FOUND
() - AS RECORDED
○ - IRON PIPE SET

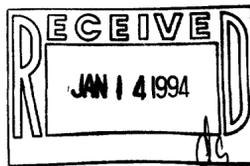

I, HAROLD H. KOLB, DO HEREBY CERTIFY
THAT I HAVE SURVEYED THE PROPERTY
HEREON DESCRIBED ACCORDING TO THE
OFFICIAL RECORDS AND THAT THE PLAT
HEREON IS A CORRECT REPRESENTATION
OF THE LOT LINES TO THE BEST OF MY
KNOWLEDGE AND BELIEF.
SURVEY NOT VALID UNLESS SURVEYOR'S
SIGNATURE IS IN RED.

HAROLD H. KOLB
WISCONSIN REGISTERED LAND SURVEYOR, S-187
DATE: NOVEMBER 15, 1993

LG-202

LG-202

ZLM-87

7-1461