


Wisconsin Registered Land Surveyor S-1594

Rt. 3, Box 273
Elkhorn, Wisconsin 53121
Phone: (414) 723-4260 (office)
(414) 723-4813 (residence)


THE EAST 83 FEET OF THE WEST 166 FEET OF LOT 6
AND THE EAST 83 FEET OF THE WEST 166 FEET OF
LOT 7, BLOCK 1, E.D. PHILLIPS SUBDIVISION,
LOCATED IN THE NE 1/4 SECTION 36, TOWN 2 NORTH,
RANGE 17 EAST, CITY OF LAKE GENEVA, WALWORTH
COUNTY, WISCONSIN.

ORDERED BY: DAN CURRAN
133 DARWIN STREET
LAKE GENEVA, WIS. 53147

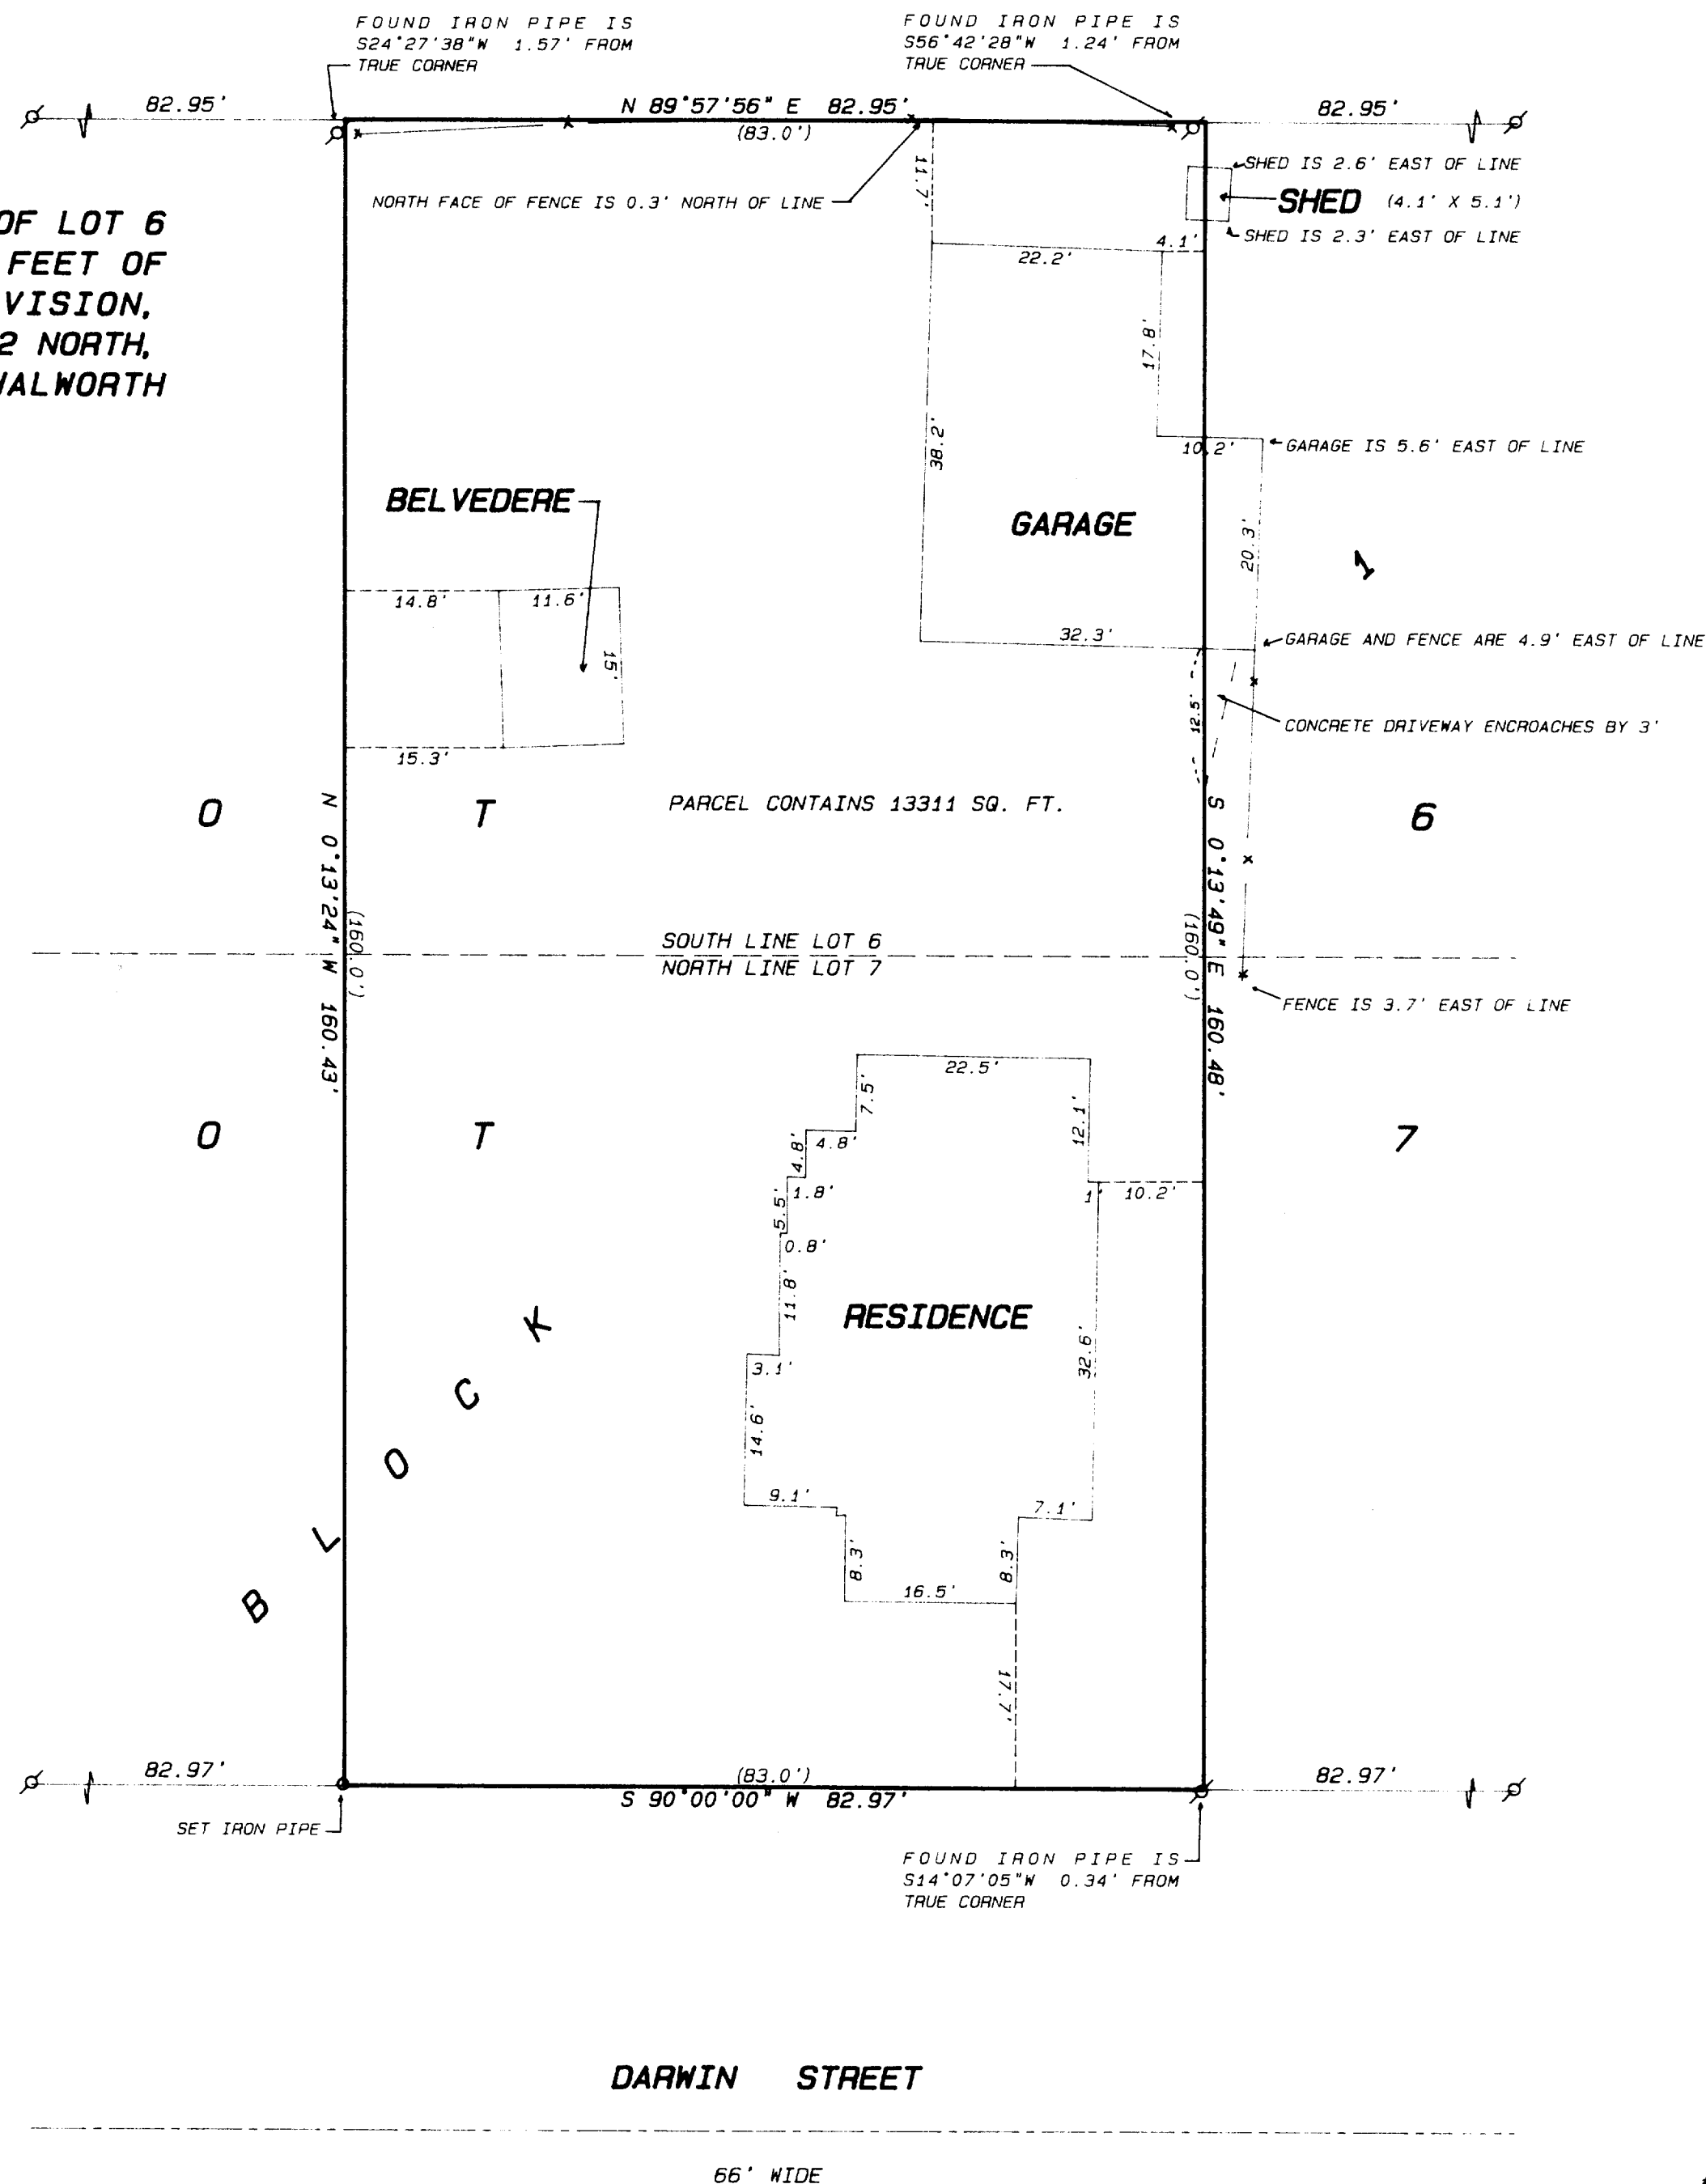

SOUTH LINE ASSUMED TO BEAR EAST

SCALE: 1 INCH = 15 FEET

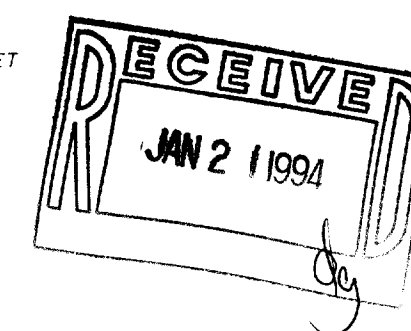

Legend

- * FOUND IRON PIPE
 ● FOUND IRON ROD
 ○ FOUND BRASS CAPPED MONUMENT
 * FOUND CONCRETE MONUMENT
 + CHISEL CUT IN CONCRETE
 ● SET IRON ROD, 24" LONG, WEIGHING
 1.5 LBS./LINEAL FT., 3/4" DIA.
 ● SET IRON ROD, 30" LONG, WEIGHING
 4.5 LBS./LINEAL FT., 1-11/16" DIA.
 {xx} RECORDED AS DIMENSION
 — x — x — EXISTING FENCE

SCALE: 1"= 15 FEET

"I hereby certify that I have surveyed the above described property and that the above map is a true representation of the same and shows the size and location of the property, its exterior boundaries, the location of all visible structures and dimensions of all principal buildings thereon, boundary fences, apparent easements, roadways and visible encroachments, if any."

"This survey is made for the use of the present owners of the property, and also those who purchase, mortgage, or guarantee the title thereto within one year from date hereof."

Kenneth B. Abernathy, Jr.
KENNETH B. ABERNATHY, JR.
WISCONSIN REGISTERED LAND SURVEYOR,
S-1594

Date: 11-19-93 Job No. 93.1111



ZPI-5

~~00~~7-1466