


KOLB LAND CONSULTING, INC.
LAND SURVEYING • SUBDIVIDING • LAND PLANNING

LAKE GENEVA, WISCONSIN 53147


414-248-3697

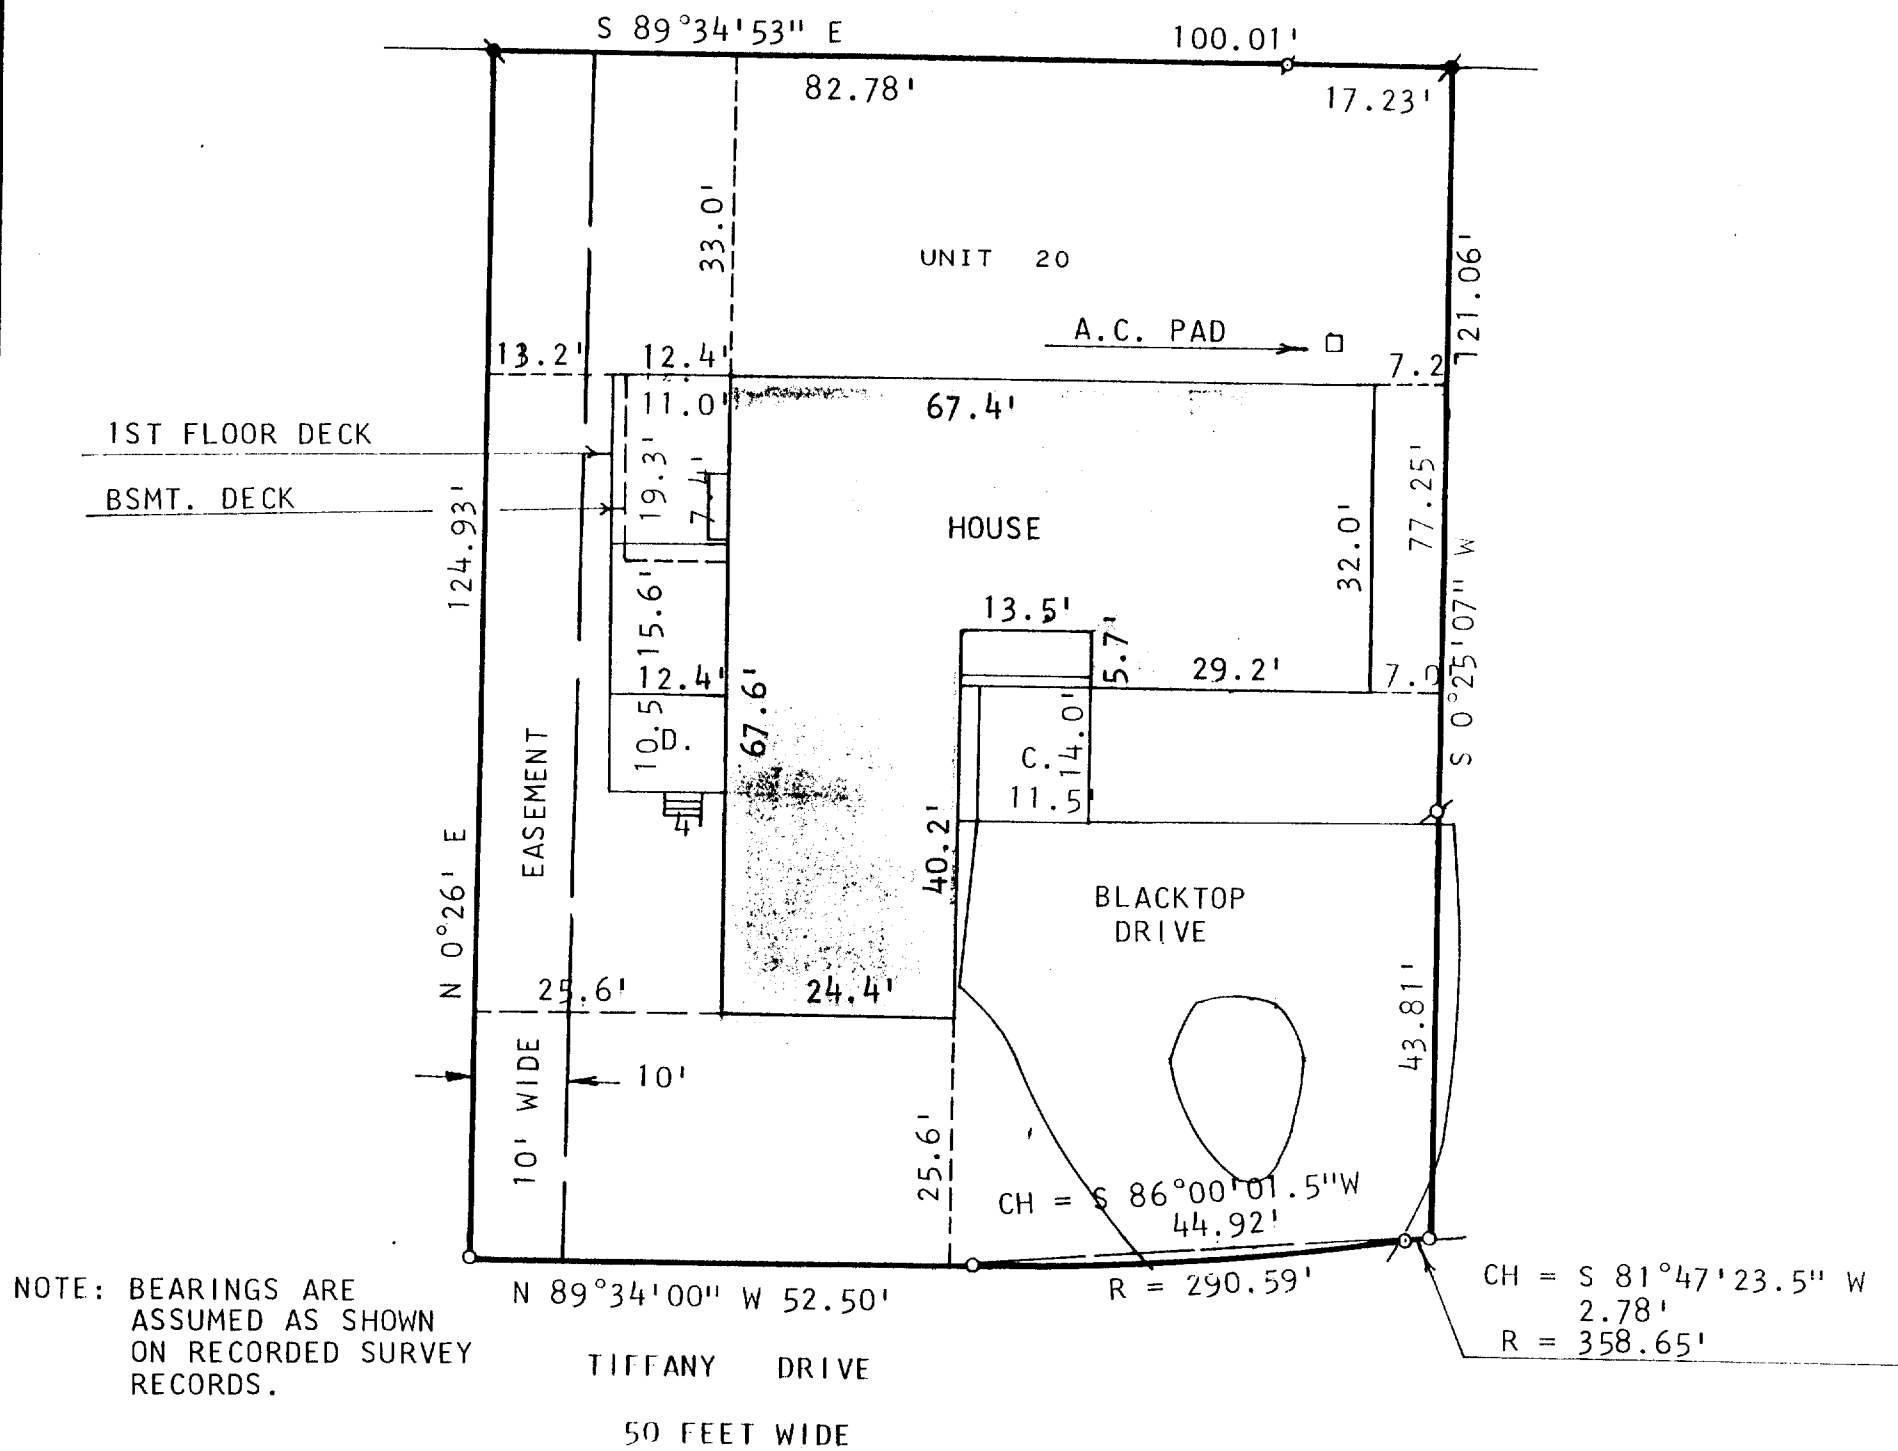

PLAT OF SURVEY OF

UNIT 20 OF SOMERSET, A CONDOMINIUM UNIT LOCATED
IN SECTION 1, OF THE CITY OF LAKE GENEVA, WAL-
WORTH COUNTY, WISCONSIN.

ORDERED BY: DAVID YEATS
1120 S. LAKE SHORE DR. UNIT 20
LAKE GENEVA, WI. 53147

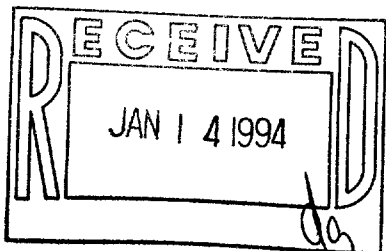

N
SCALE - 1"=20'

- LEGEND
- Ø - IRON PIPE FOUND
 - - IRON ROD FOUND
 - O - IRON PIPE SET
 - D - DECK
 - C - CONCRETE

I HEREBY CERTIFY THAT I HAVE SURVEYED THE ABOVE DESCRIBED PROPERTY AND THAT THE ABOVE MAP IS A TRUE REPRESENTATION THEREOF AND SHOWS THE SIZE AND LOCATION OF THE PROPERTY, ITS EXTERIOR BOUNDARIES, THE LOCATION OF ALL VISIBLE STRUCTURES AND DIMENSIONS OF ALL PRINCIPAL BUILDINGS THEREON, BOUNDARY FENCES, APPARENT EASEMENTS, ROADWAYS AND VISIBLE ENCROACHMENTS, IF ANY, TO THE BEST OF MY KNOWLEDGE AND BELIEF.

THIS SURVEY IS MADE FOR THE USE OF THE PRESENT OWNERS OF THE PROPERTY, AND ALSO THOSE WHO PURCHASE, MORTGAGE, OR GUARANTEE THE TITLE THERETO WITHIN ONE (1) YEAR FROM DATE HEREOF. THIS SURVEY IS NOT VALID UNLESS THE SURVEYOR'S SIGNATURE IS IN RED.

HAROLD H. KOLB
WISCONSIN REGISTERED LAND SURVEYOR, S-187
DATE April 30, 1993