


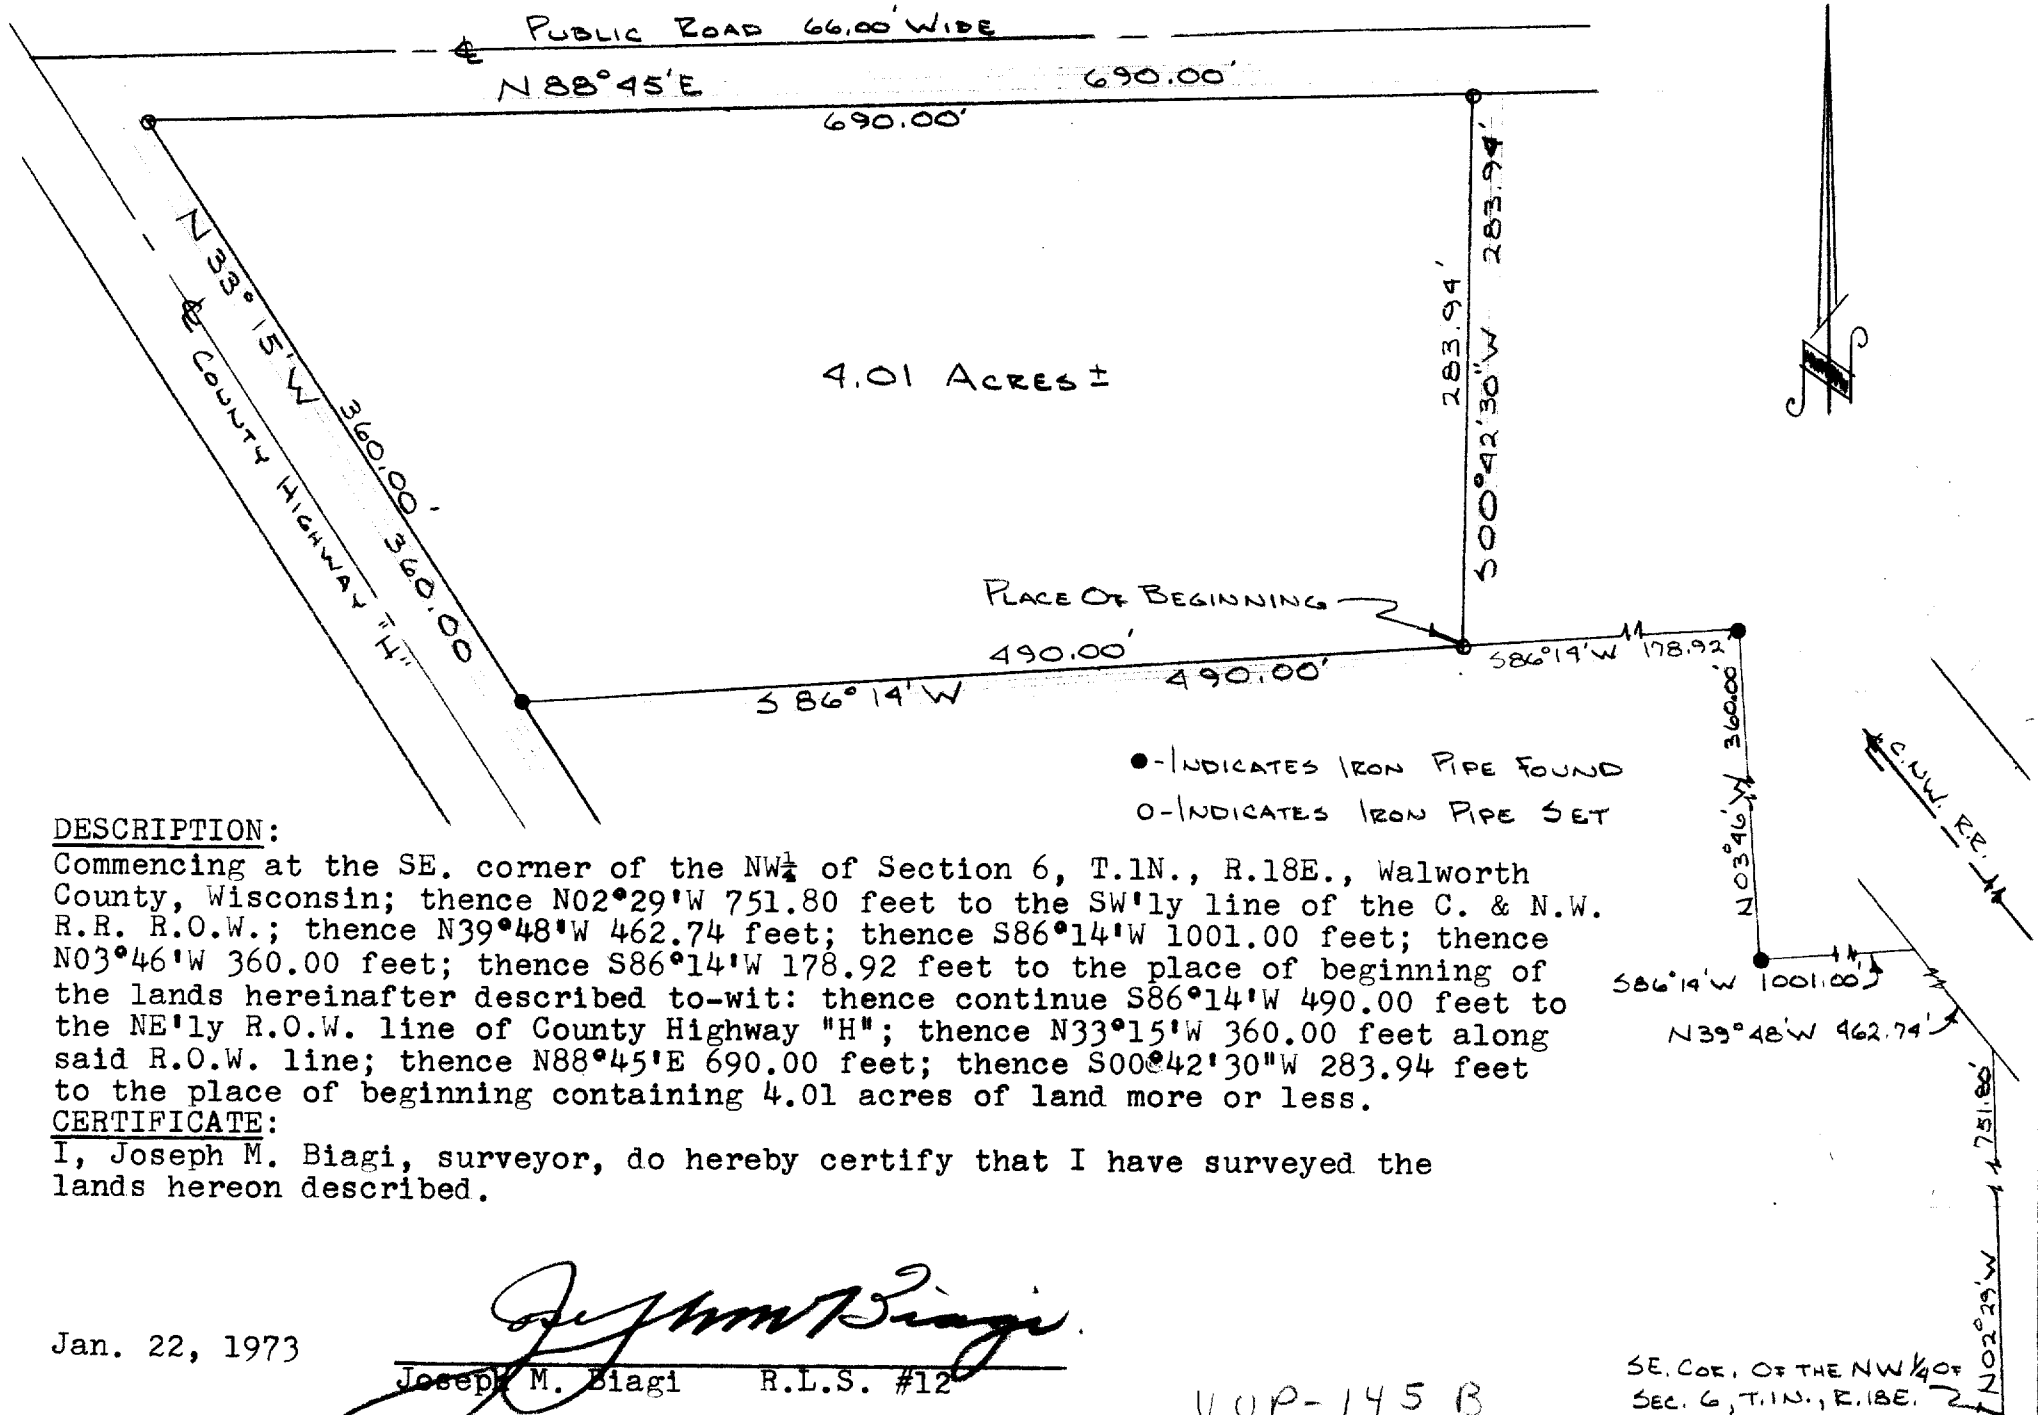

DESCRIPTION:

Commencing at the SE. corner of the NW¹/₄ of Section 6, T.1N., R.18E., Walworth County, Wisconsin; thence N02°29'W 751.80 feet to the SW¹/₄ly line of the C. & N.W. R.R. R.O.W.; thence N39°48'W 462.74 feet; thence S86°14'W 1001.00 feet; thence N03°46'W 360.00 feet; thence S86°14'W 178.92 feet to the place of beginning of the lands hereinafter described to-wit: thence continue S86°14'W 490.00 feet to the NE¹/₄ly R.O.W. line of County Highway "H"; thence N33°15'W 360.00 feet along said R.O.W. line; thence N88°45'E 690.00 feet; thence S00°42'30"W 283.94 feet to the place of beginning containing 4.01 acres of land more or less.

CERTIFICATE:

I, Joseph M. Biagi, surveyor, do hereby certify that I have surveyed the lands hereon described.

Jan. 22, 1973

Joseph M. Biagi
Joseph M. Biagi R.L.S. #12

YOP-145 B

SE. COR. OF THE NW 1/4 OF SEC. 6, T.1N., R.18E.

7-148B 7-148B