



HAROLD H. KOLB
REGISTERED PROFESSIONAL LAND SURVEYOR
LAKE GENEVA, WISCONSIN

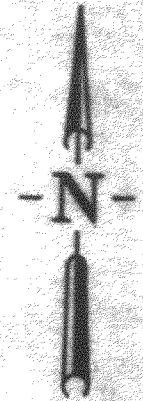

Scale 1"=30'

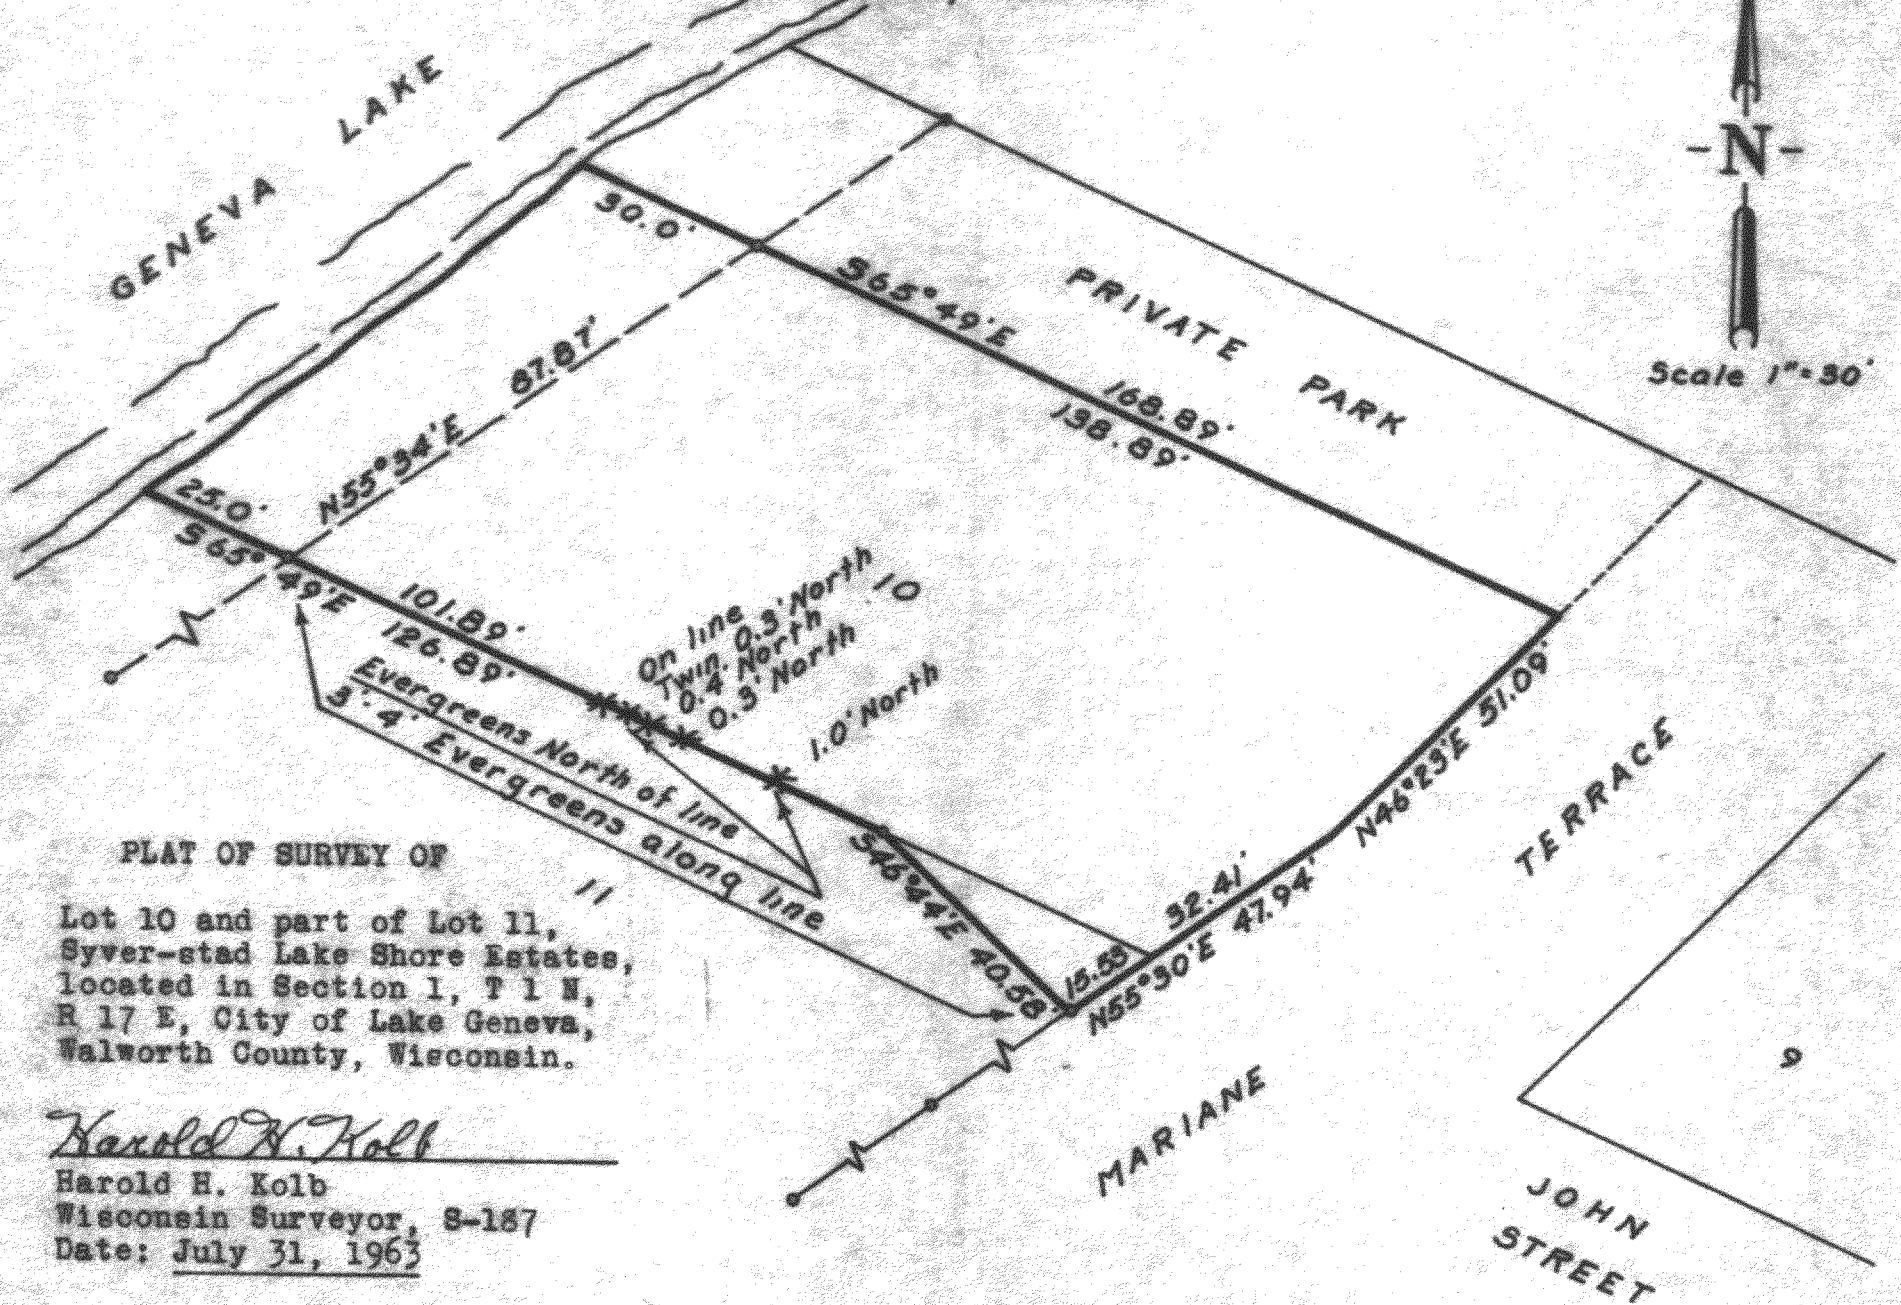

PLAT OF SURVEY OF

Lot 10 and part of Lot 11,
Syverstad Lake Shore Estates,
located in Section 1, T 1 N,
R 17 E, City of Lake Geneva,
Walworth County, Wisconsin.

Harold H. Kolb

Harold H. Kolb
Wisconsin Surveyor, 8-187
Date: July 31, 1963

- - Conc. Monument Found
- - Iron Pipe Found