


KOLB LAND CONSULTING, INC.
LAND SURVEYING • SUBDIVIDING • LAND PLANNING

929 WILLIAMS STREET LAKE GENEVA, WISCONSIN 53147 414 248 3697


LOGAN STREET 60' WIDE

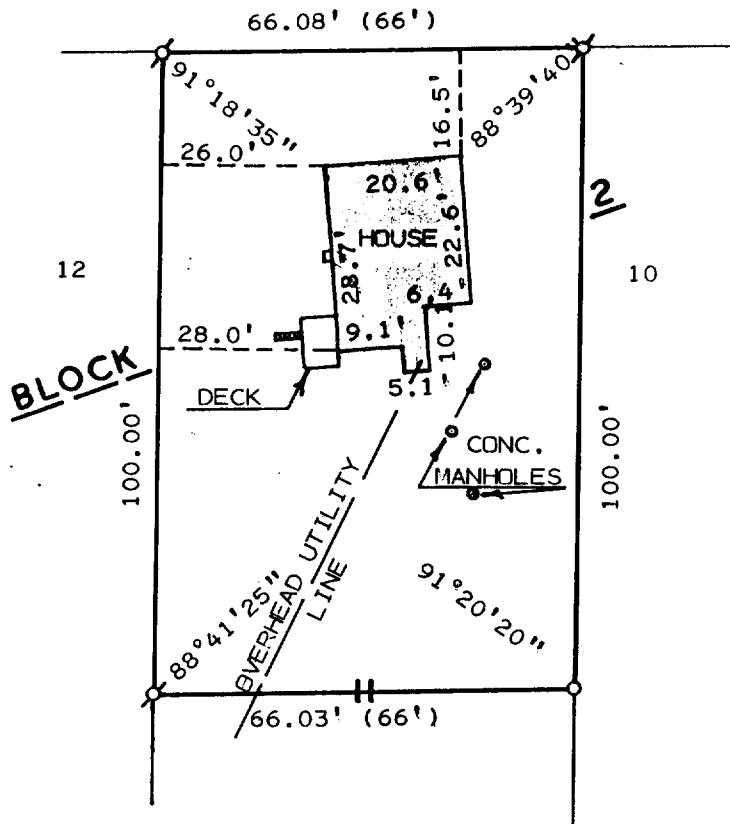

ORDERED BY: RICHARD LEECH
1029 DODGE STREET
LAKE GENEVA, WI. 53147

PLAT OF SURVEY OF

THE NORTH 100.00 FEET OF LOT 11, BLOCK 2 OF
WHEELERS ADDITION TO THE CITY OF LAKE GENEVA,
WALWORTH COUNTY, WISCONSIN.

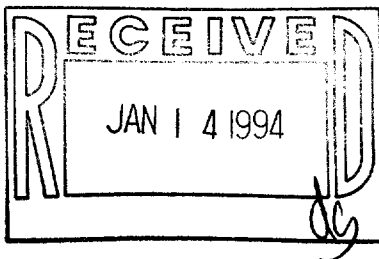

I HEREBY CERTIFY THAT I HAVE SURVEYED THE ABOVE DESCRIBED PROPERTY AND THAT THE ABOVE MAP IS A TRUE REPRESENTATION THEREOF AND SHOWS THE SIZE AND LOCATION OF THE PROPERTY, ITS EXTERIOR BOUNDARIES, THE LOCATION OF ALL VISIBLE STRUCTURES AND DIMENSIONS OF ALL PRINCIPAL BUILDINGS THEREON, BOUNDARY FENCES, APPARENT EASEMENTS, ROADWAYS AND VISIBLE ENCROACHMENTS, IF ANY, TO THE BEST OF MY KNOWLEDGE AND BELIEF.

THIS SURVEY IS MADE FOR THE USE OF THE PRESENT OWNERS OF THE PROPERTY AND ALSO THOSE WHO PURCHASE, MORTGAGE OR GUARANTEE THE TITLE THERETO WITHIN ONE (1) YEAR FROM DATE HEREOF, SURVEY NOT VALID UNLESS SURVEYOR'S SIGNATURE IS IN RED.



SCALE: 1" = 30'

LEGEND

⊗ - IRON PIPE FOUND
○ - IRON PIPE SET
() - AS RECORDED

HAROLD H. KOLB

WISCONSIN REGISTERED LAND SURVEYOR, S-187

DATE DECEMBER 13, 1993

REVISED

REVISED

ZWH-7C

LG-497A

007-1490