


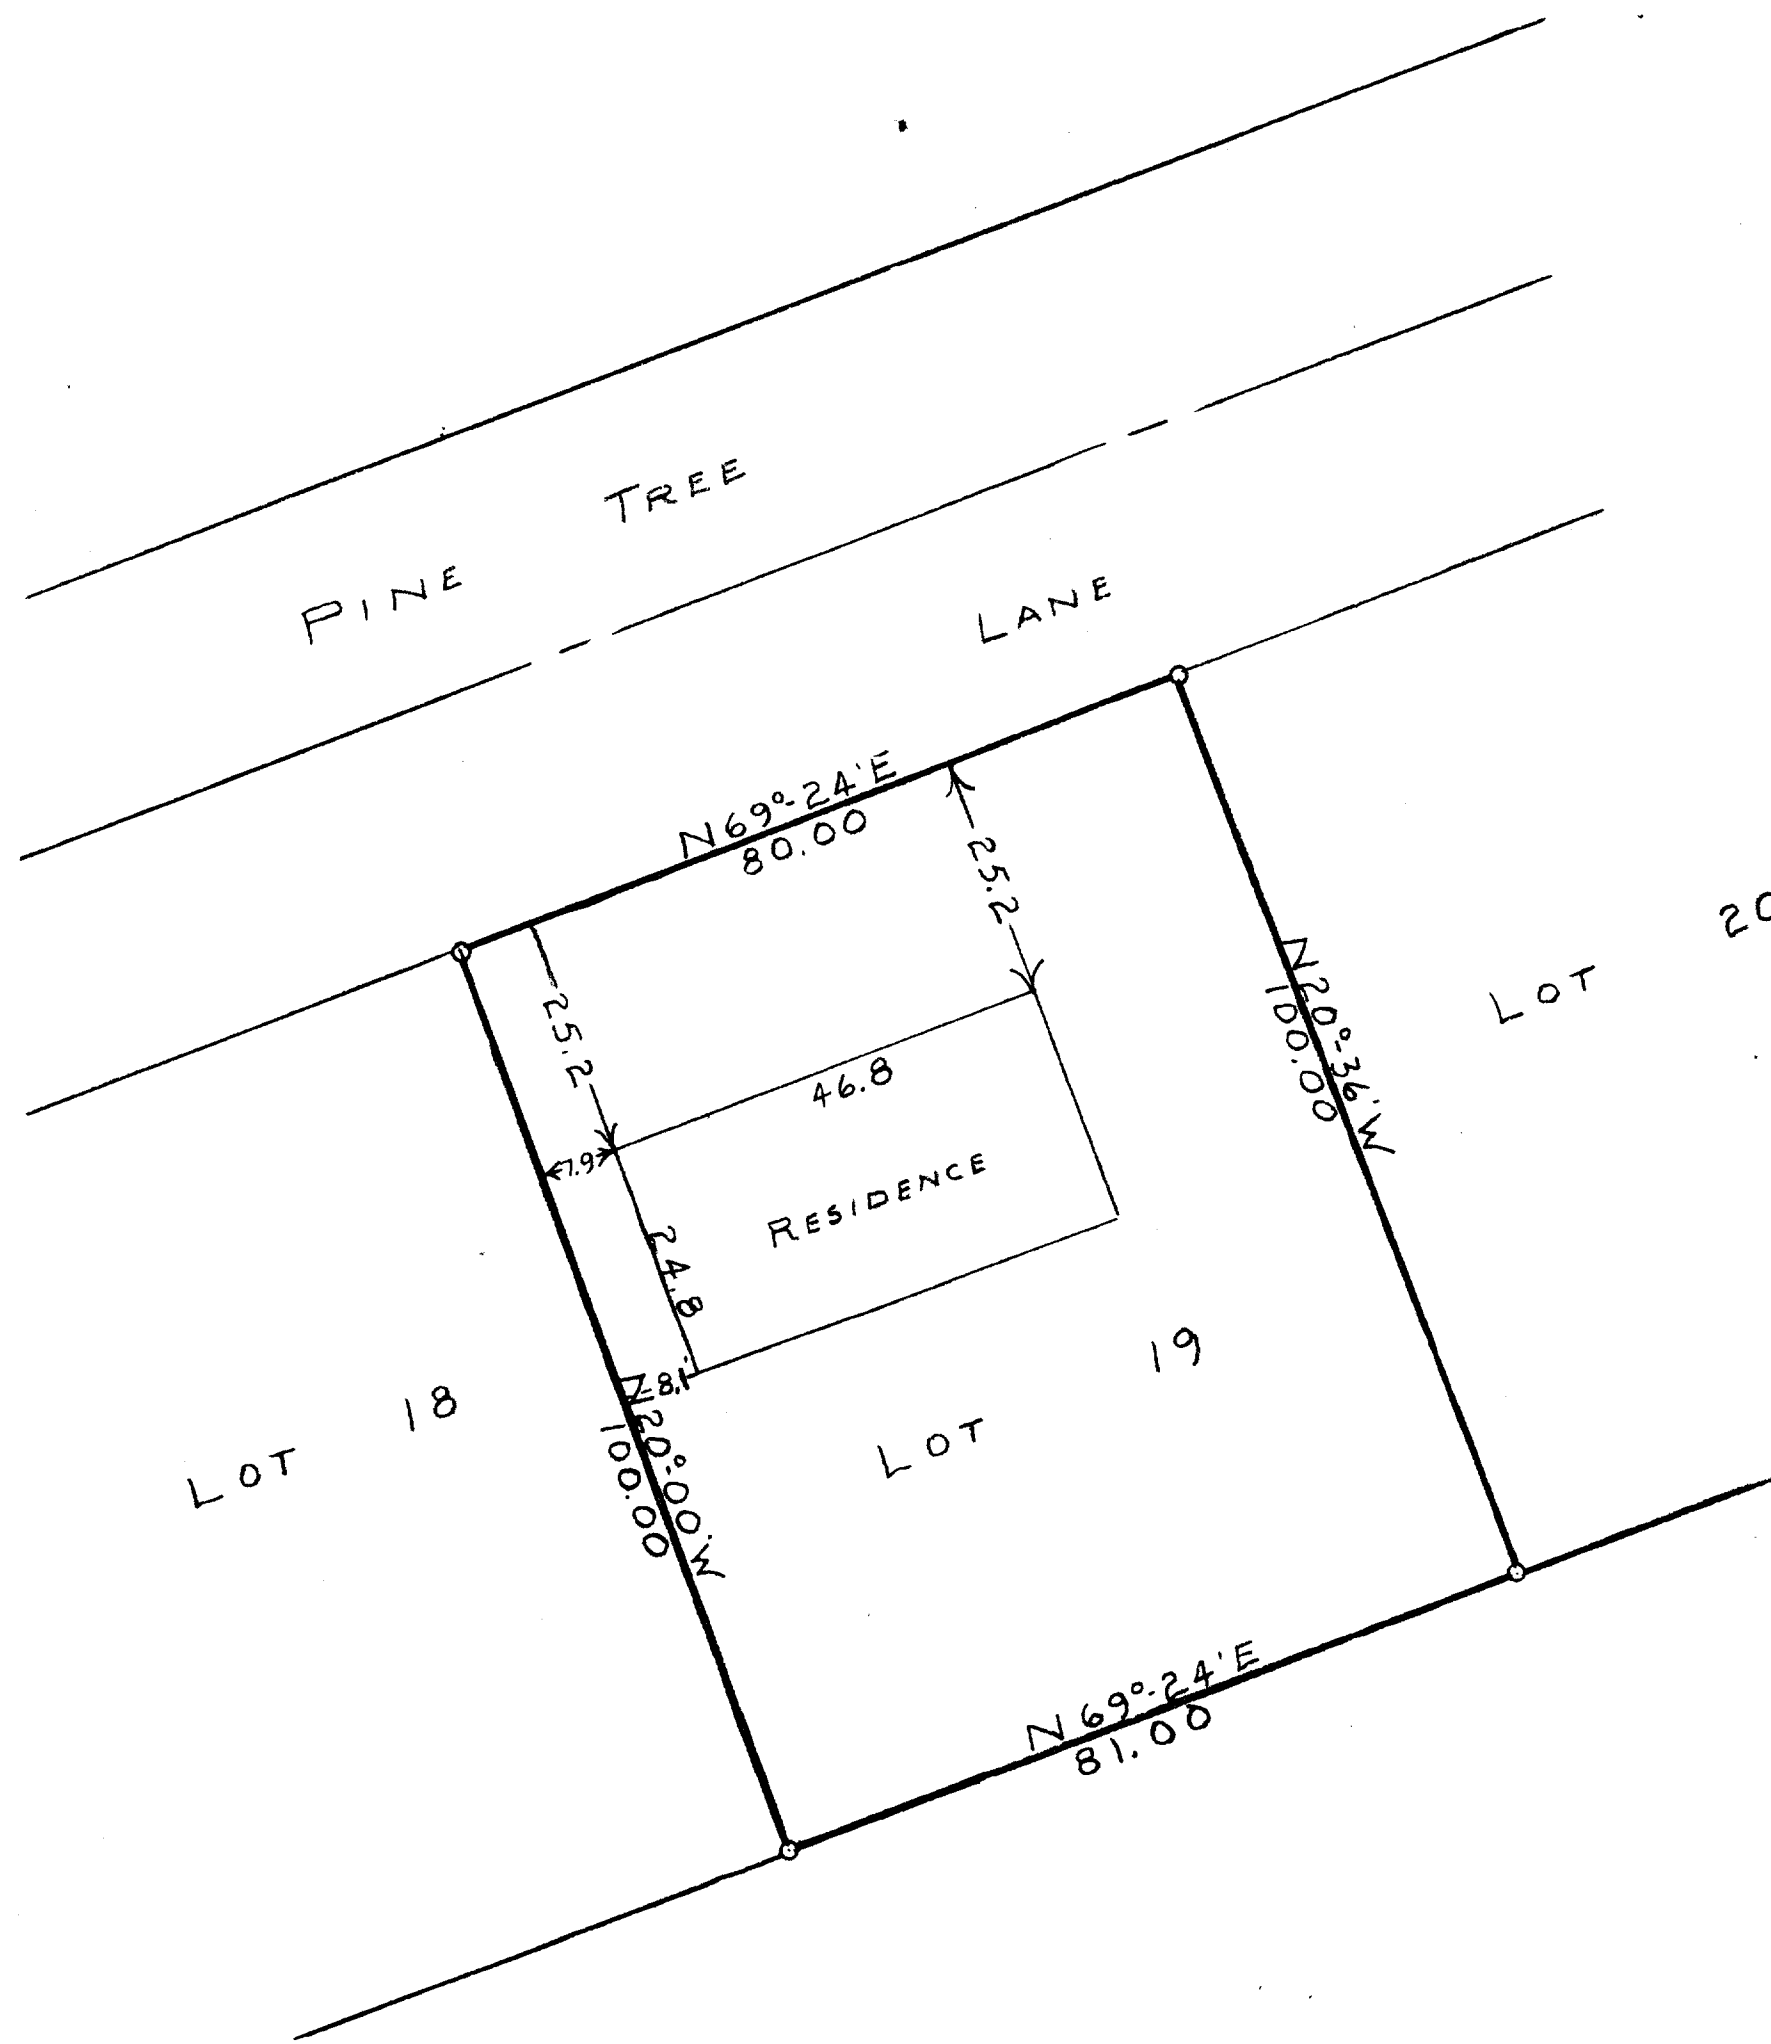

SCALE - 1" = 20'
O = IRON PIPE

STATE OF WISCONSIN)
COUNTY OF WALWORTH)
I, GEORGE T. DUNHAM, DO HEREBY CERTIFY THAT I HAVE SURVEYED
THE PROPERTY DESCRIBED AS FOLLOWS:
LOT 19 OF SYVER-STAD LAKE SHORE ESTATES LOCATED IN THE CITY
OF LAKE GENEVA, WALWORTH COUNTY, WISCONSIN
AND THAT THE PLAT SHOWN ABOVE IS A CORRECT REPRESENTATION OF THE
PROPERTY LINES.
DEC. 1955

George T. Dunham
GEORGE T. DUNHAM, SURVEYOR
DELAVER, WISCONSIN

7-15

54-19