


HAROLD H. KOLB
REGISTERED PROFESSIONAL LAND SURVEYOR
LAKE GENEVA, WISCONSIN

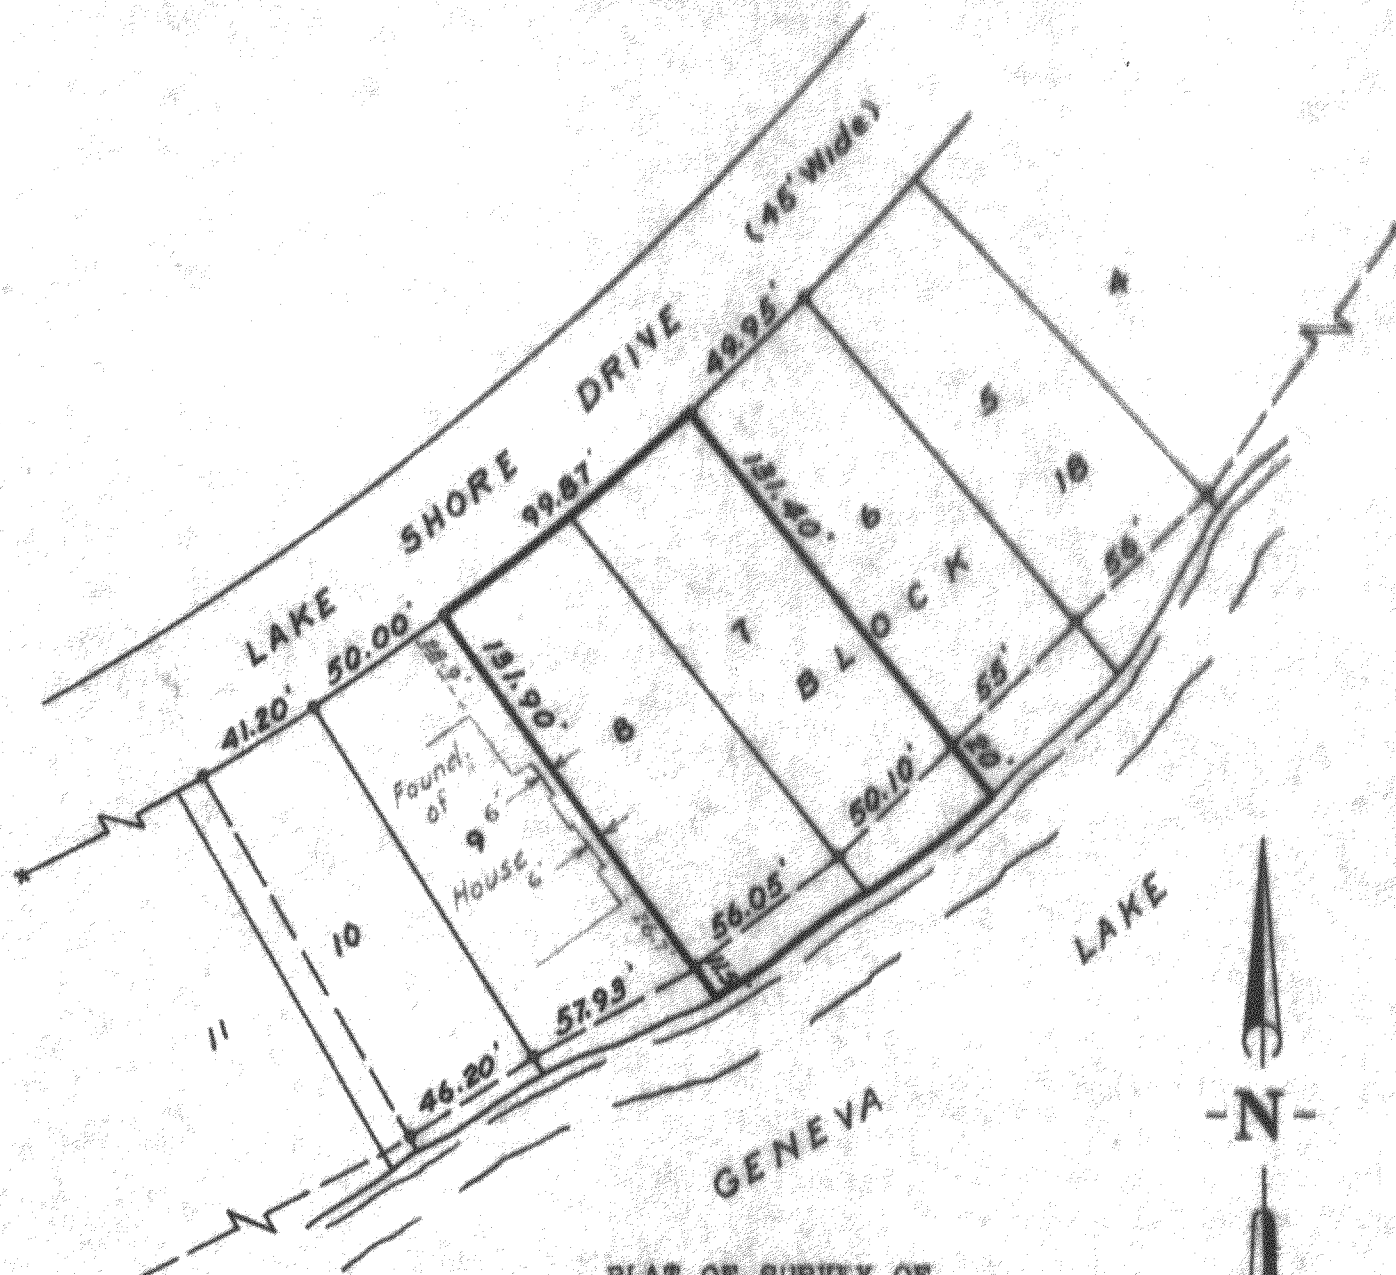

PLAT OF SURVEY OF

Lots 7 & 8, Block 18, Lake Geneva
Manor, City of Lake Geneva, Walworth
County, Wisconsin.

Harold H. Kolb

Harold H. Kolb
Wisconsin Surveyor, 9-187
DATE: September 12, 1963



* - Cross in Conc. Found
• - Iron Pipe Found

ZLM-39

Scale 1" = 60'

7-150