


KOLB LAND CONSULTING, INC.  
LAND SURVEYING • SUBDIVIDING • LAND PLANNING

929 WILLIAMS STREET

LAKE GENEVA, WISCONSIN 53147

414-248-3697

NOTE: BEARINGS ARE ASSUMED  
AS SHOWN ON PREVIOUS  
SURVEY RECORDS.

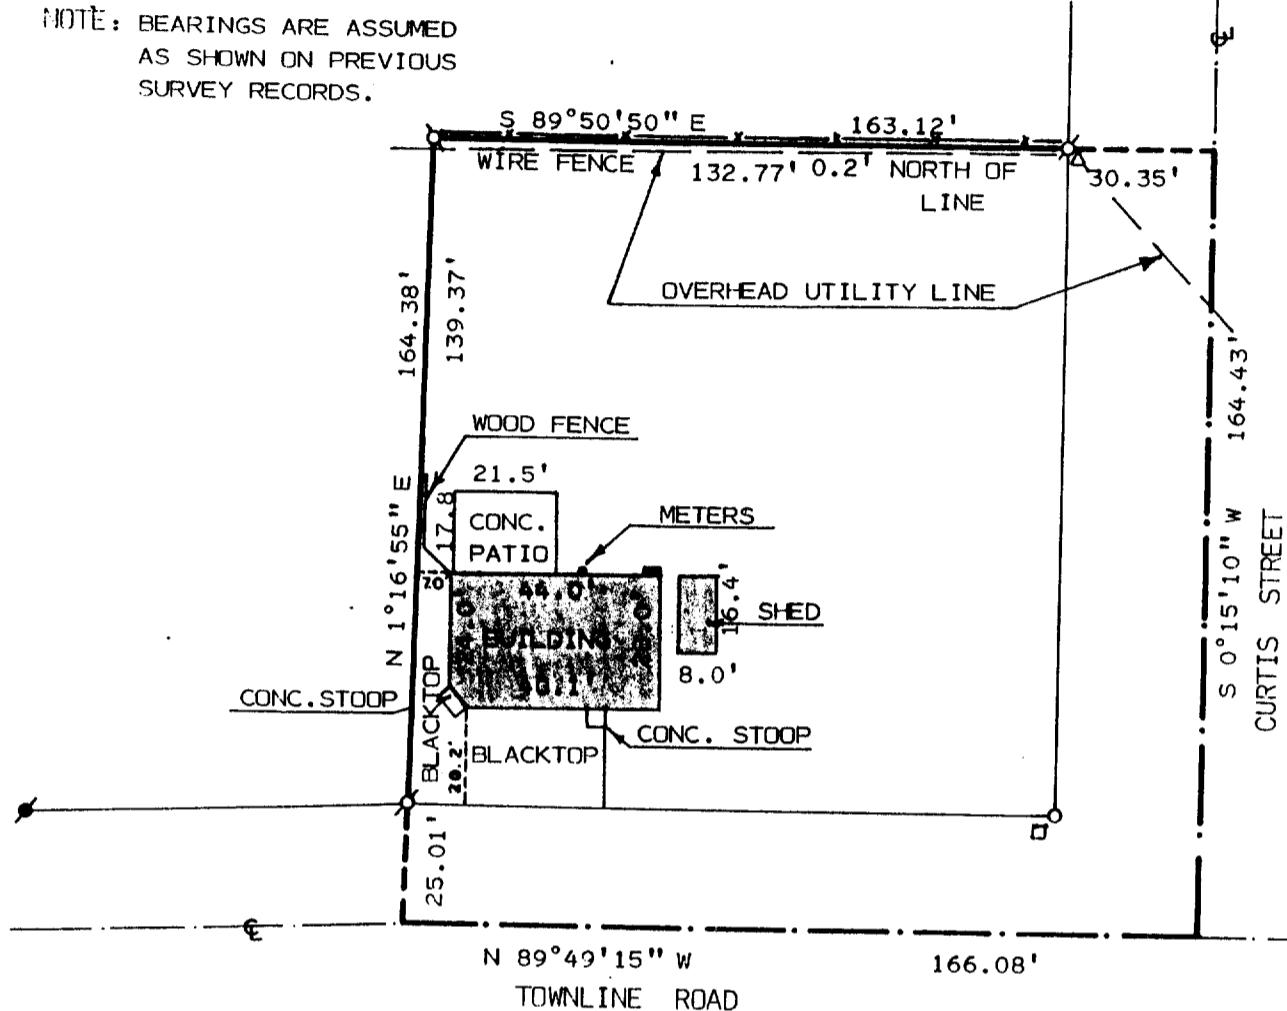

ORDERED BY: EDWARD J. MOONEY  
HWY 36 N.

LAKE GENEVA, WI 53147

PLAT OF SURVEY OF

A PARCEL OF LAND LOCATED IN THE SOUTHEAST 1/4  
OF SECTION 36, T2N, R17E, BEING PART OF SUB-LOT  
26 OF THE ORIGINAL PLAT OF THE CITY OF LAKE  
GENEVA, CITY OF LAKE GENEVA, WALWORTH COUNTY,  
WISCONSIN.

I HEREBY CERTIFY THAT I HAVE SURVEYED THE  
ABOVE DESCRIBED PROPERTY AND THAT THE ABOVE  
MAP IS A TRUE REPRESENTATION THEREOF AND  
SHOWS THE SIZE AND LOCATION OF THE PROPERTY,  
ITS EXTERIOR BOUNDARIES, THE LOCATION OF ALL  
VISIBLE STRUCTURES AND DIMENSIONS OF ALL  
PRINCIPAL BUILDINGS THEREON, BOUNDARY FENCES,  
APPARENT EASEMENTS, ROADWAYS AND VISIBLE  
ENCROACHMENTS, IF ANY, TO THE REST OF MY  
KNOWLEDGE AND BELIEF.

THIS SURVEY IS MADE FOR THE USE OF THE  
PRESENT OWNERS OF THE PROPERTY AND ALSO  
THOSE WHO PURCHASE, MORTGAGE OR GUARANTEE  
THE TITLE THERETO WITHIN ONE (1) YEAR FROM  
DATE HEREOF. SURVEY NOT VALID UNLESS SURVEYOR'S  
SIGNATURE IS IN RED.

SCALE: 1" = 40'



HAROLD H. KOLB  
WISCONSIN REGISTERED LAND SURVEYOR, S-187

DATE SEPTEMBER 14, 1993

REVISED \_\_\_\_\_

REVISED \_\_\_\_\_