
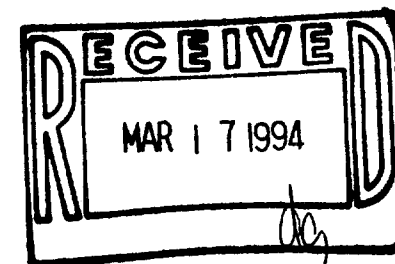


CERTIFICATE OF LAND SURVEYING

PLAN OF SURVEY

Lot 2 in Block 31 of LAKE GENEVA LANCER, Tract No. 17
 being a Subdivision in the East Half of Section 36,
 Town 2 North, Range 17 East, in the City of Lake Geneva,
 Walworth County, Wisconsin.

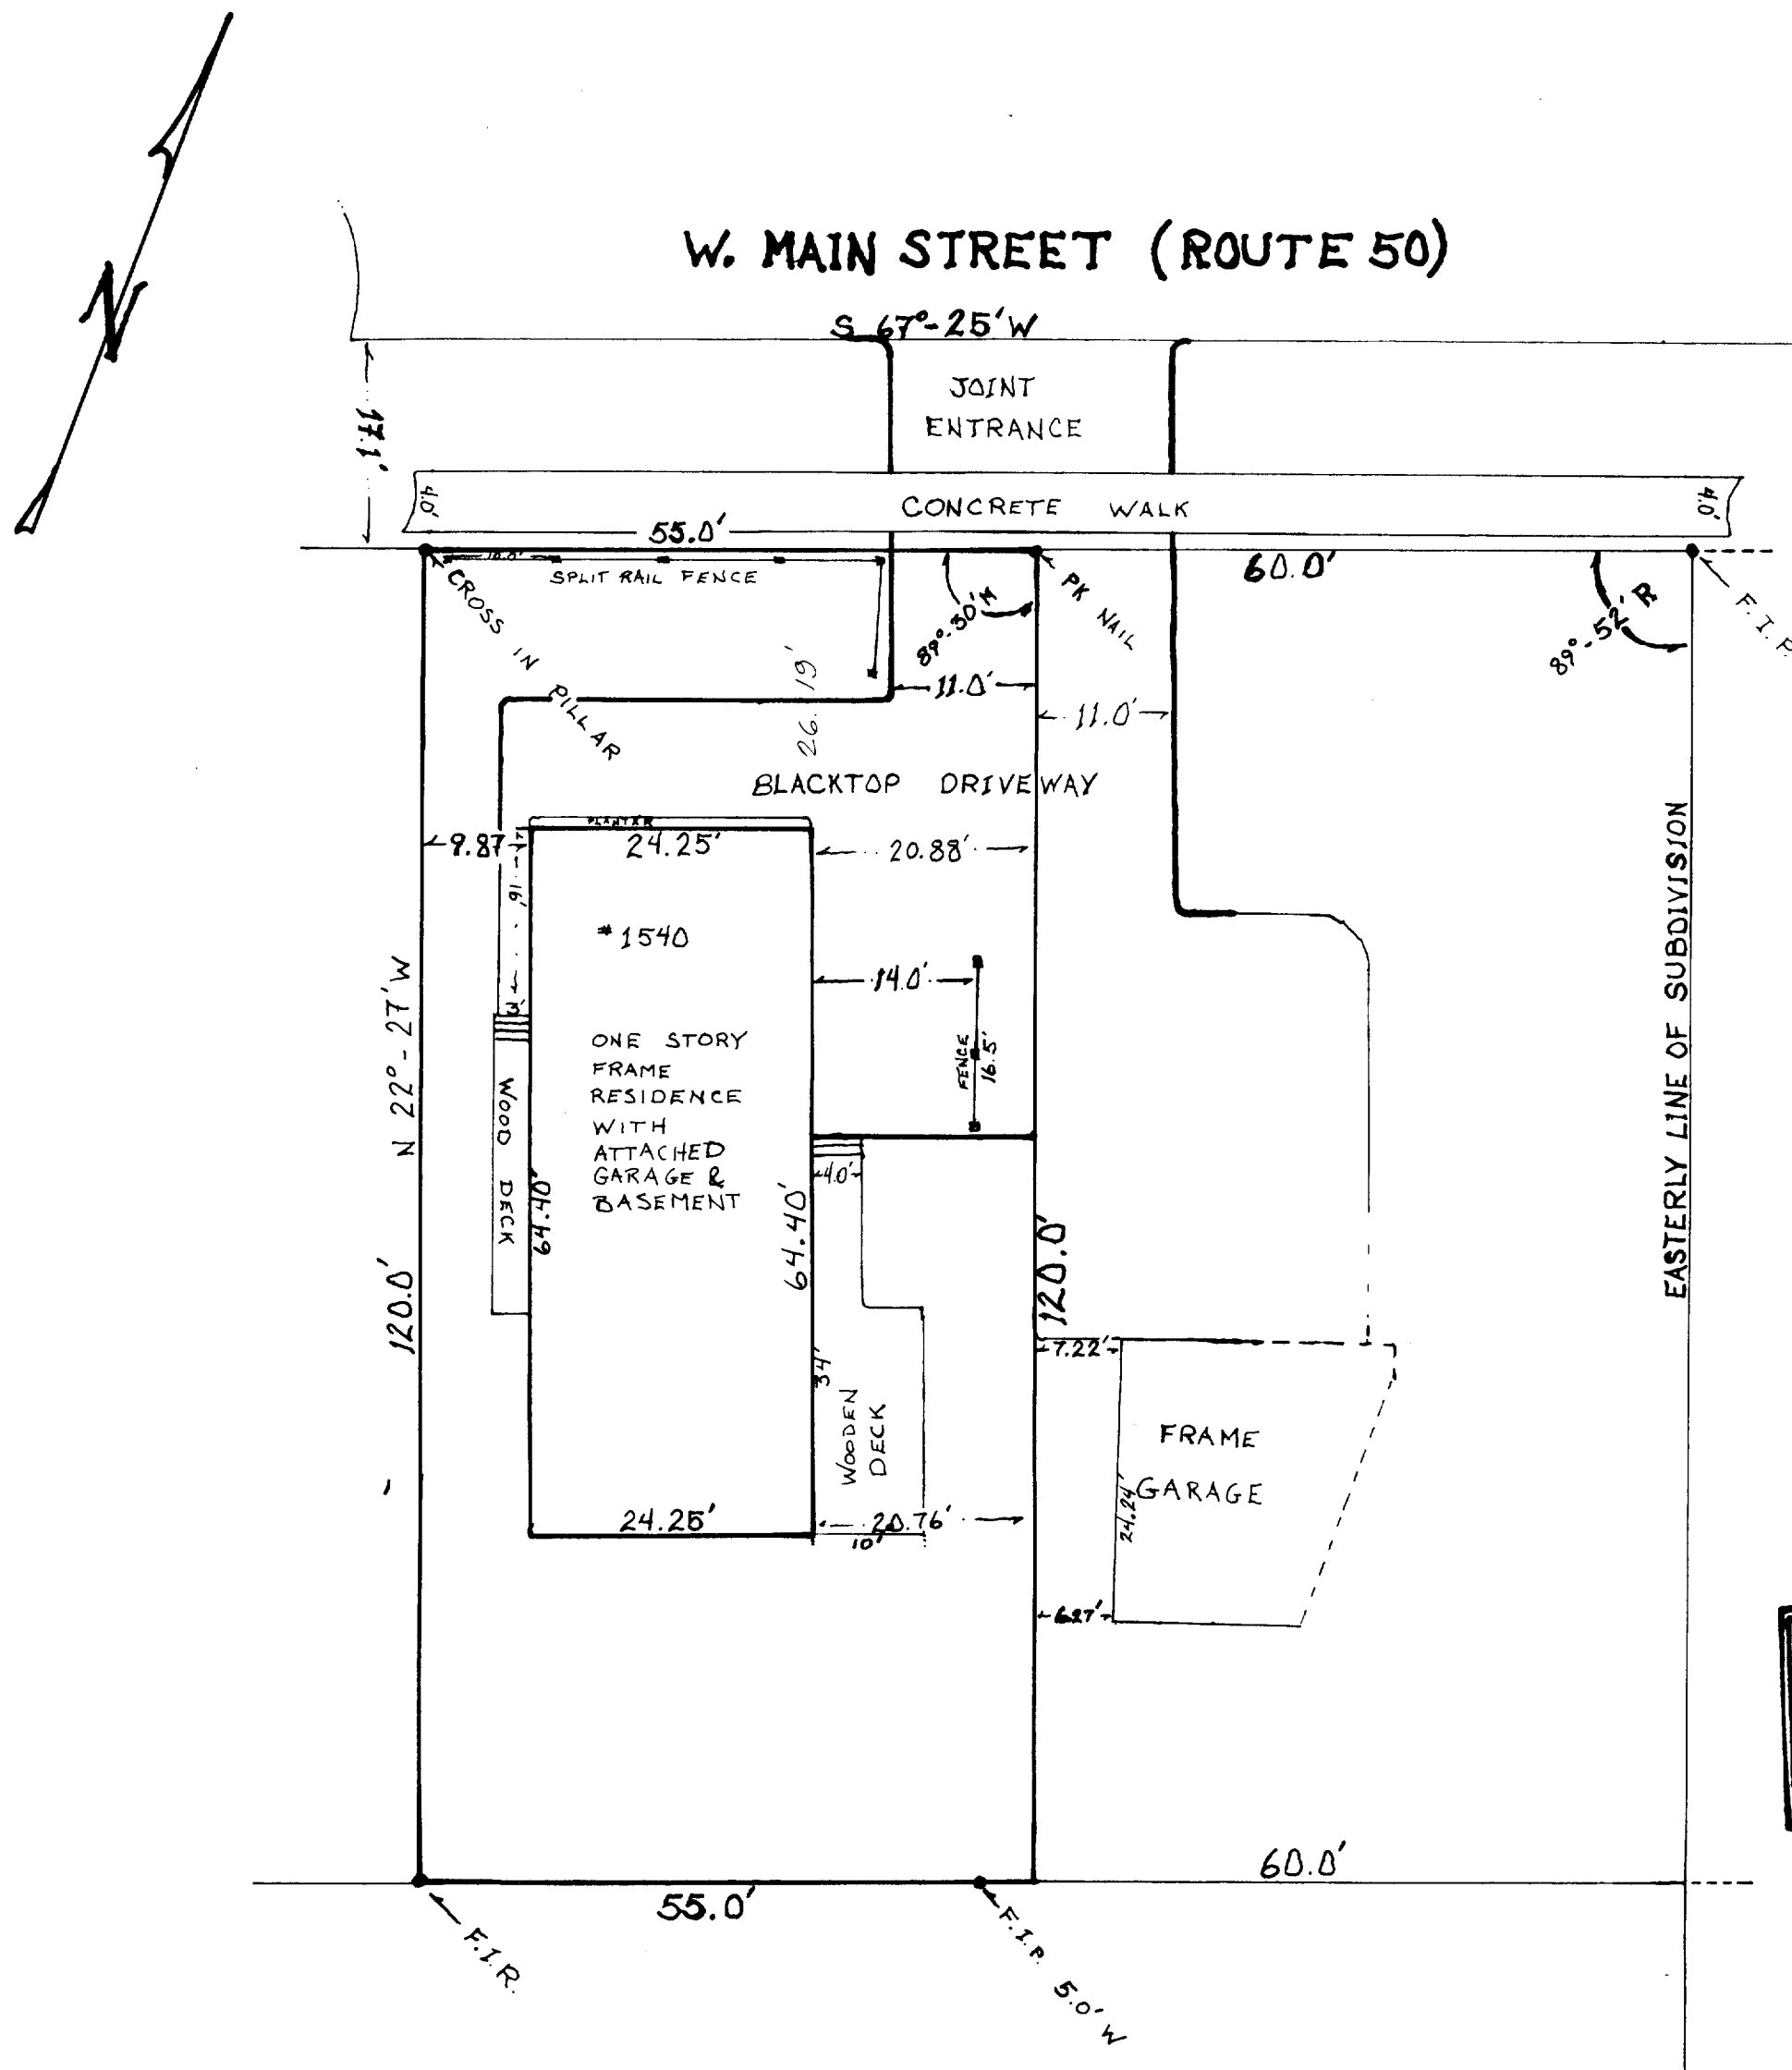

SURVEY NO. 224
 ORDERED BY: Wilson Wendell
 FIELD BOOK: Walworth
 Page 11

DATE: Nov. 27, 1993
 TOWN OF WISCONSIN
 WALWORTH COUNTY

NOTE: Any discrepancies in measurement discovered
 upon the ground should be promptly reported
 to the surveyor for examination or correction.

Charles E. Smith, hereby certifies
 that he has surveyed the above
 described property and that the
 plat hereon drawn is a correct
 representation of same.

Charles E. Smith
 Wisconsin Registered Land
 Surveyor No. 1038