



PLAT OF SURVEY

UNIT 34 OF SOMERSET
CONDOMINIUM BEING PART OF THE
NORTHWEST 1/4 OF SECTION 1,
TOWN 1 NORTH, RANGE 17 EAST,
BEING PART OF GREENRIDGE DOWNS
IN THE CITY OF LAKE GENEVA,
WALWORTH COUNTY, WISCONSIN.


LEGAL DESCRIPTION REFERENCE
VOL. 220 OF DEEDS PAGE 186

ORDERED BY: WYNTREE CONSTRUCTION
P.O. BOX 460
LAKE GENEVA, WI. 53147-0460

OWNERS: JOHN AND TERRI ROBERT

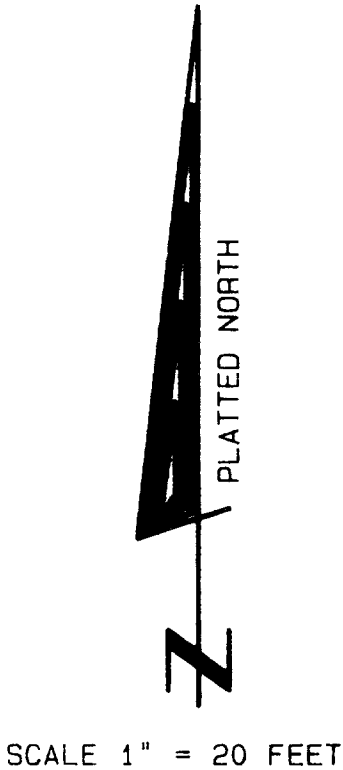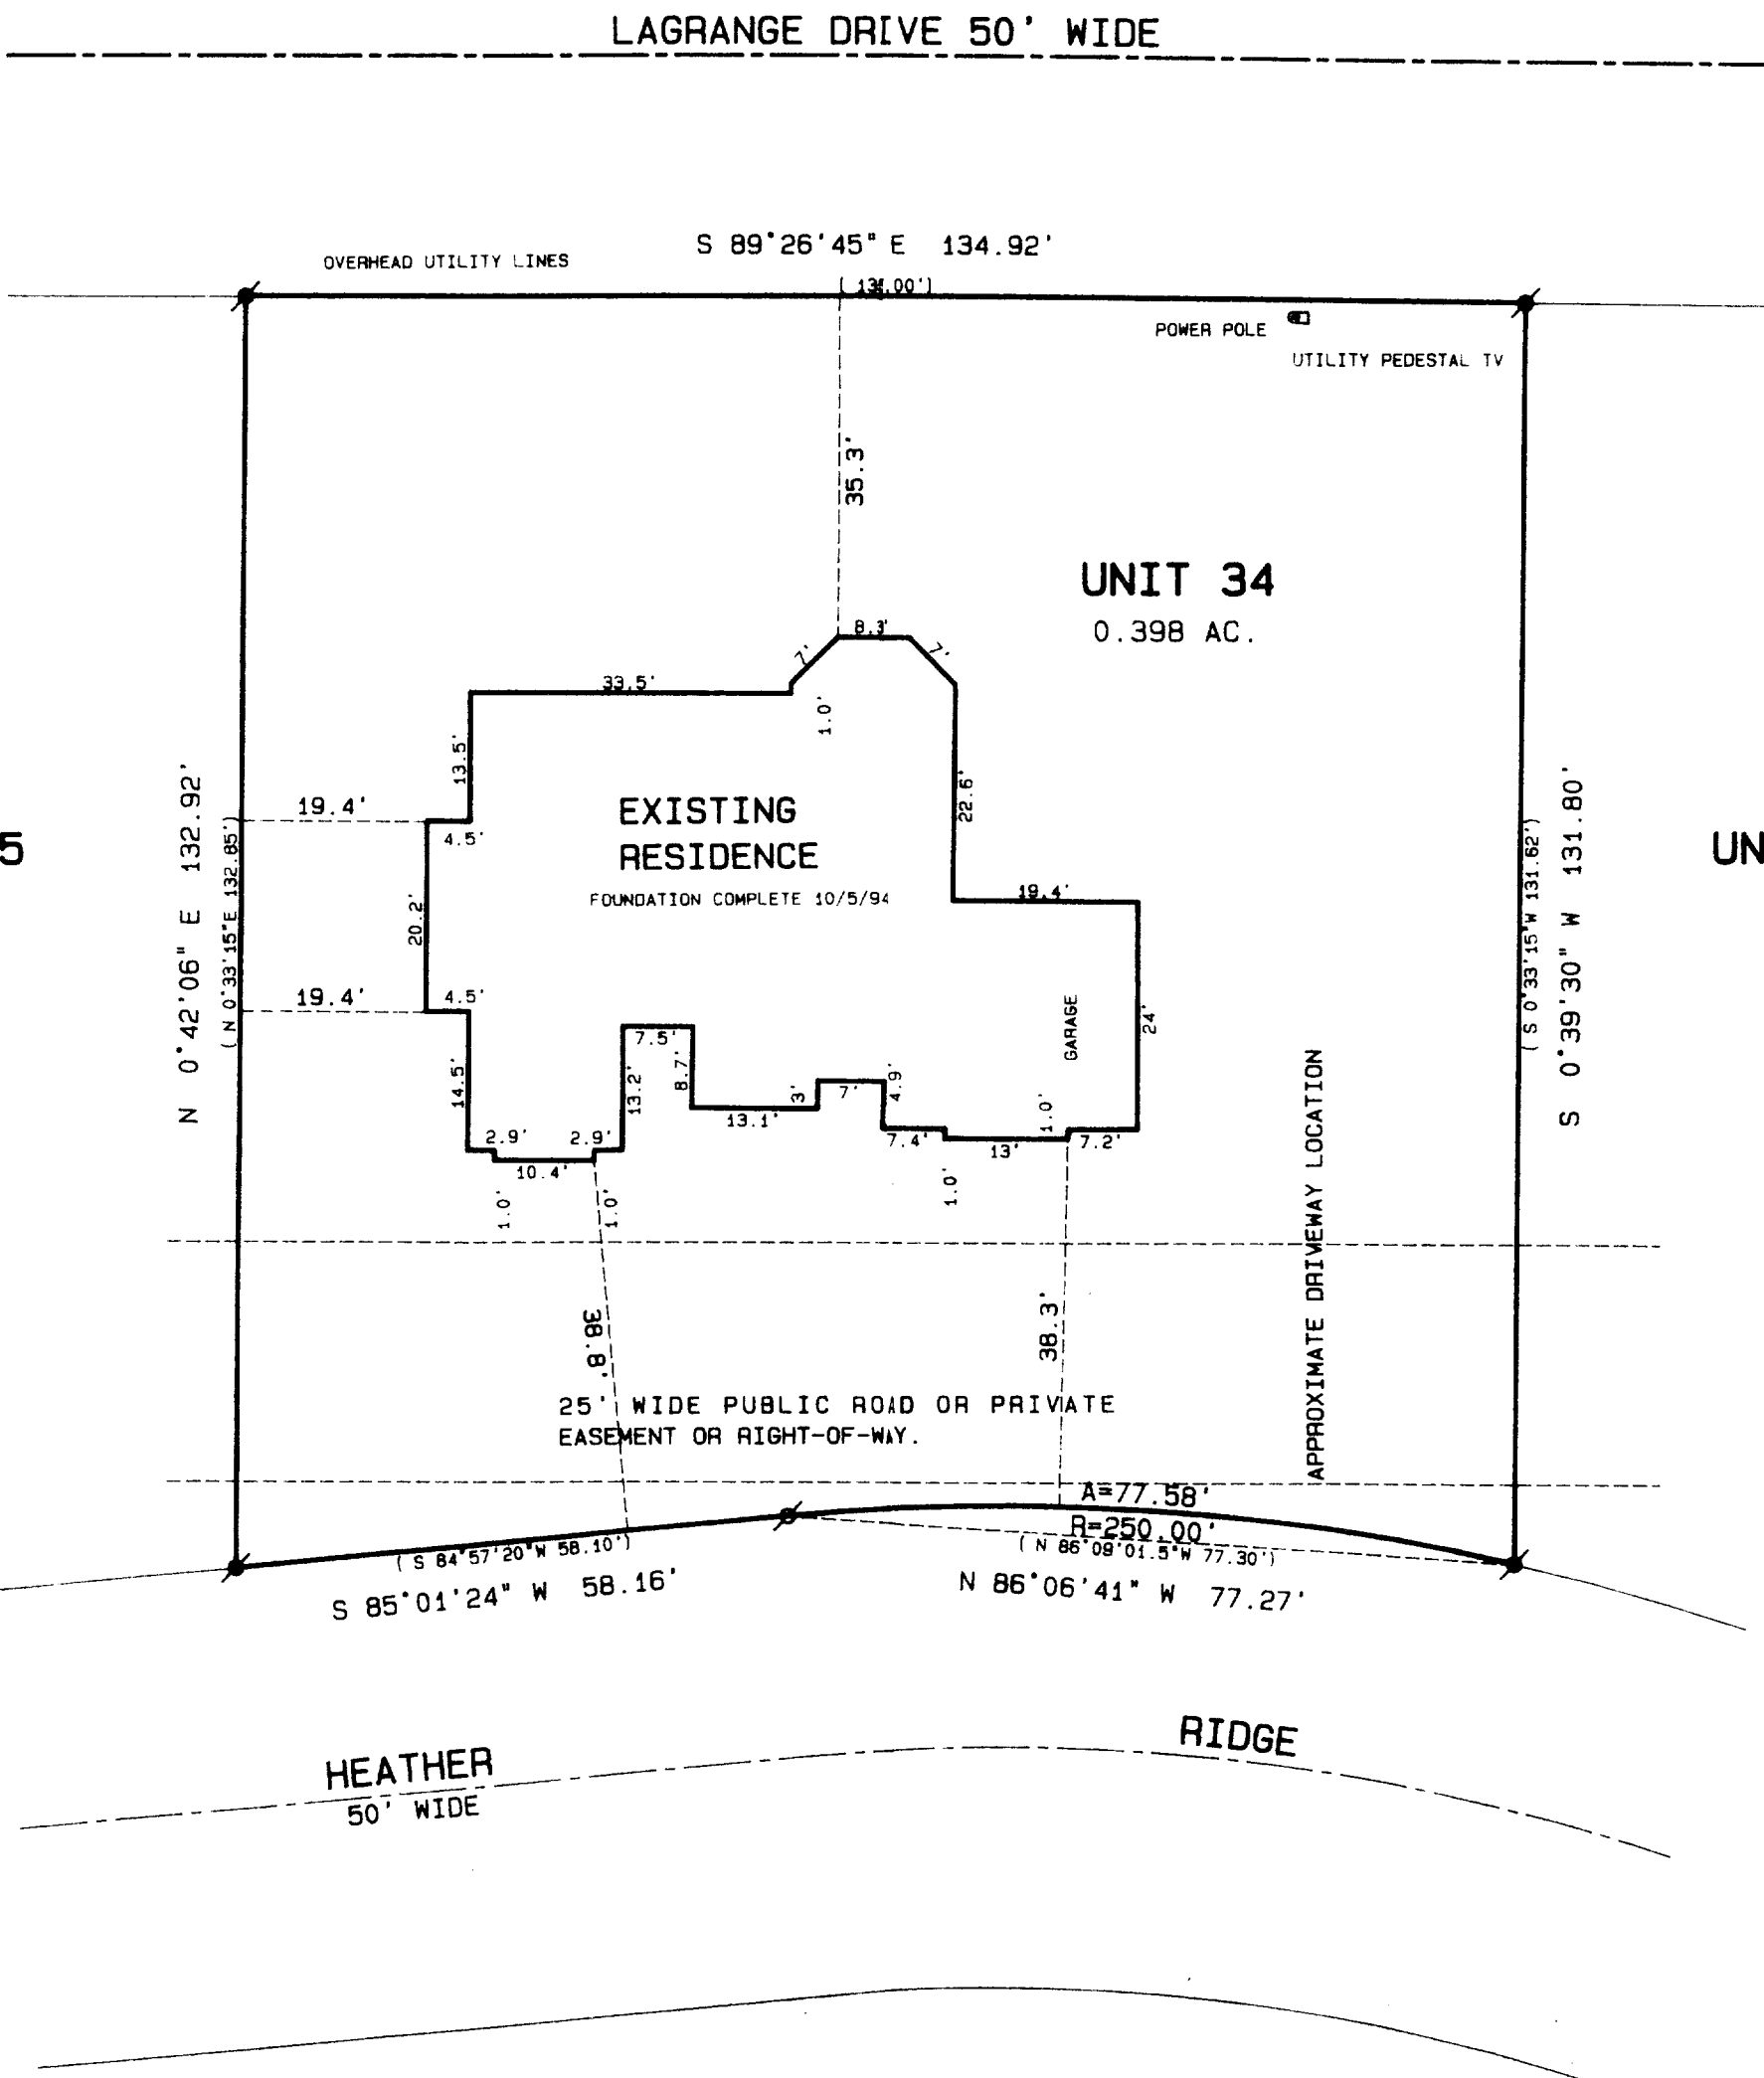

- Legend
- FOUND IRON PIPE
 - FOUND IRON ROD
 - FOUND BRASS CAPPED MONUMENT
 - FOUND CONCRETE MONUMENT
 - CHISEL CUT IN CONCRETE
 - SET IRON ROD, 24" LONG, WEIGHING 1.5 LBS./LINEAL FT., 3/8" DIA.
 - SET IRON ROD, 30" LONG, WEIGHING 4.5 LBS./LINEAL FT., 1-11/16" DIA.
 - (XX) RECORDED AS DIMENSION
 - EXISTING FENCE

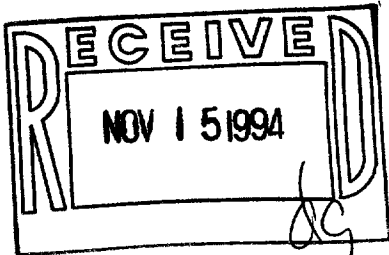

SCALE: 1" = 20 FEET



"I hereby certify that I have surveyed the above described property and that the above map is a true representation thereof and shows the size and location of the property, its exterior boundaries, the location of all visible structures and dimensions of all principal buildings thereon, boundary fences, apparent easements, roadways and visible encroachments, if any."

"This survey is made for the use of the present owners of the property, and also those who purchase, mortgage, or guarantee the title thereto within one year from date hereof."

Kenneth B. Abernathy, Jr.

KENNETH B. ABERNATHY, JR.
WISCONSIN REGISTERED LAND SURVEYOR,
S-1594

Date: 10-6-94 Job No. 94.1002