


PLAT OF SURVEY OF
Lot 9, Block 18, Lake Geneva Manor,
City of Lake Geneva, Walworth
County, Wisconsin, and residence
under construction on said Lot.

Harold H. Kolb, Wis. Surveyor, 9-187
DATE: October 14, 1963

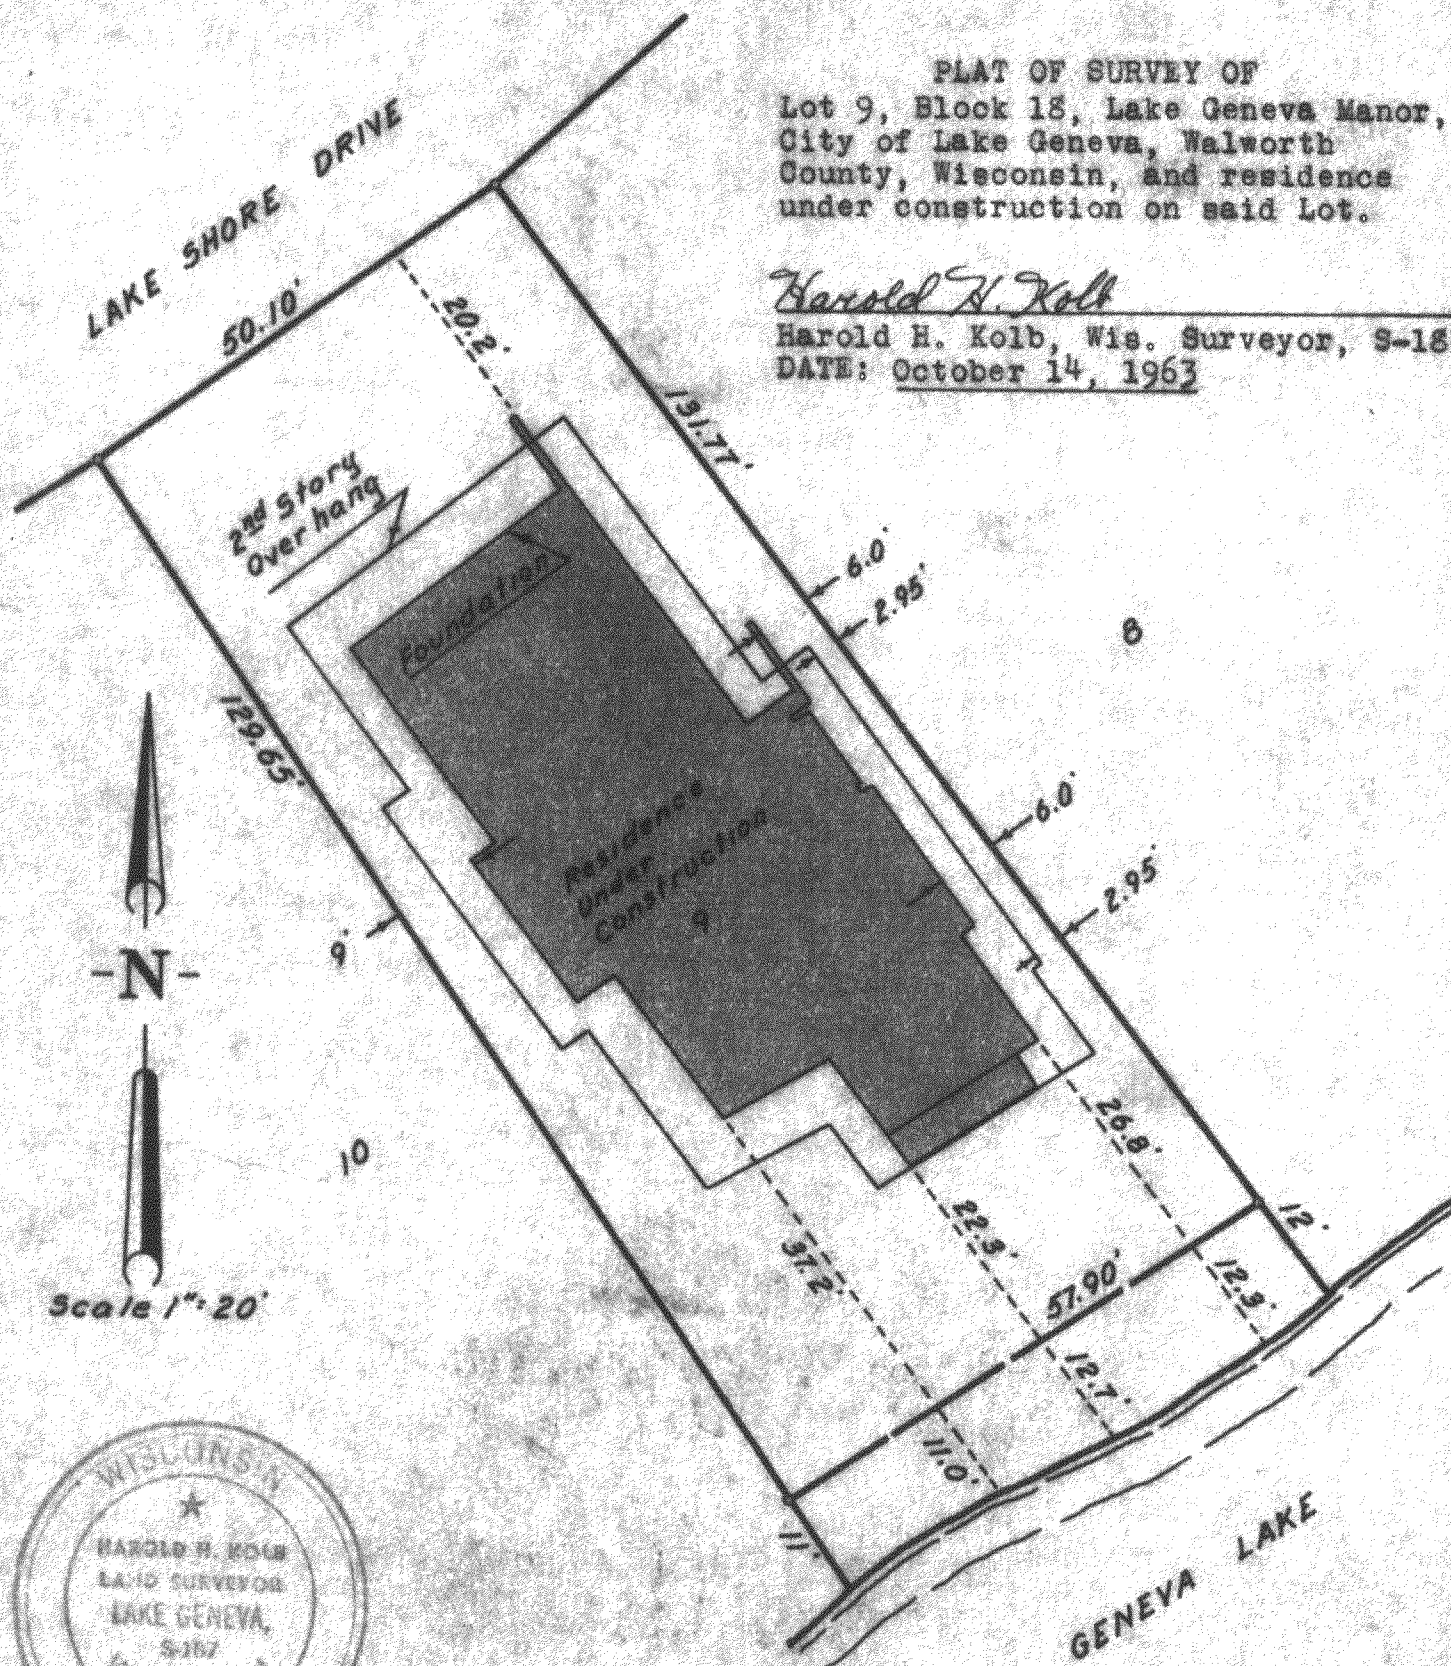

• Iron Pipe Found 7-153

46-103(B)

ZLM-40