


HAROLD H. KOLB
REGISTERED PROFESSIONAL LAND SURVEYOR
LAKE GENEVA, WISCONSIN

MILLER ROAD

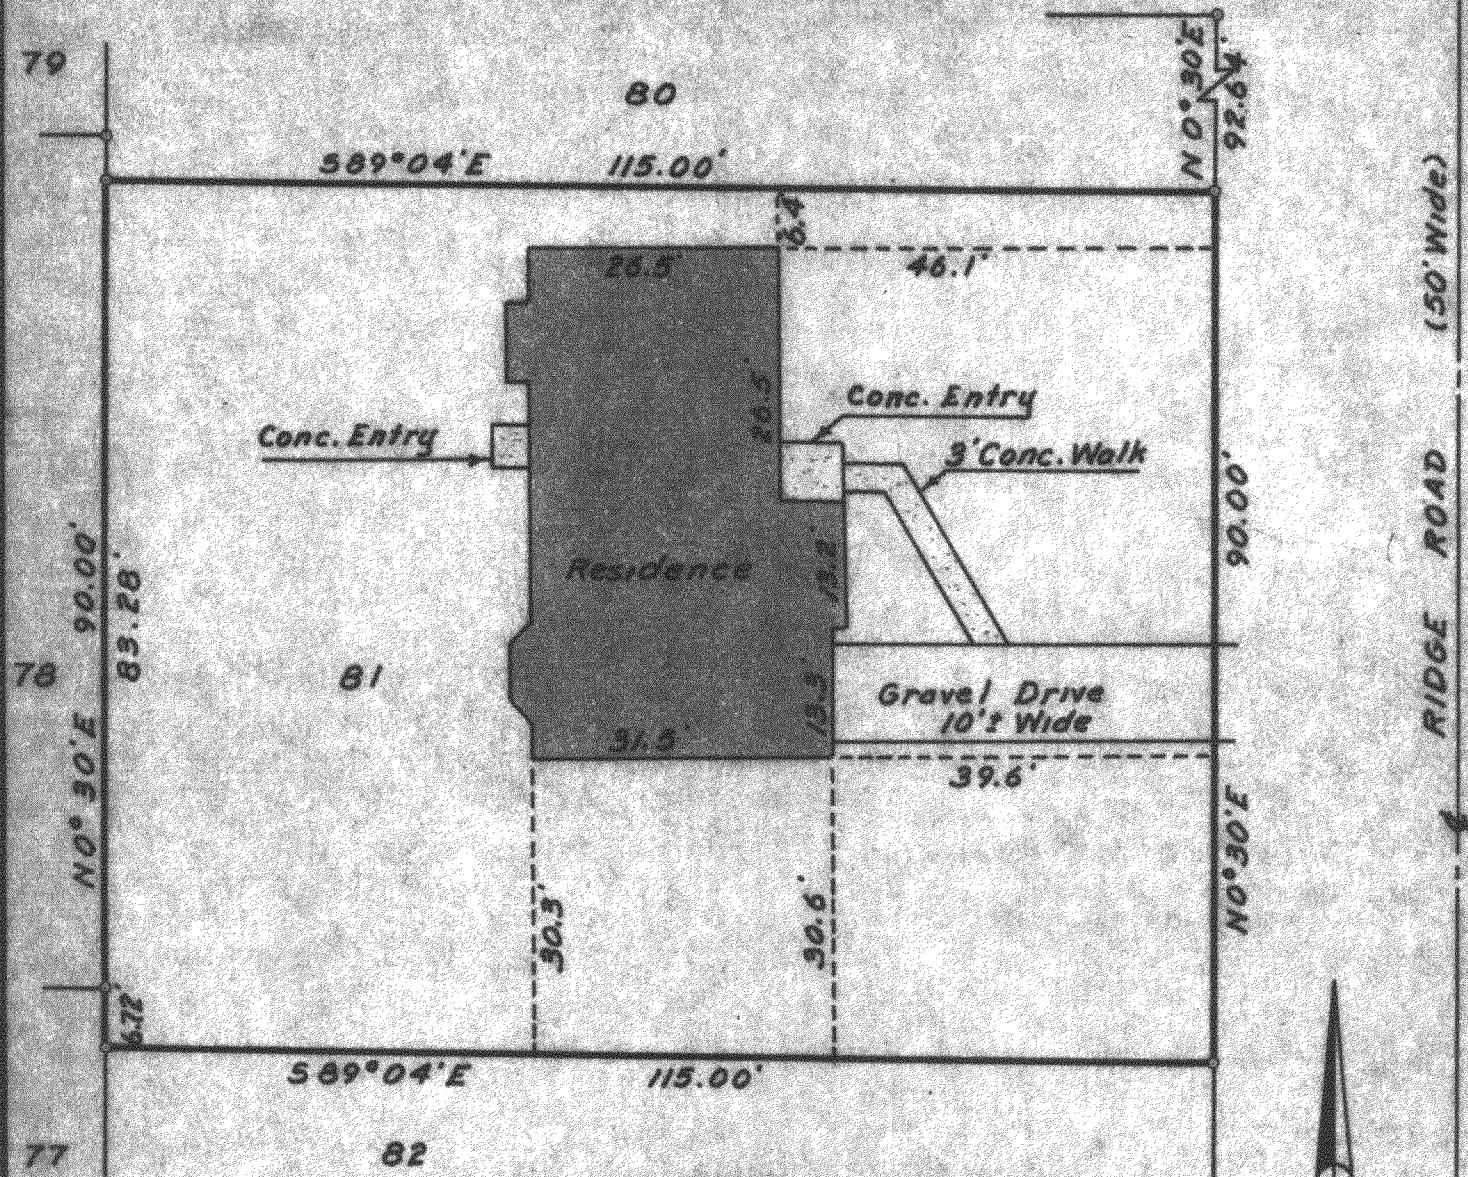

PLAT OF SURVEY OF

Lot 81, Sturwood Addition Number 3, City of Lake Geneva,
Walworth County, Wisconsin.

I, Harold H. Kolb, do hereby certify that I have surveyed
the property hereon described according to the official
records, and that the plat hereon is a correct representa-
tion of the lot lines and the principal line of the
buildings and other improvements thereon.

Harold H. Kolb

Harold H. Kolb, Wisconsin Surveyor, 3-187

DATE: October 7, 1963



Scale 1"=20'

ZST 3-17

7-154
o- Iron Pipe Found