


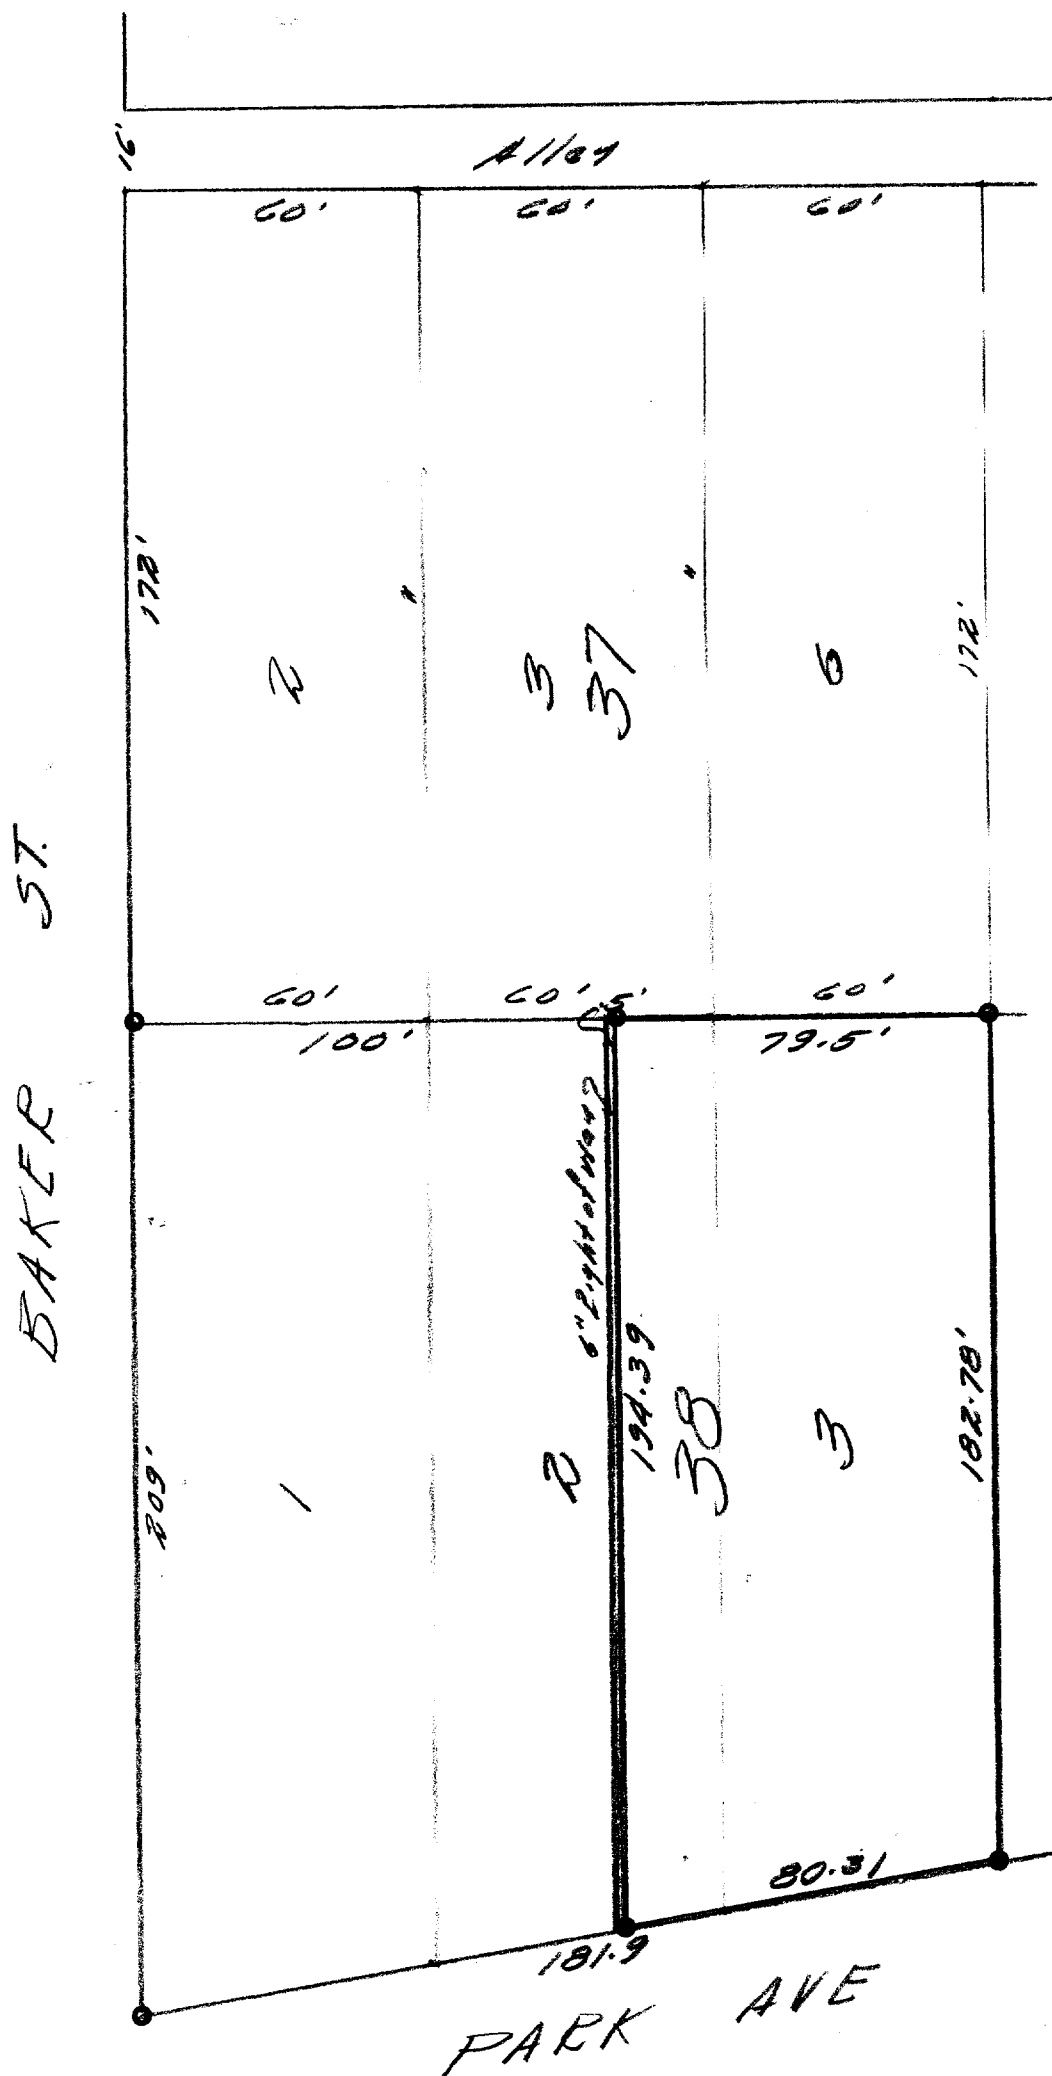

DESCRIPTION:

Commencing at a point 203 feet East of the N.E. corner of Lot 1, Block 38 of the Original Plat of the Village of Geneva now City of Lake Geneva, Walworth County, Wisconsin, and from said point of beginning 100 feet and six inches South of said point which shall be and is the starting point of this description, running thence South across Lots 3 and 6 of Block 37 to the South borderline of Lot 6 Block 37, which said line is parallel with the East borderline of said Lots 3 and 6 of said Block 37, running thence westerly along the south borderline of Lot 6 Block 37 and Lot 3 Block 38 to the Southwest corner of Lot 3 Block 38, running thence Northwesterly along the northwesterly borderline of Lots 3 and 2 Block 38 to a point within six inches of the Southwest corner of the land conveyed to one Fredrick W. Castle, his wife by deed dated August 7 1945., and recorder in the Office of the Register of Deeds in and for Walworth County, Wisconsin in Vol. 336 of Deeds on page 337; thence East to the starting point of this description;

CERTIFICATE:

I, hereby certify that I have on this the 24th day of June 1946, surveyed the above described property according to the official records on file in the office of the Recorder of Deeds in and for Walworth County, Wisconsin, and find that the measurement and bearings of the boundary lines of the property as taken on this day, substantially agree with those in the above description and that no encroachments exist.

SIGNED AND SEALED THIS 25TH DAY OF JUNE 1946.

Joseph M. Bisgi
Joseph M. Bisgi
Professional Engineer
Elkhorn Wisconsin.