


COPY

**WALWORTH COUNTY
SURVEYING & MAPPING**

P. O. BOX 1115
LAKE GENEVA, WISCONSIN
414-248-0505

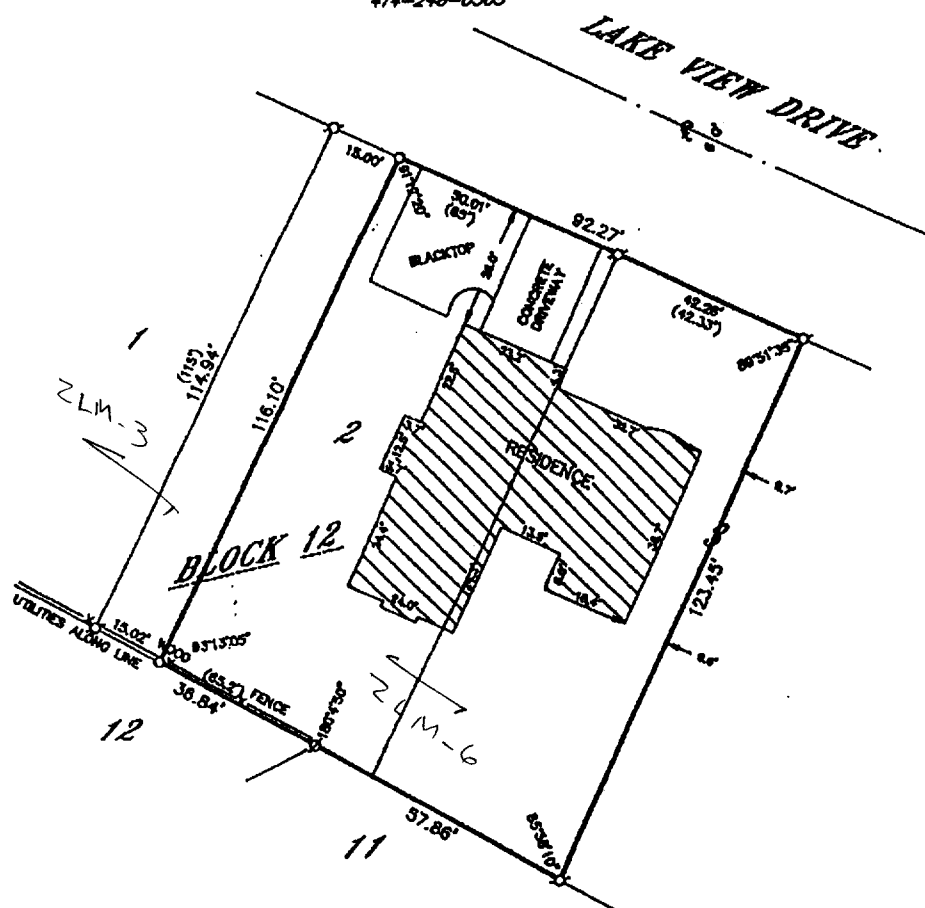

PLAT OF SURVEY OF

LOT 2, EXCEPTING THE WESTERLY 15 FEET THEREOF AND THE WESTERLY 42' 4" OF LOT 3, BLOCK 12 OF LAKE GENEVA MANOR, LOCATED IN THE CITY OF LAKE GENEVA, WALWORTH COUNTY, WISCONSIN.

ORDERED BY: KEEFE REAL ESTATE
704 MAIN STREET
LAKE GENEVA, WISCONSIN
53147

I HEREBY CERTIFY THAT I HAVE SURVEYED THE ABOVE DESCRIBED PROPERTY AND THAT THE ABOVE MAP IS A TRUE REPRESENTATION THEREOF AND SHOWS THE SIZE AND LOCATION OF THE PROPERTY, ITS EXTERIOR BOUNDARIES, THE LOCATION OF ALL VISIBLE STRUCTURES AND DIMENSIONS OF ALL PRINCIPAL BUILDINGS THEREON, BOUNDARY FENCES, APPARENT EASEMENTS, ROADS/PIES AND VISIBLE ENCHANCEMENTS, IF ANY, TO THE BEST OF MY KNOWLEDGE AND BELIEF.


THIS SURVEY IS MADE FOR THE USE OF THE PRESENT OWNERS OF
THE PROPERTY AND ALSO THOSE WHO PURCHASE, MORTGAGE OR
GUARANTEE THE TITLE HERETO WITHIN ONE (1) YEAR FROM DATE
HEREOF

Robert M. Baerenskiold
ROBERT M. BAERENSKILD
NEBRASKA REGISTERED LAND SURVEYOR, S-1508

REVISÉ: JULY 18, 1995

DATE 229 742 010-1

NOTE: THIS IS NOT A CERTIFIED COPY UNLESS SEALED.

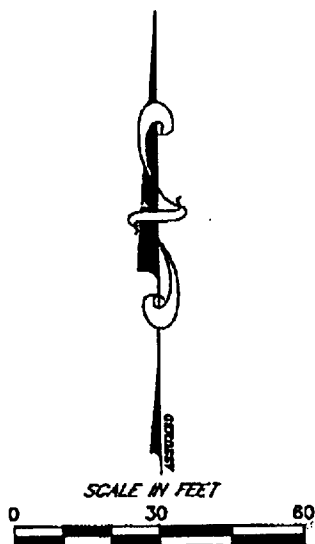

LEGEND

- X-IRON PIPE FOUND
 X-IRON ROD FOUND
 X-CONCRETE MONUMENT FOUND
 O-IRON PIPE PLACED
 O-RECORDED AS

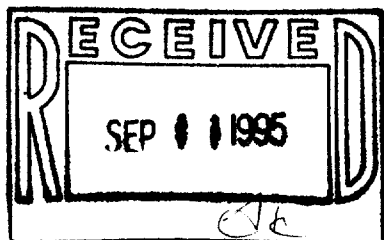


EXHIBIT A

TOTAL P.02

Donna K. Parker 007-1595

Notary Public, Walworth County, WI

My Commission: *expires 5-18-91*

ZLM-3
ZLM-6

THIS INSTRUMENT DRAFTED BY:
GODFREY, NESHEK, WORTH & LEIBSLE, S.C.
Elkhorn, Wisconsin

Names of persons signing in any capacity: _____