

PLAT OF SURVEY

OF

PARCEL "C" OF CERTIFIED SURVEY MAP NO. 641 FOR THE DIVISION OF LOTS 4 & 5, BLOCK 16 OF GENEVA LAKE CRAWFORD MANUFACTURING CO. ADDITION, LOCATED IN THE CITY OF LAKE GENEVA, WALWORTH COUNTY, WISCONSIN.

FOR: LAKES AREA BUILDERS

SCALE 1" = 20'

x = CROSS CUT IN CONCRETE

o = IRON PIPE STAKE FOUND.

PROPOSED BUILDING STAKED ON SITE.

⊗ = MASONRY NAIL SET


I have surveyed the above-described property, and the map hereon is a true representation thereof and shows the size and location of the property, its exterior boundaries, the location and dimensions of all visible structures thereon, fences, apparent easements and roadways and visible encroachments, if any.

This survey is made for the exclusive use of the present owners of the property, and also those who purchase, mortgage, or guarantee the title thereto, within one year from date hereof,

Dated at Burlington, this 11th day of JANUARY, 1984

John F. Degen
John F. Degen, Land Surveyor S 242

REVISED 3-19-84 TO
SHOW FOUNDATION LOCATION.
RE-SURVEYED 10-12-95

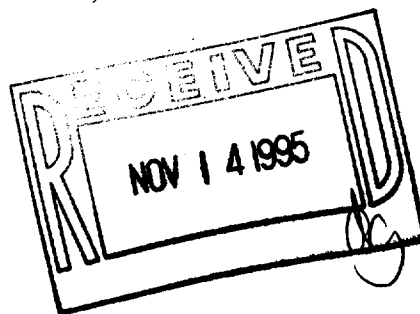

GRAVEL DRIVE
IS ALSO USED
BY ADJOWNER
ON NORTH FOR
GARAGE ACCESS

