


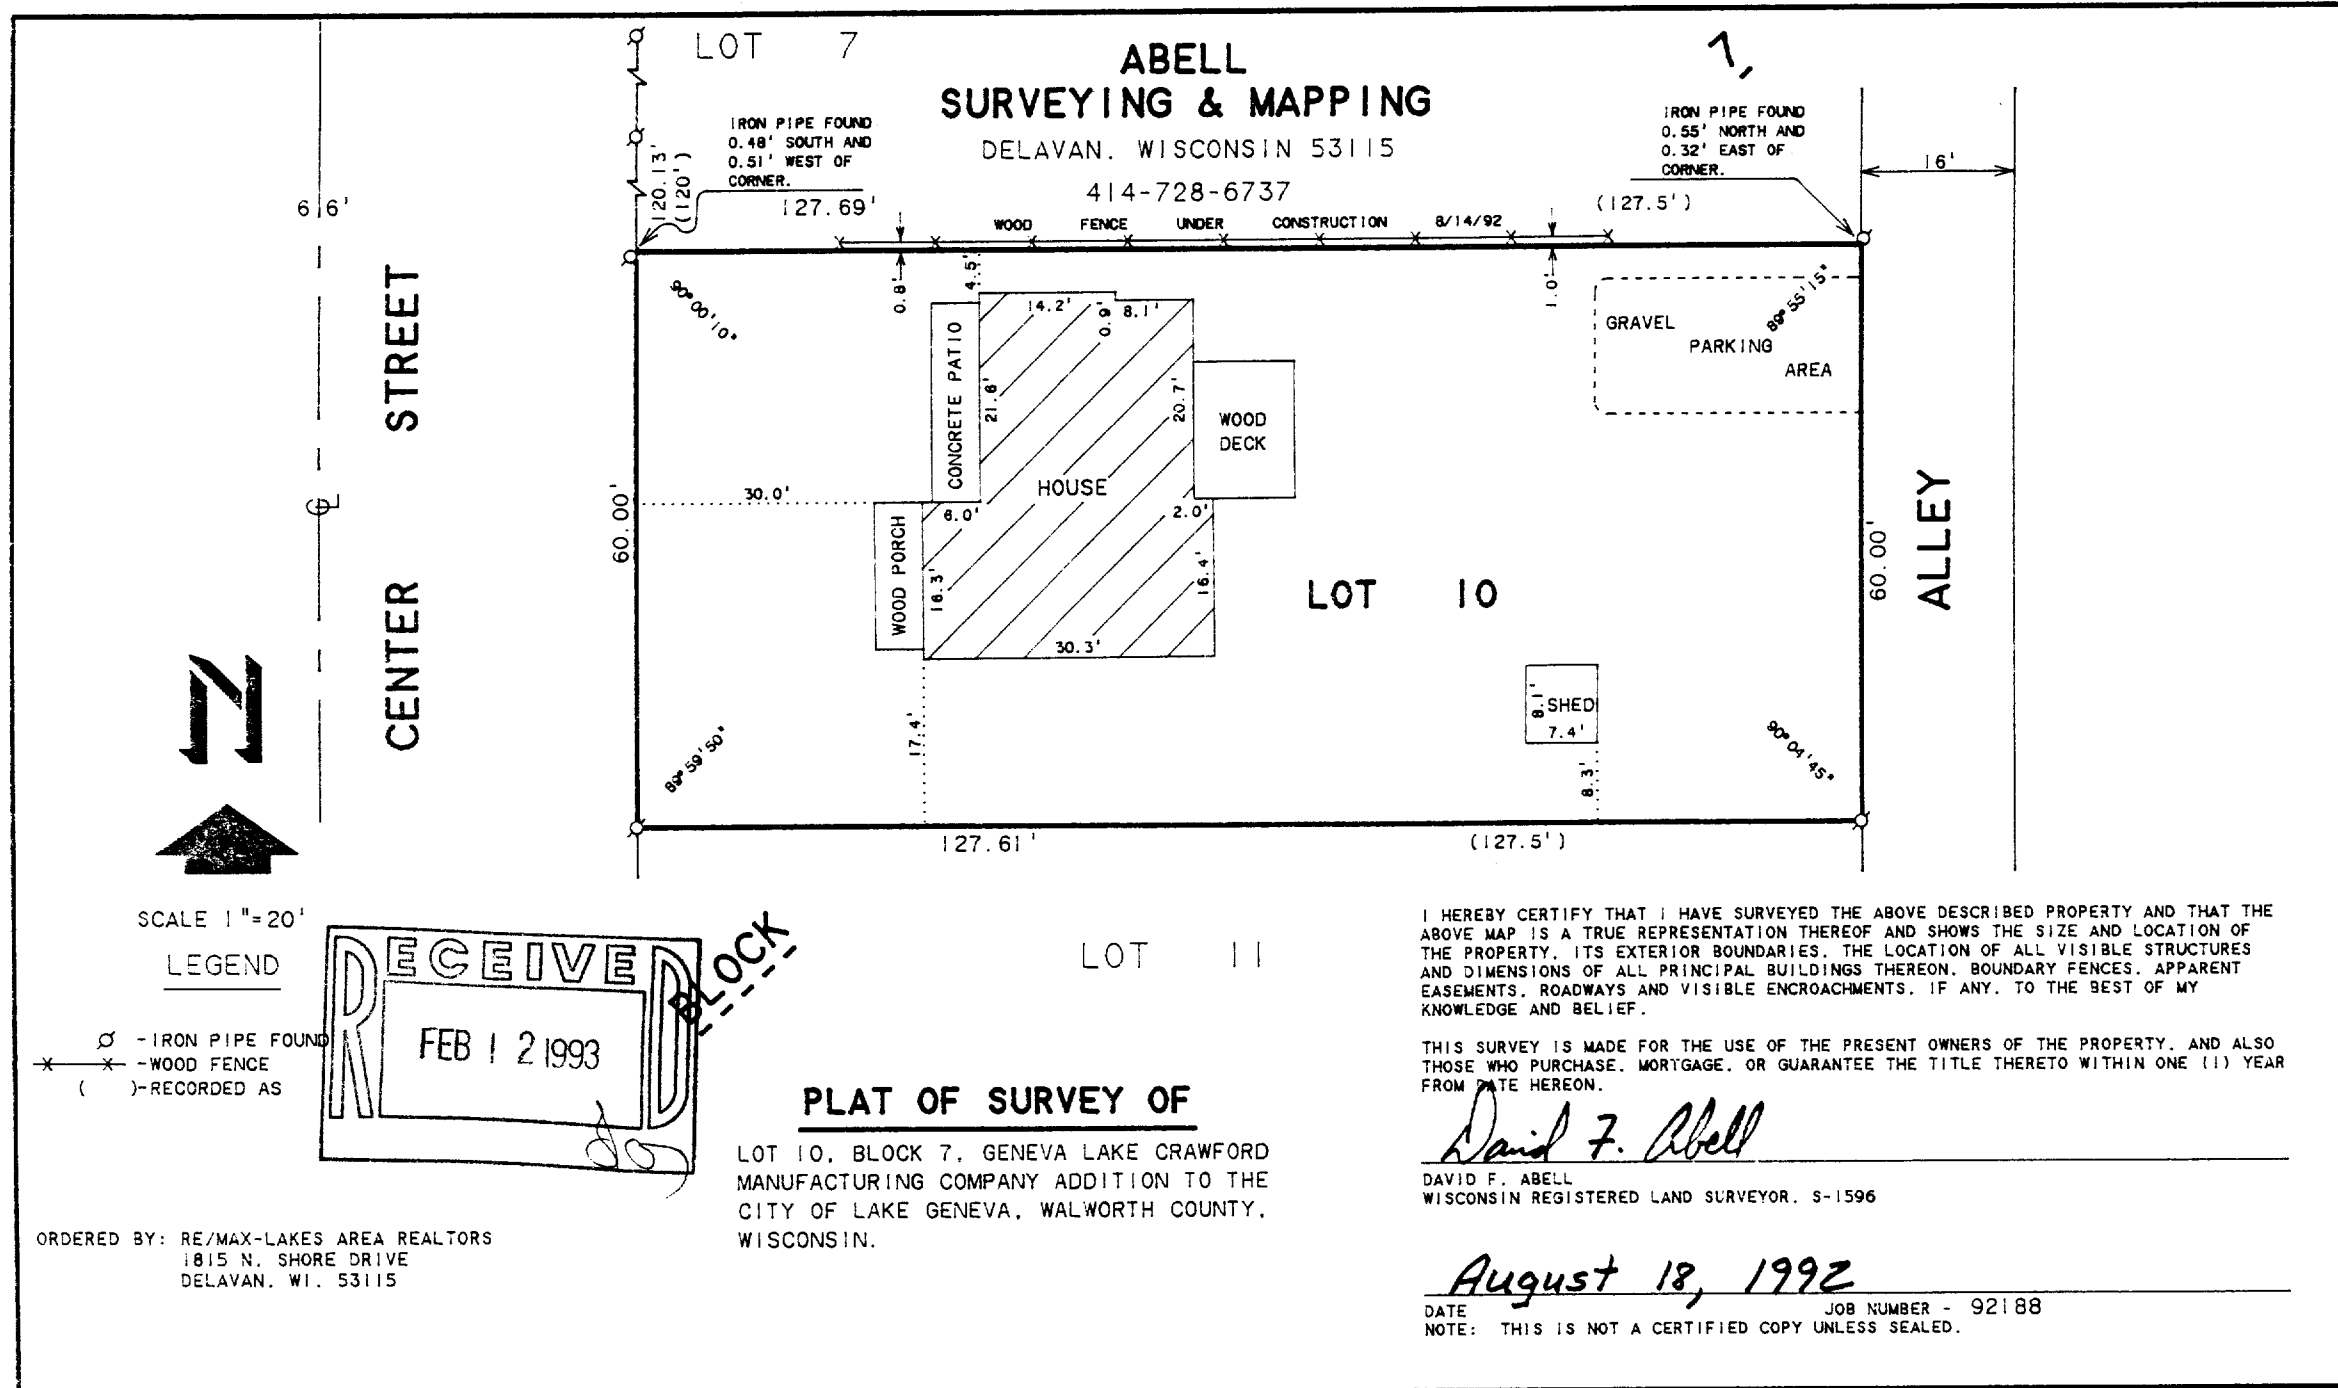

ZGC-2.2.

007-1617