


PLAT OF SURVEY


Lot 129 of Sturwood Addition Number 6 Subdivision,
located in part of the Northeast 1/4 of Section 35,
Town 2 North, Range 17 East, City of Lake Geneva,
County of Walworth, State of Wisconsin.

Ordered by: Attorney Robert C. Leibsle
Godfrey, Neshek, Worth, & Leibsle SC
11 North Wisconsin Street
Elkhorn, Wisconsin 53121


Owner: Kikkoman Foods, Inc.
Post Office Box 69
Walworth, Wisconsin 53184-0069

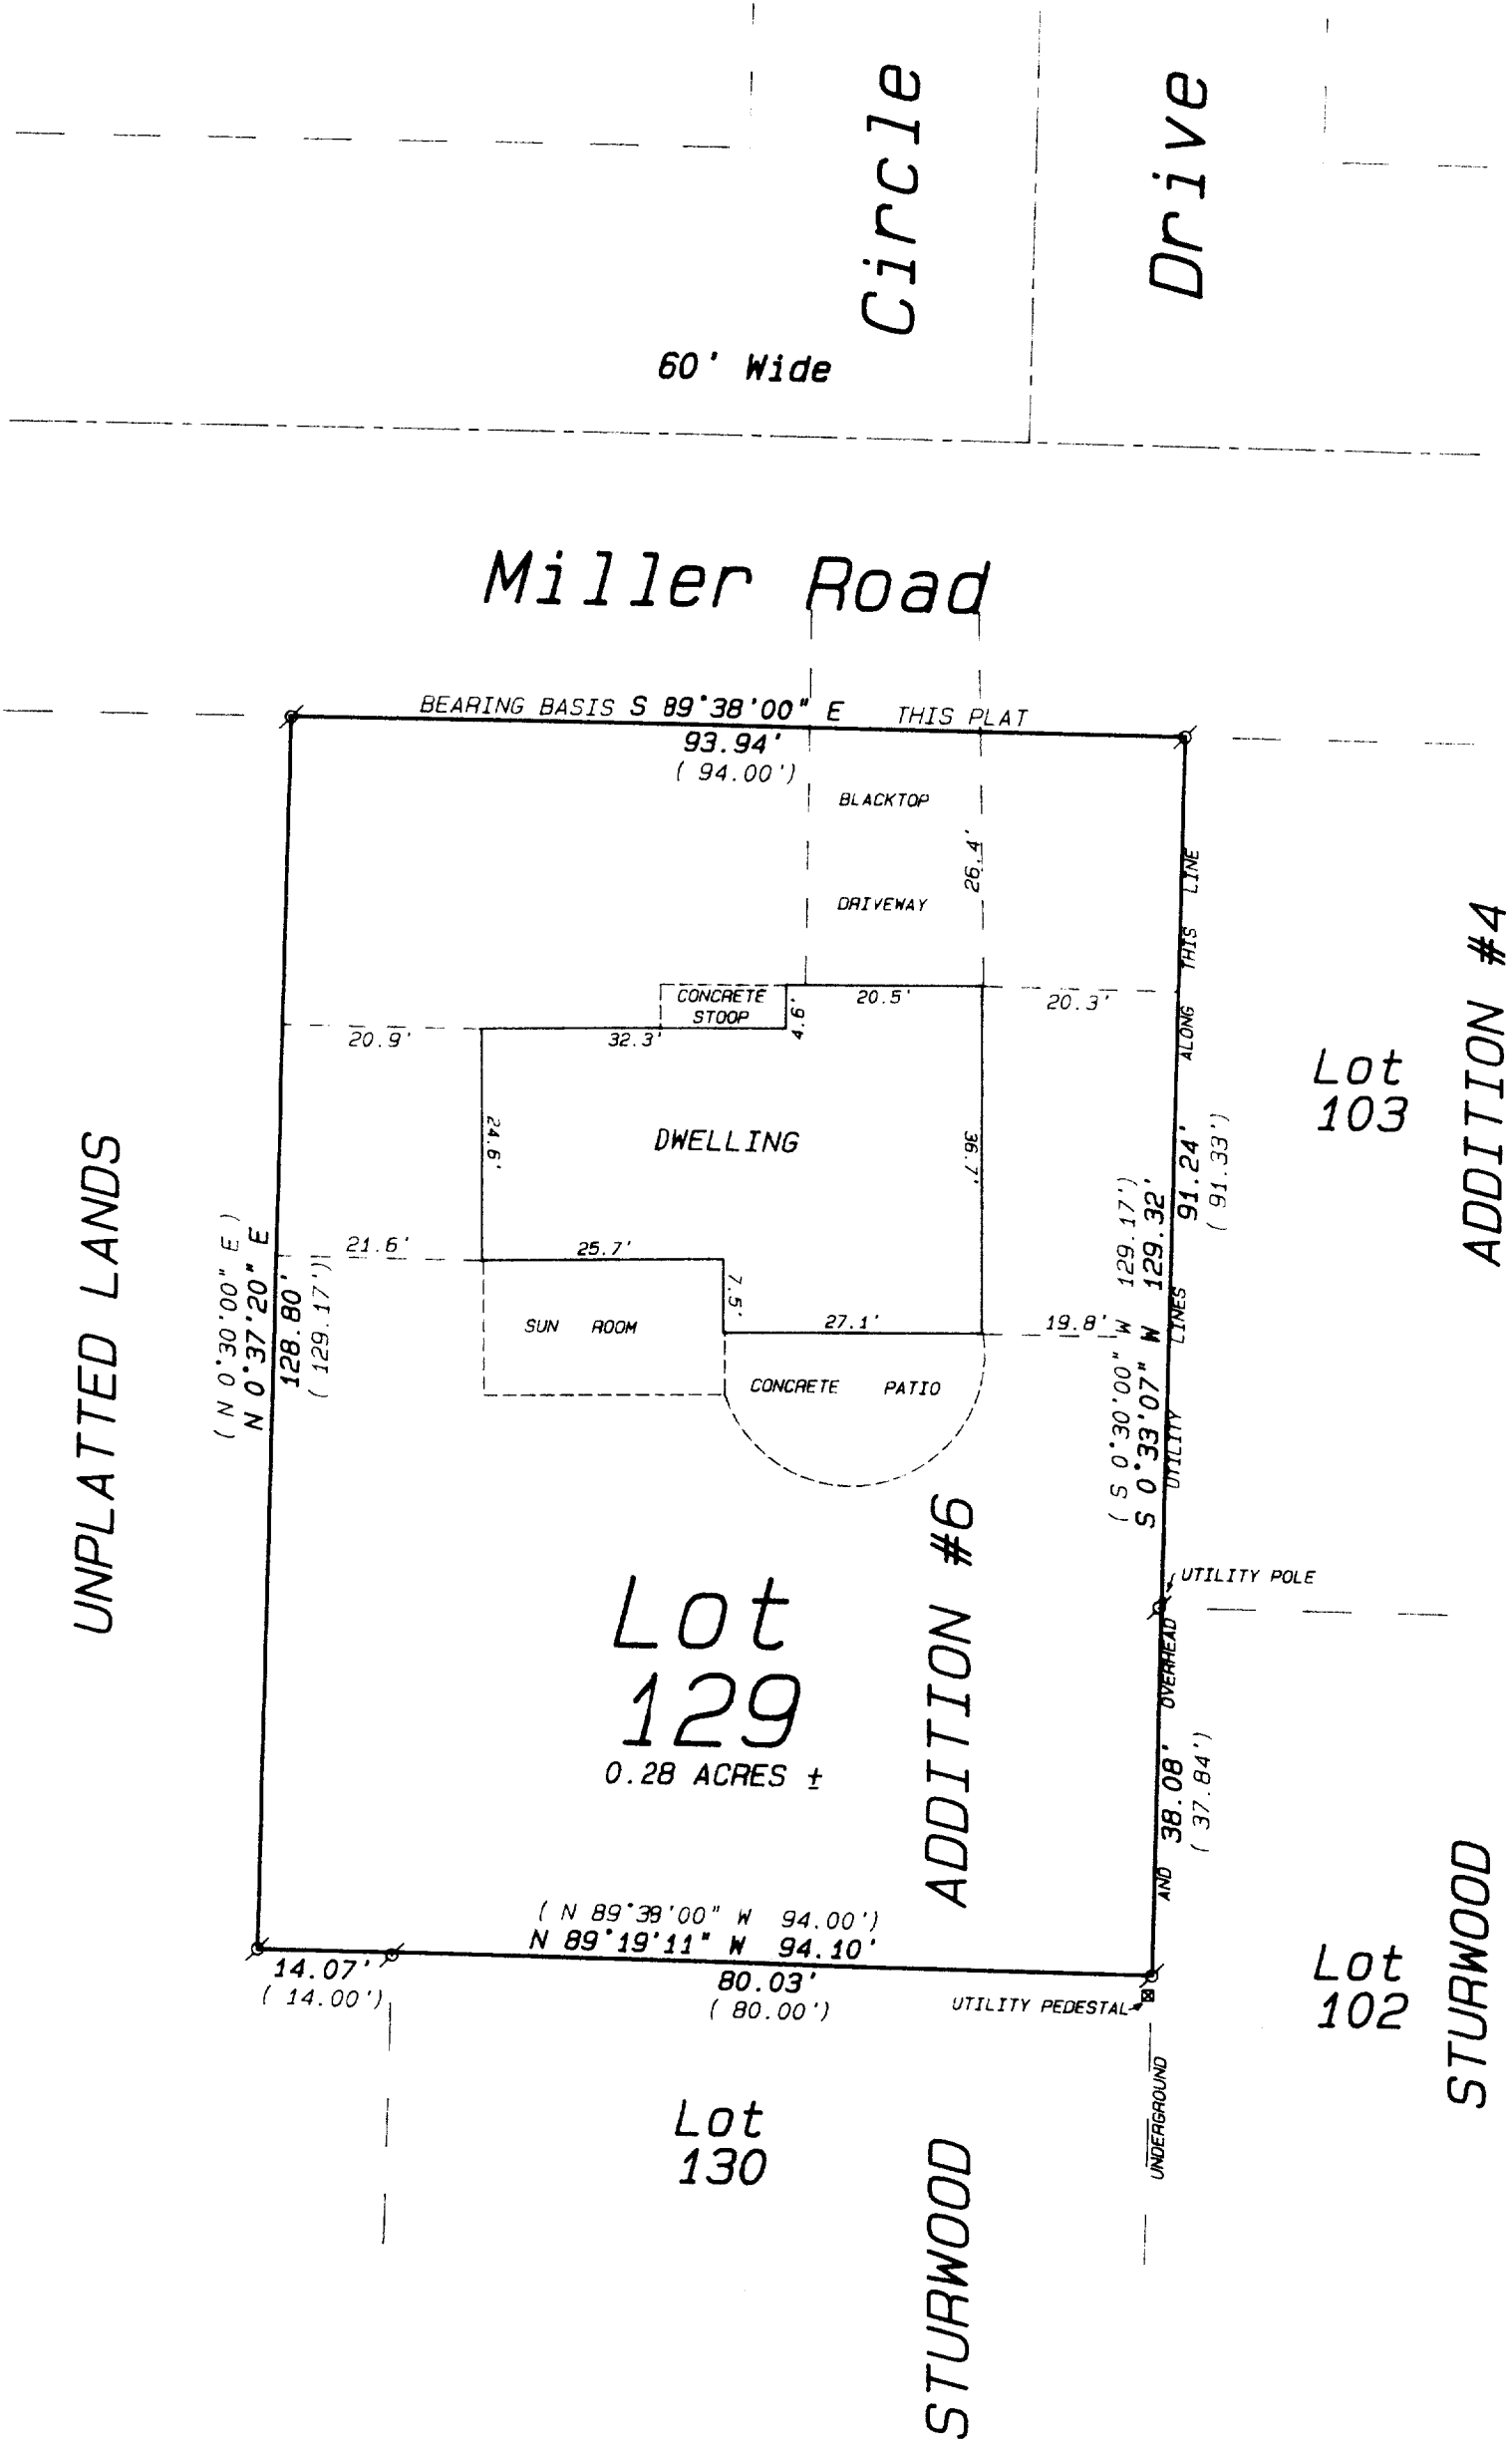

- Legend
- FOUND IRON PIPE
 - FOUND IRON ROD
 - FOUND BRASS CAPPED MONUMENT
 - FOUND CONCRETE MONUMENT
 - CHISEL CUT IN CONCRETE
 - SET IRON ROD, 24" LONG, WEIGHING 1.5 LBS., LINEAL FT., 3/4" DIA.
 - SET IRON ROD, 30" LONG, WEIGHING 4.5 LBS., LINEAL FT., 1 1/16" DIA.
 - RECORDED AS DIMENSION
 - EXISTING FENCE

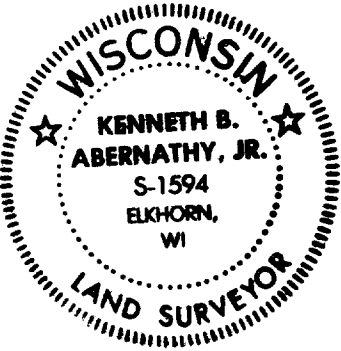

SCALE: 1"= 20 FEET

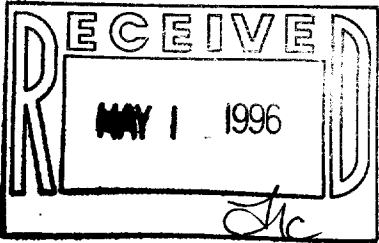

"I hereby certify that the above described property has been surveyed by me or under my direction and that the above map is a true representation thereof and shows the size and location of the property, its exterior boundaries, the location of all visible structures and dimensions of all principal buildings thereon, boundary fences, apparent easements, roadways and visible encroachments, if any."

"This survey is made for the use of the present owners of the property and also those who purchase, mortgage, or guarantee the title thereto within one year from date hereof."

Kenneth B. Abernathy, Jr.

KENNETH B. ABERNATHY, JR.
WISCONSIN REGISTERED LAND SURVEYOR,
S-1594

Date: April 15, 1996 Job No. 1996.404

ZST6-8

007-1641