


HAROLD H. KOLB
REGISTERED PROFESSIONAL LAND SURVEYOR
LAKE GENEVA, WISCONSIN

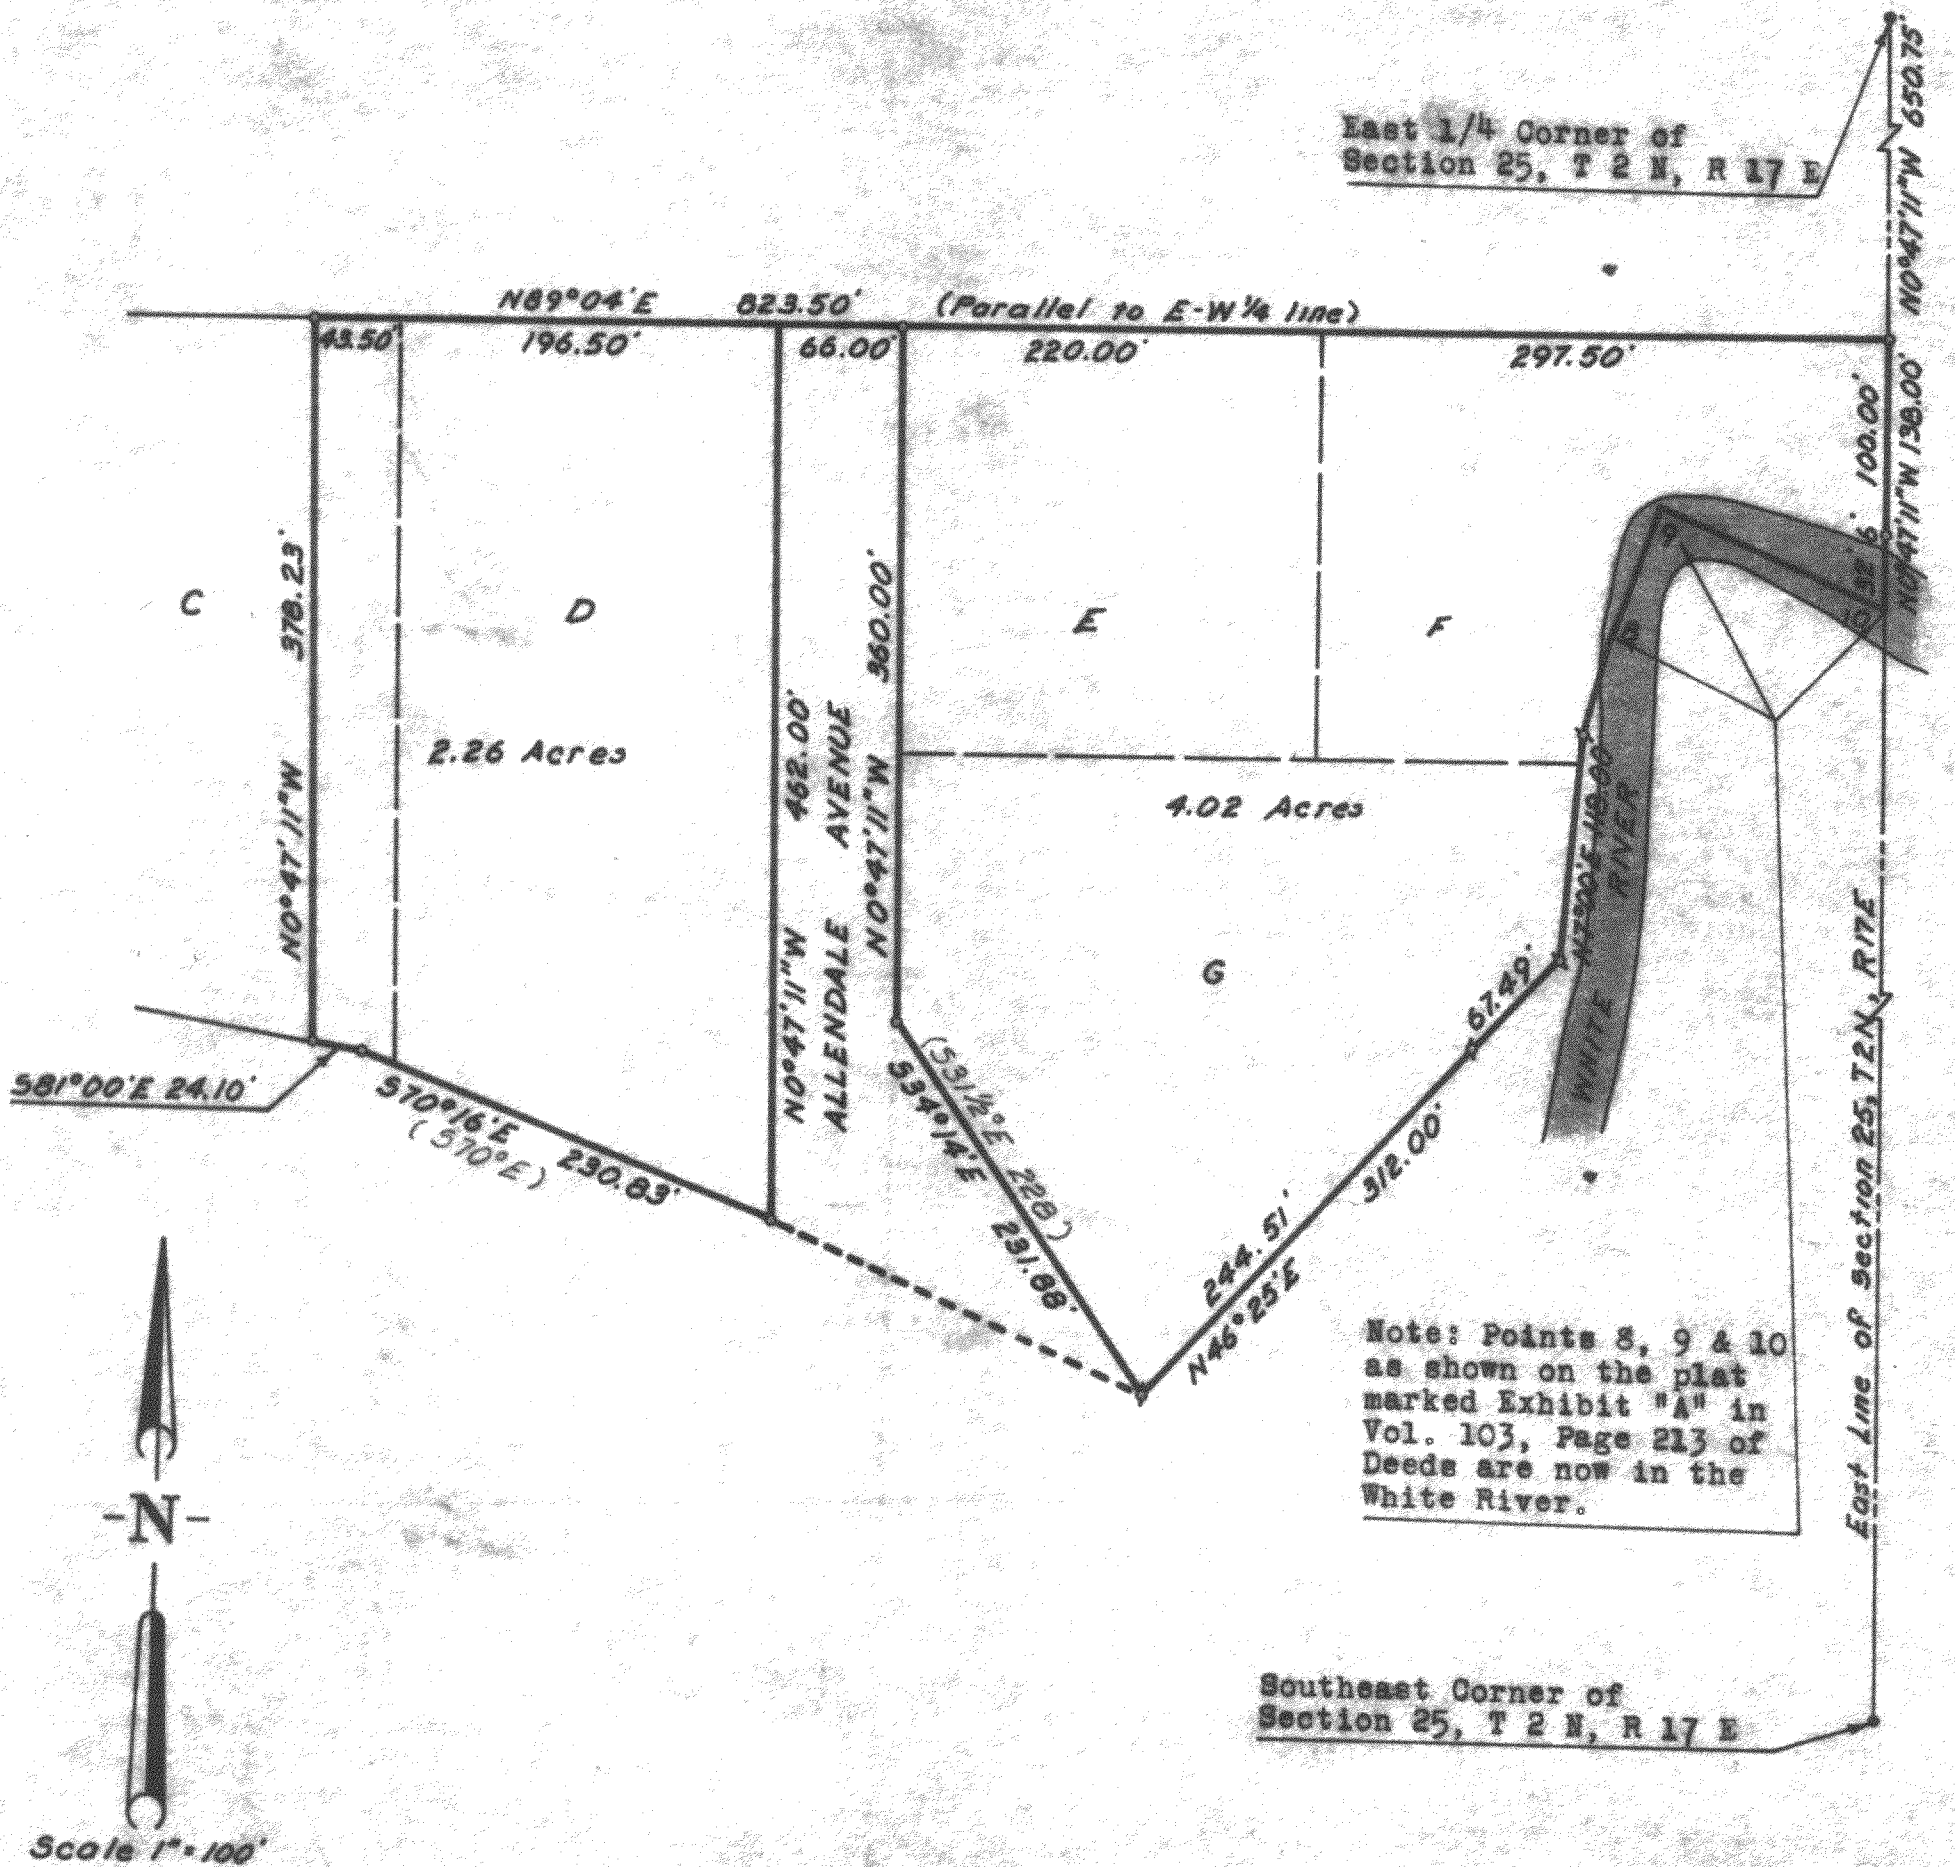

PLAT OF SURVEY OF

The East 43.50 feet of Lot C, Lots D, E, F and G of Geneva Lake Crawford Manufacturing Company's Addition to the Village (Now City) of Lake Geneva, Walworth County, Wisconsin.

Harold H. Kolb

Harold H. Kolb, Wisconsin Surveyor, S-187
DATE: March 26, 1964

- (1') Plotted distance or bearing
- Concrete Monument Found
 - Iron Pipe Found
 - Iron Pipe Placed

GC-45

7-166