



Plat of Survey

THE SOUTH 1/2 OF LOT 6 IN BLOCK 15
RANGE 17 EAST, IN THE CITY OF LAKE GENEVA, WALWORTH COUNTY, WISCONSIN.

OCTOBER 22, 1996

FIRSTAR DEVELOPMENT CORPORATION

SURVEY NO. 157444-MS

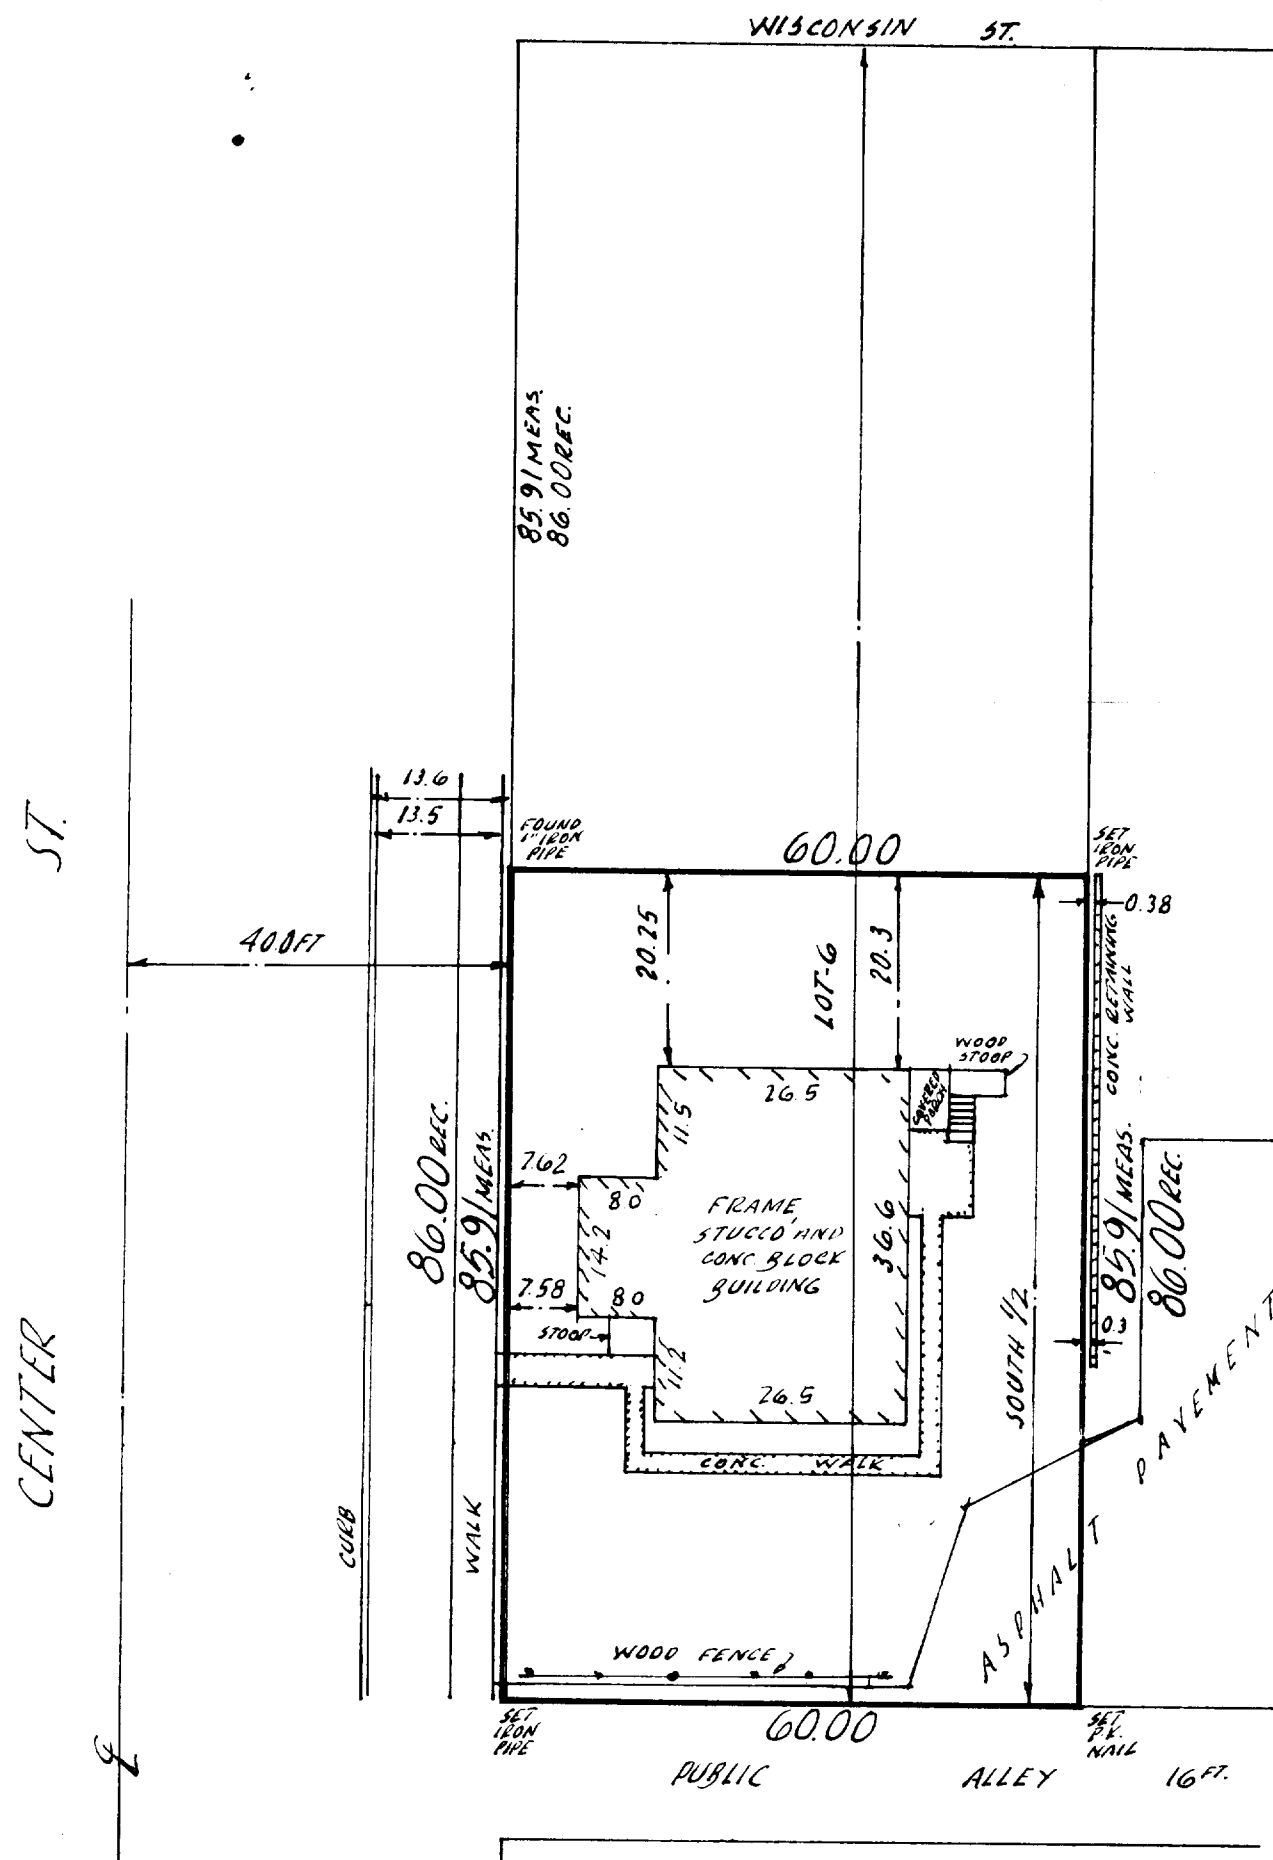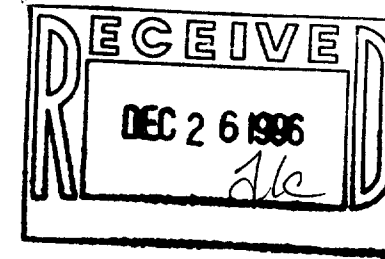

SCALE: 1" = 20'

National Survey & Engineering

4125 North 124th Street
Brookfield, Wisconsin 53005-1837
Phone 414-781-1000
Fax 414-781-8466
1-800-842-7831

I certify that I have surveyed the above described property (Property), and the above map is a true representation thereof and shows the size and location of the Property, its exterior boundaries, the location and dimensions of all visible structures thereon, boundary fences, apparent easements and roadways and visible encroachments, if any.

This survey is made for the exclusive use of the present owners of the Property, and also those who purchase, mortgage, or guarantee the title thereto, within one (1) year from date hereof.

A circular professional seal for a Wisconsin Land Surveyor. The outer ring contains the text "WISCONSIN" at the top and "LAND SURVEYOR" at the bottom, separated by two five-pointed stars. The center of the seal contains the text "DONALD C. CHAPUT", "S-1316", and "BROOKFIELD, WI" stacked vertically. The seal is stamped in black ink on a white background.

007-1465

ZOP-139