


HAROLD H. KOLB  
REGISTERED PROFESSIONAL LAND SURVEYOR  
LAKE GENEVA, WISCONSIN

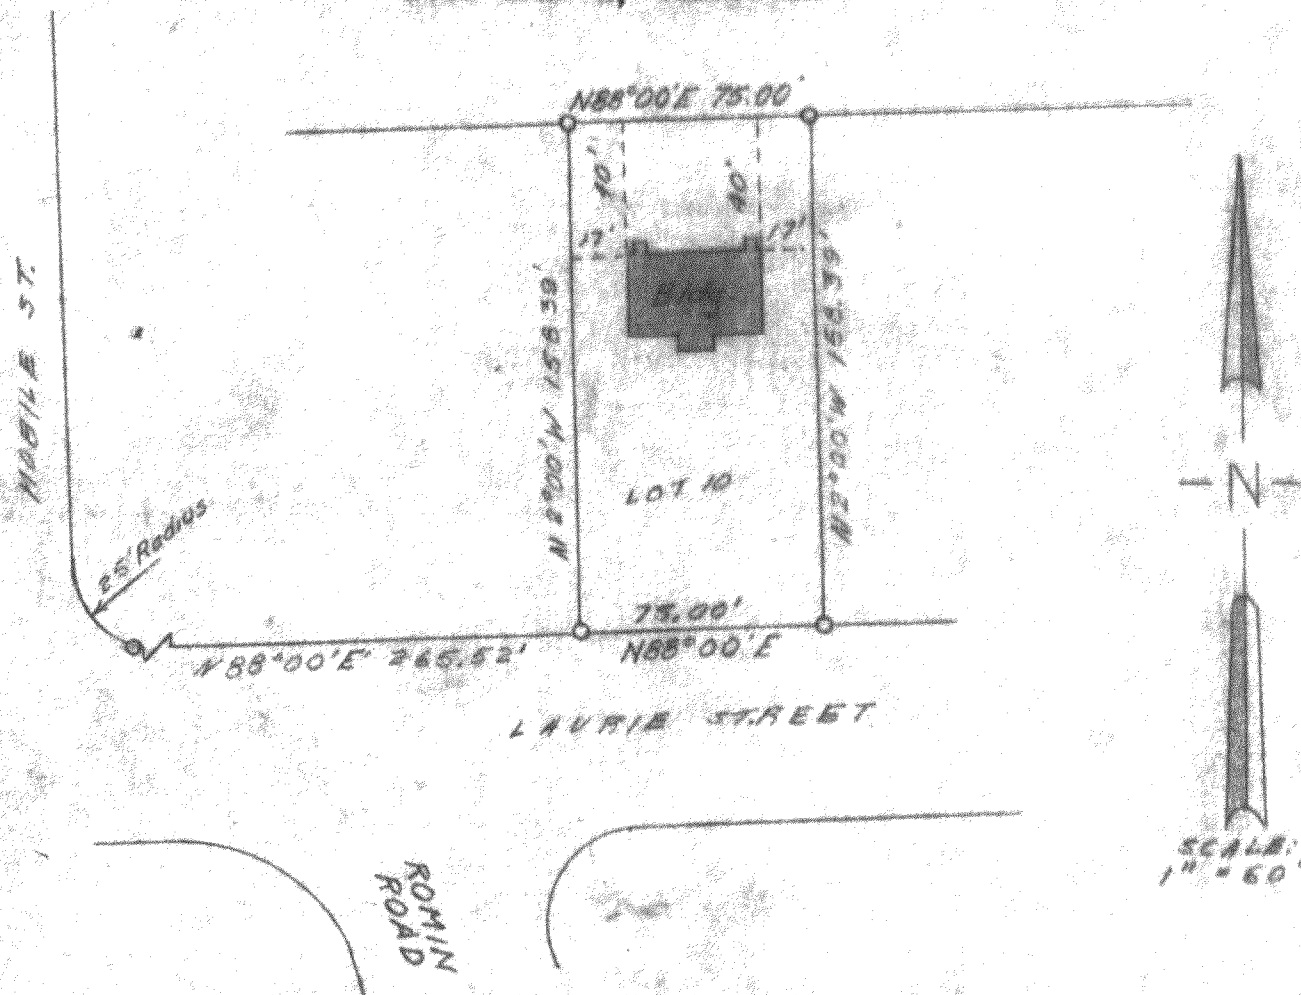

PLAT OF SURVEY OF

Lot 10, Dun-Romin Acres, a subdivision located in the City of Lake Geneva, Walworth County, Wisconsin.

State of Wisconsin) ss  
County of Walworth)

I, Harold H. Kolb, do hereby certify that I have surveyed the property hereon described according to the official records, and that the plat hereon is a correct representation of the lot lines and the principal lines of the buildings thereon.

DATE: May 25, 1964

Harold H. Kolb  
Harold H. Kolb, S-187  
Wisconsin Registered Surveyor

o Iron Pipe Found

20A-10

7-11A

16-B