



WALWORTH COUNTY SURVEYING & MAPPING

P. O. BOX 1115
LAKE GENEVA, WISCONSIN
414-248-0505


PLAT OF SURVEY OF

THE NORTH 72 FEET OF LOT 9 IN BLOCK 14
IN GENEVA LAKE CRAWFORD MANUFACTURING
COMPANY'S ADDITION TO THE VILLAGE OF
GENEVA (NOW CITY OF LAKE GENEVA),
WALWORTH COUNTY, WISCONSIN, ACCORDING
TO THE PLAT OF SAID ADDITION OF RECORD
IN THE OFFICE OF THE REGISTER OF DEEDS
IN AND FOR SAID COUNTY OF WALWORTH.

ORDERED BY: CONELL & WILSON
415 BROAD STREET
LAKE GENEVA, WISCONSIN
53147

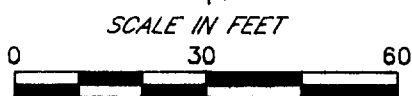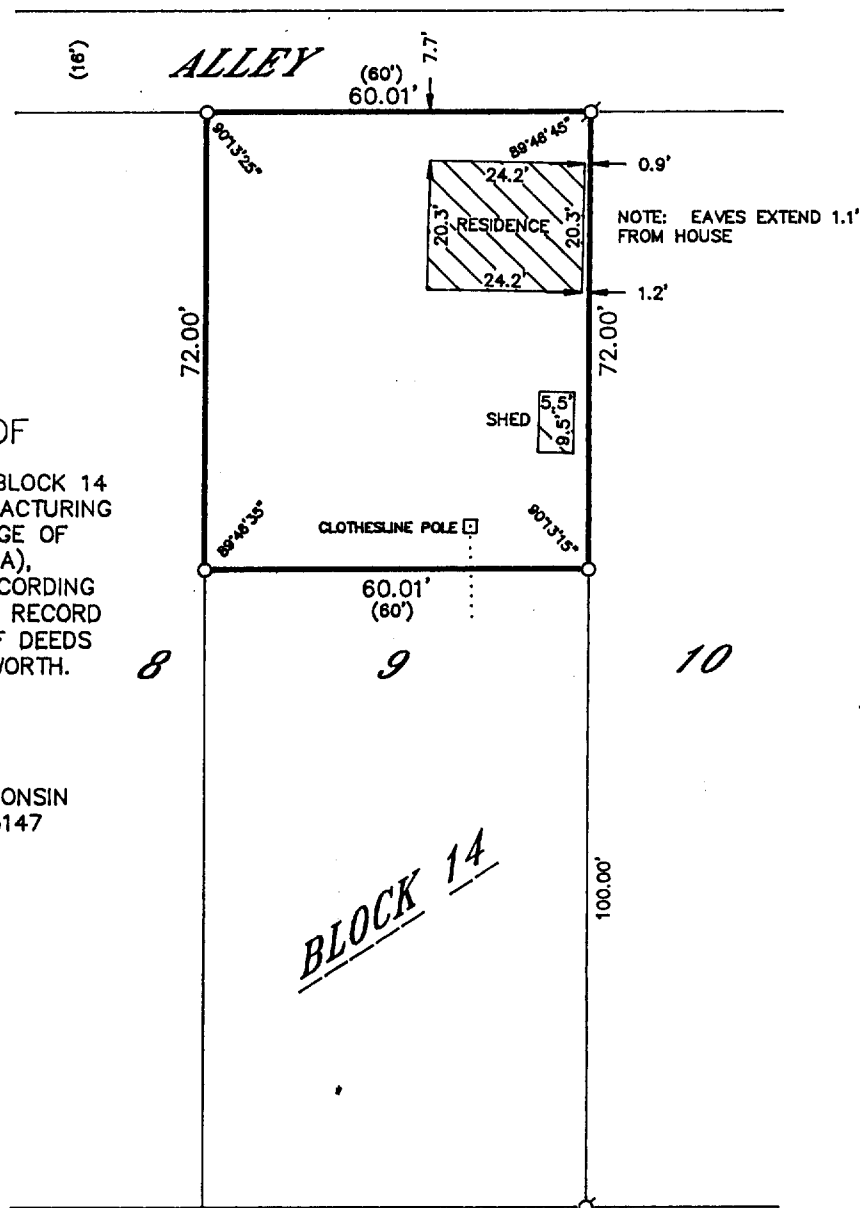

LEGEND
 O-IRON PIPE FOUND
 X-IRON ROD FOUND
 ■-CONCRETE MONUMENT FOUND
 ○-IRON PIPE PLACED
 ()-RECORDED AS

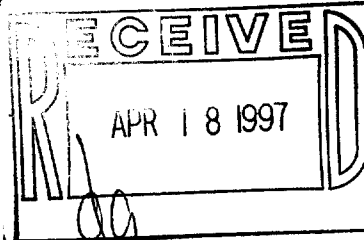

I HEREBY CERTIFY THAT I HAVE SURVEYED THE ABOVE DESCRIBED PROPERTY AND THAT THE ABOVE MAP IS A TRUE REPRESENTATION THEREOF AND SHOWS THE SIZE AND LOCATION OF THE PROPERTY, ITS EXTERIOR BOUNDARIES, THE LOCATION OF ALL VISIBLE STRUCTURES AND DIMENSIONS OF ALL PRINCIPAL BUILDINGS THEREON, BOUNDARY FENCES, APPARENT EASEMENTS, ROADWAYS AND VISIBLE ENCROACHMENTS, IF ANY, TO THE BEST OF MY KNOWLEDGE AND BELIEF.

THIS SURVEY IS MADE FOR THE USE OF THE PRESENT OWNERS OF THE PROPERTY AND ALSO THOSE WHO PURCHASE, MORTGAGE OR GUARANTEE THE TITLE THERETO WITHIN ONE (1) YEAR FROM DATE HEREOF.

Robert M. Baerenwald
 ROBERT M. BAERENWALD
 WISCONSIN REGISTERED LAND SURVEYOR, S-1508

May 30, 1996
 DATE JOB NO. 5070

NOTE: THIS IS NOT A CERTIFIED COPY UNLESS SEALED.

ZGC-60
 007-1692