


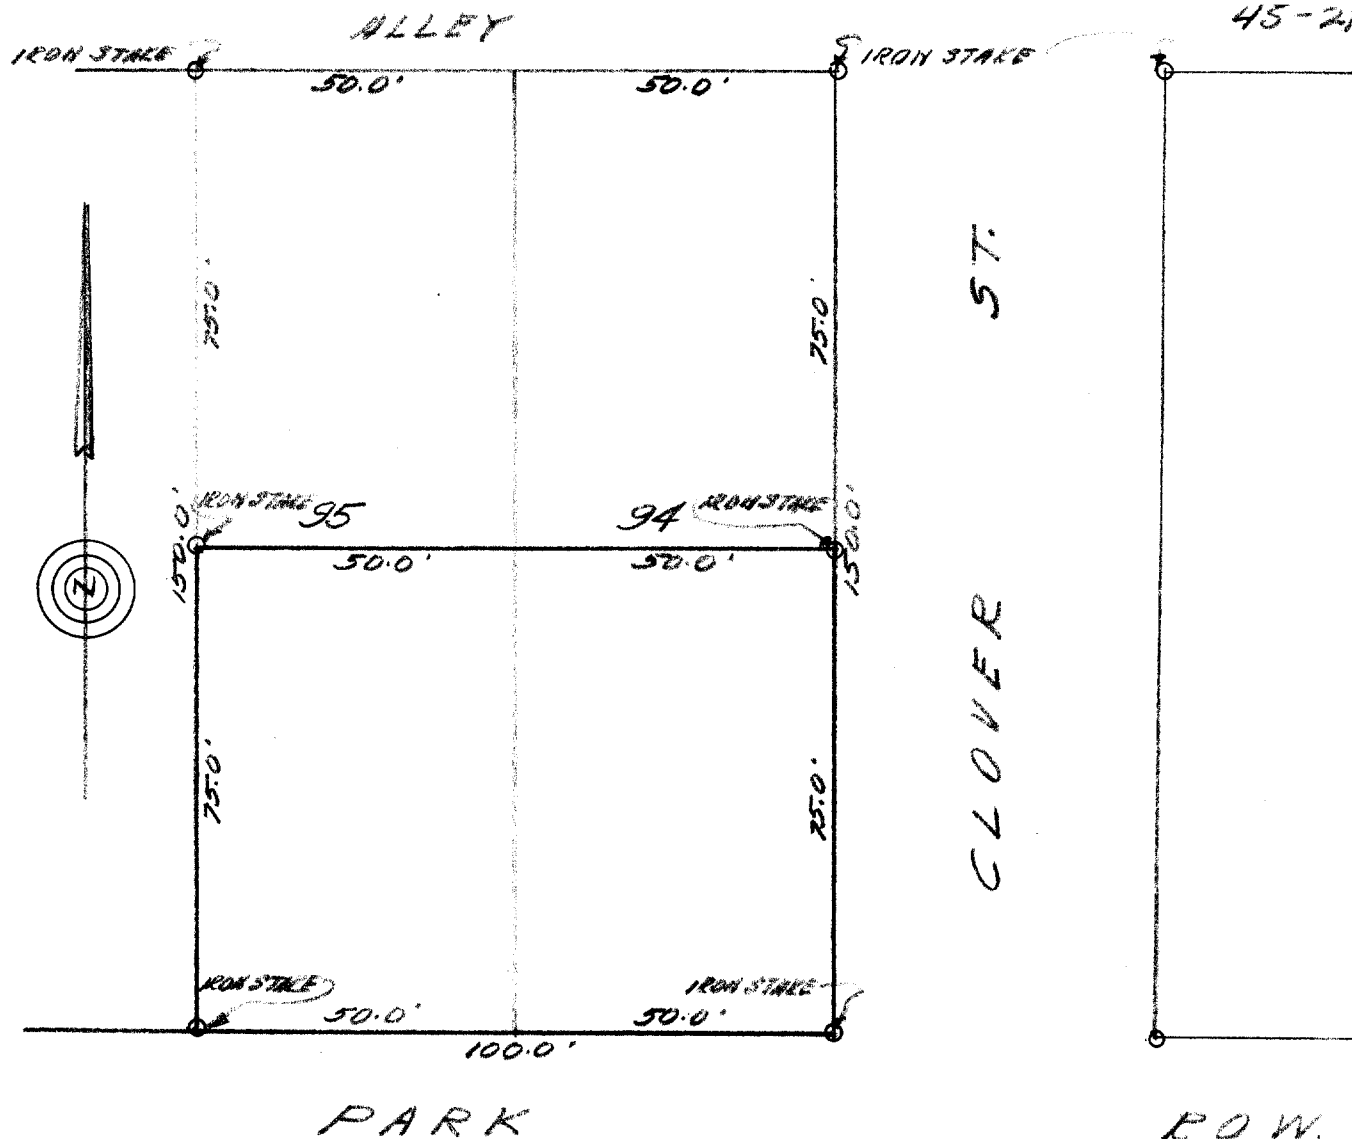

DESCRIPTION:

The south one half of Lots 94 and 95 Columbian Subdivision of a portion of the Village (now city) of Lake Geneva Wisconsin.

CERTIFICATE:

I, hereby certify that I have on this the 12th day of May 1945 surveyed the above described property according to the official records on file in the office of the Recorder of Deeds in and for Walworth County, Wisconsin, and find that no encroachments exist, and that the plat hereon portrayed is an exact representation of the conditions found at the site on this day.

SIGNED AND SEALED THIS 14th DAY OF MAY 1945.

Joseph M. Biagi Professional Eng

7-46B

CL-76A