


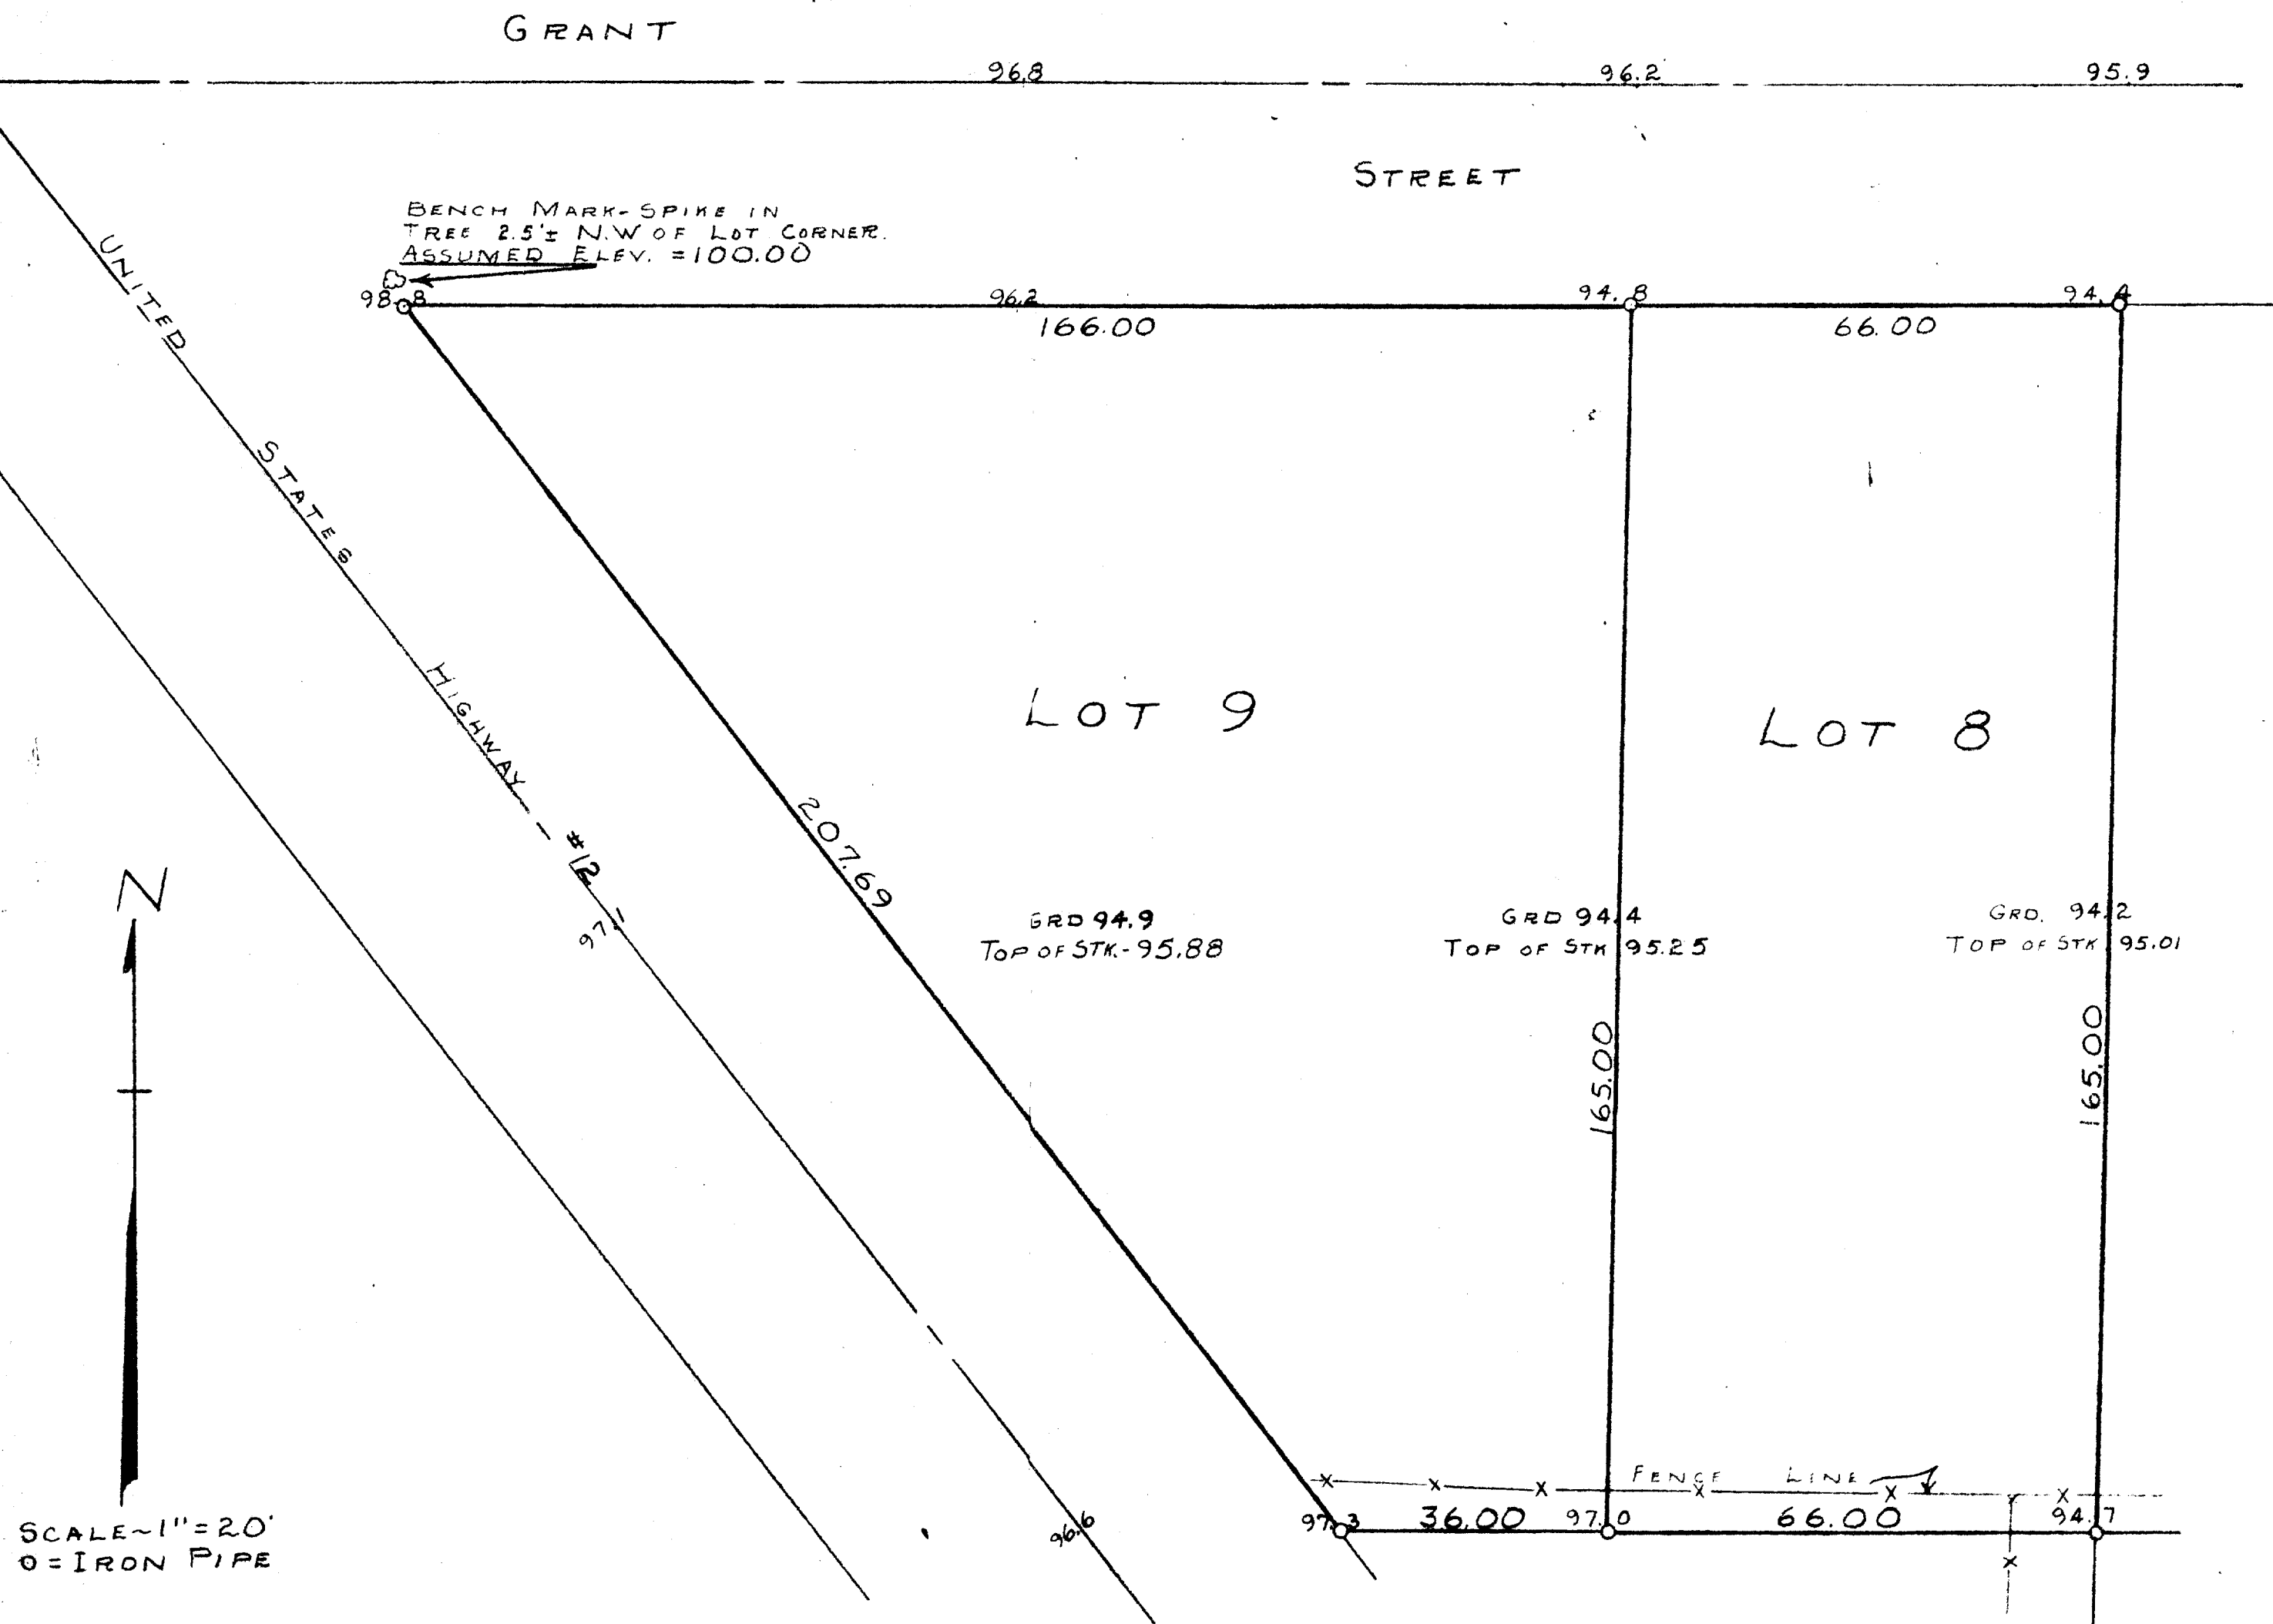

PLAT OF SURVEY OF LOTS 8 AND 9 OF BLOCK 3 IN
WHEELERS ADDITION LOCATED IN THE CITY OF LAKE GENEVA,
WALWORTH COUNTY, WISCONSIN
DECEMBER 29, 1952

George T. Dunham
SURVEYOR

7-17