


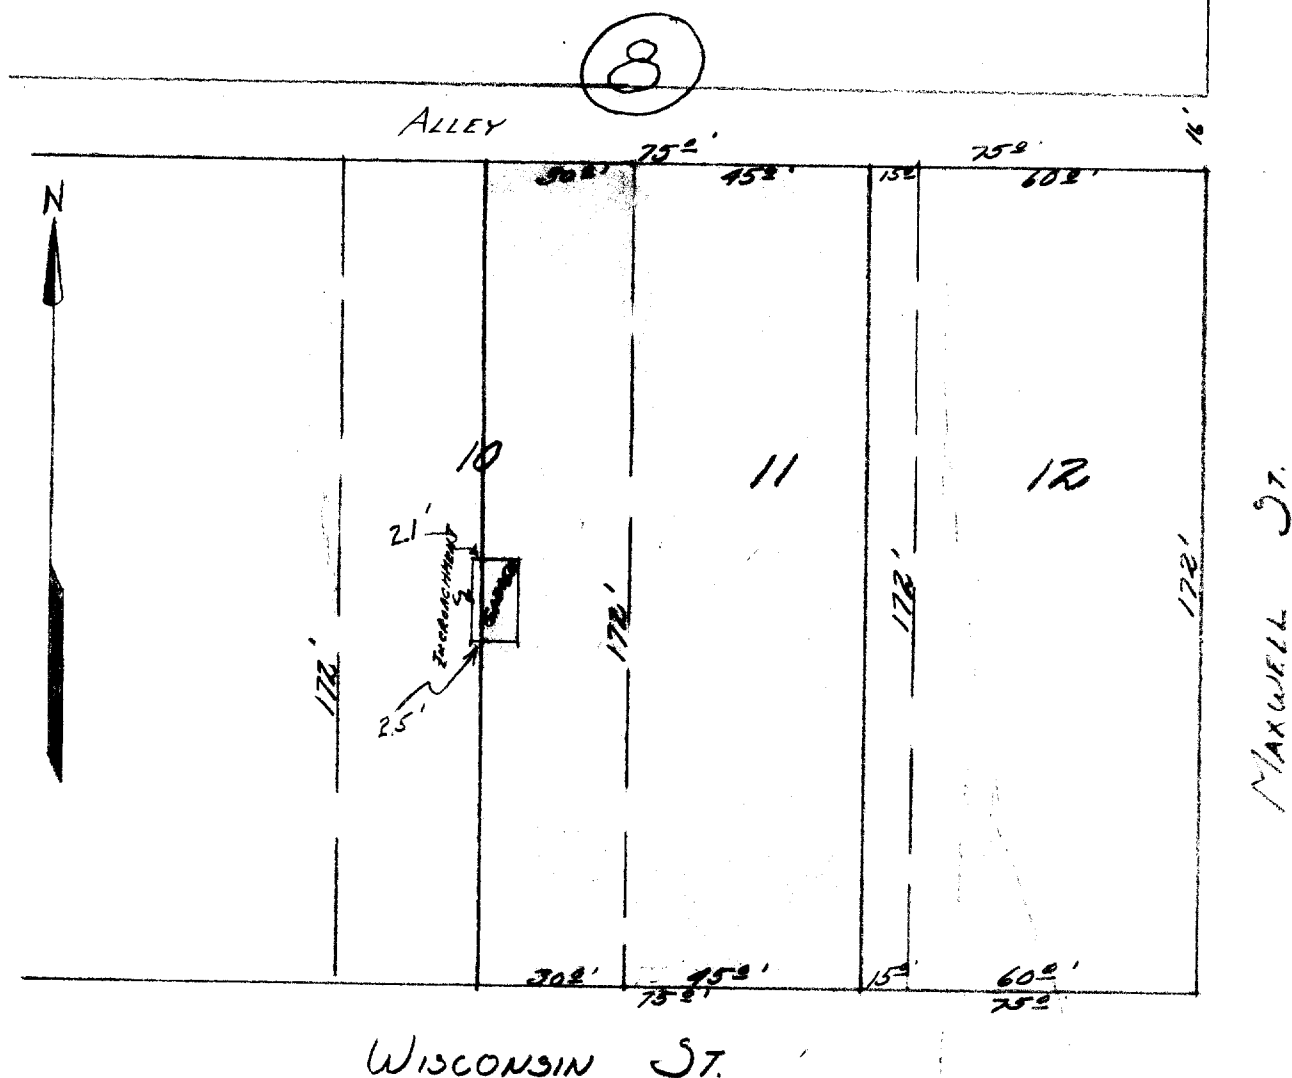

DESCRIPTION:

The West 45 feet of Lot 11, Block 8, and the East one half of Lot 10 Block 8, of the Original Plat of the City of Lake Geneva, Walworth County, Wisconsin.

CERTIFICATE:

I, hereby certify that I have on this the 14th day of May, 1955, surveyed the above described property according to the official record on file in the office of the Recorder of Deeds in and for Walworth County, Wisconsin, and find that the measurements and bearings of the boundary lines of said property as taken at the site on this day, substantially agree with said official record, and that the encroachment as shown on the plat above, was found to exist. Signed and sealed on this the 2nd day of June, 1955.

Joseph M. Biagi
Joseph M. Biagi, Professional Engineer.
Elkhorn Wisconsin.