


HAROLD H. KOLB
REGISTERED PROFESSIONAL LAND SURVEYOR
LAKE GENEVA, WISCONSIN

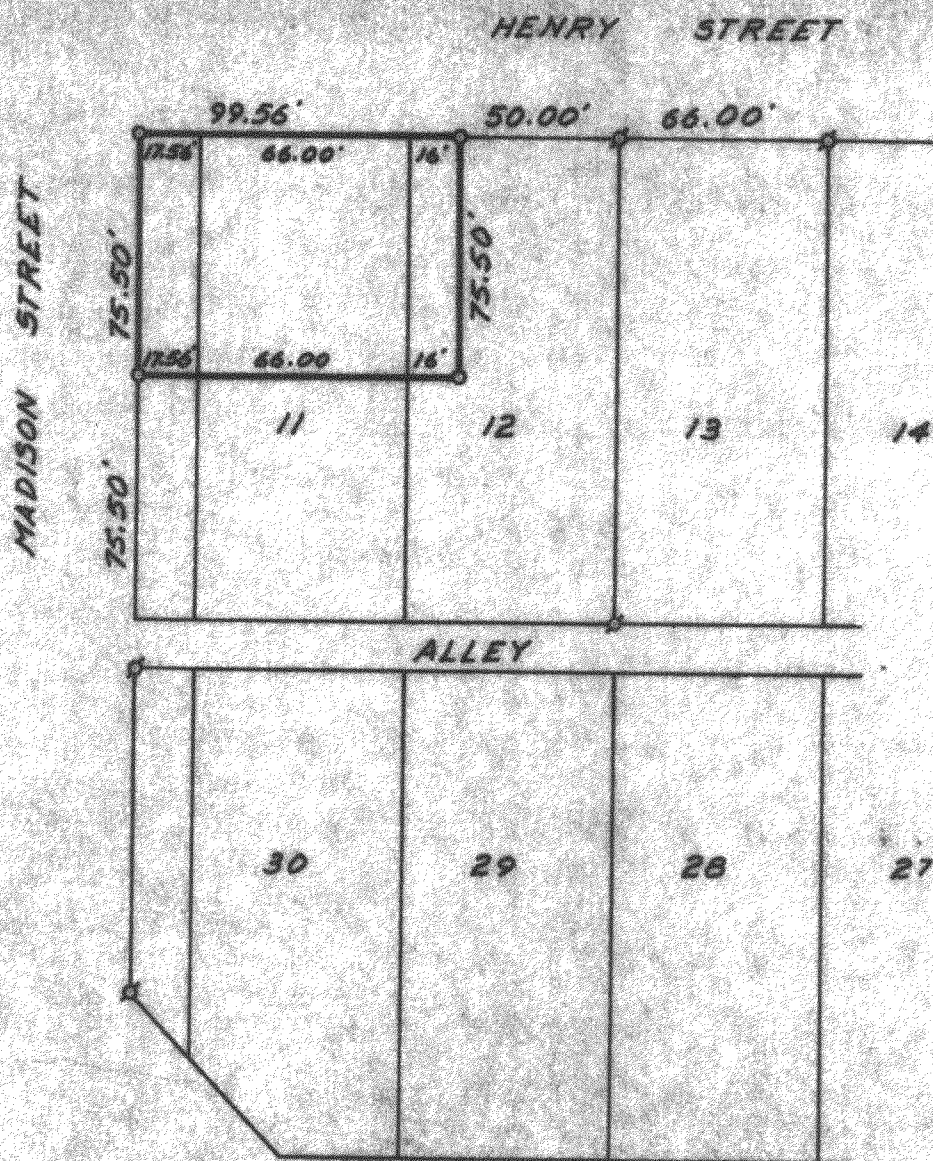

Scale 1"=60'

PLAT OF SURVEY OF
Part of Lots 11 and 12, Rich's Addition to the Village (New City)
of Lake Geneva, Walworth County, Wisconsin.

Harold H. Kolb

Harold H. Kolb, Wisconsin Surveyor, S-187
DATE: July 6, 1964

• Iron Pipe Found
o Iron Pipe Placed

7-175

ZRA-9A