



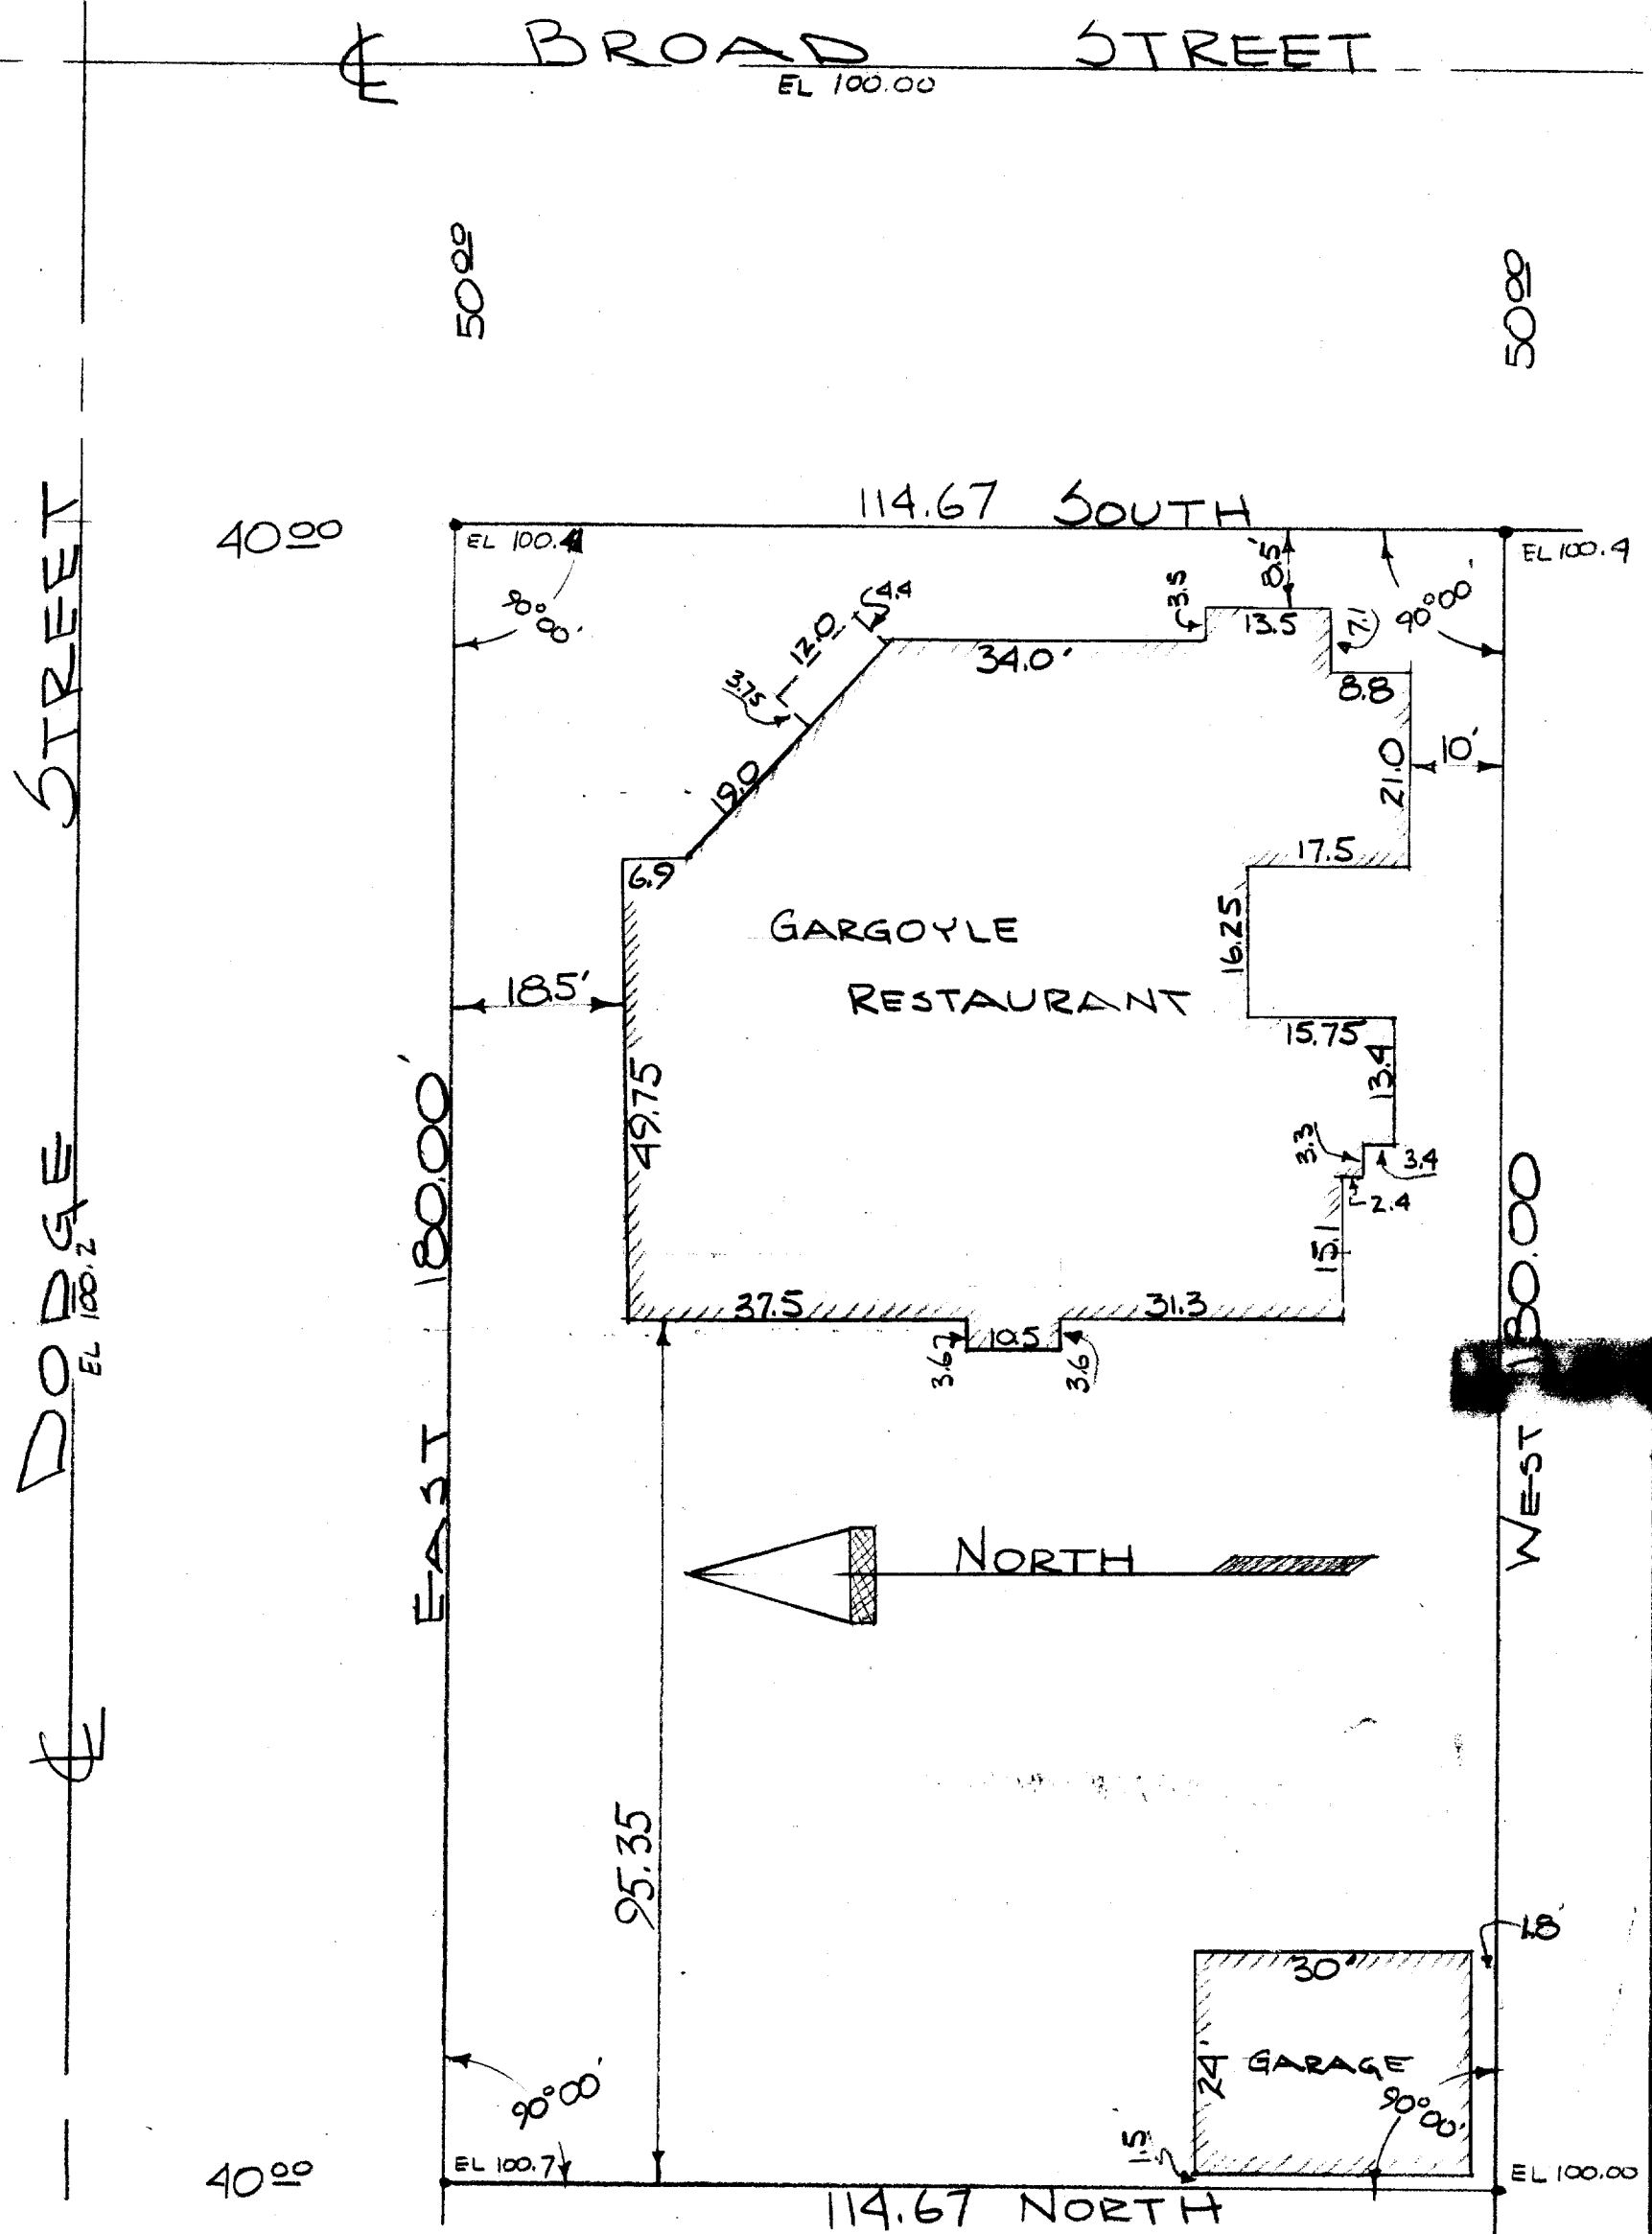

REFERENCE: The E 2740 (244,474) of lots 2, 3, 4 & 5 in Block 22 of the Original Plat of the City of Lake Geneva, Winnebago County, Wisconsin.

STATEMENT: I, James F. [redacted], hereby certify that I have surveyed the property known as [redacted] and that the location of the improvements are as shown on the drawing.

July 11, 1961

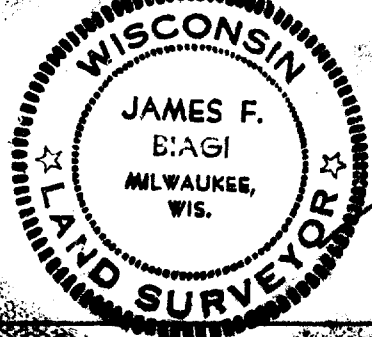

James F. Biaggini