


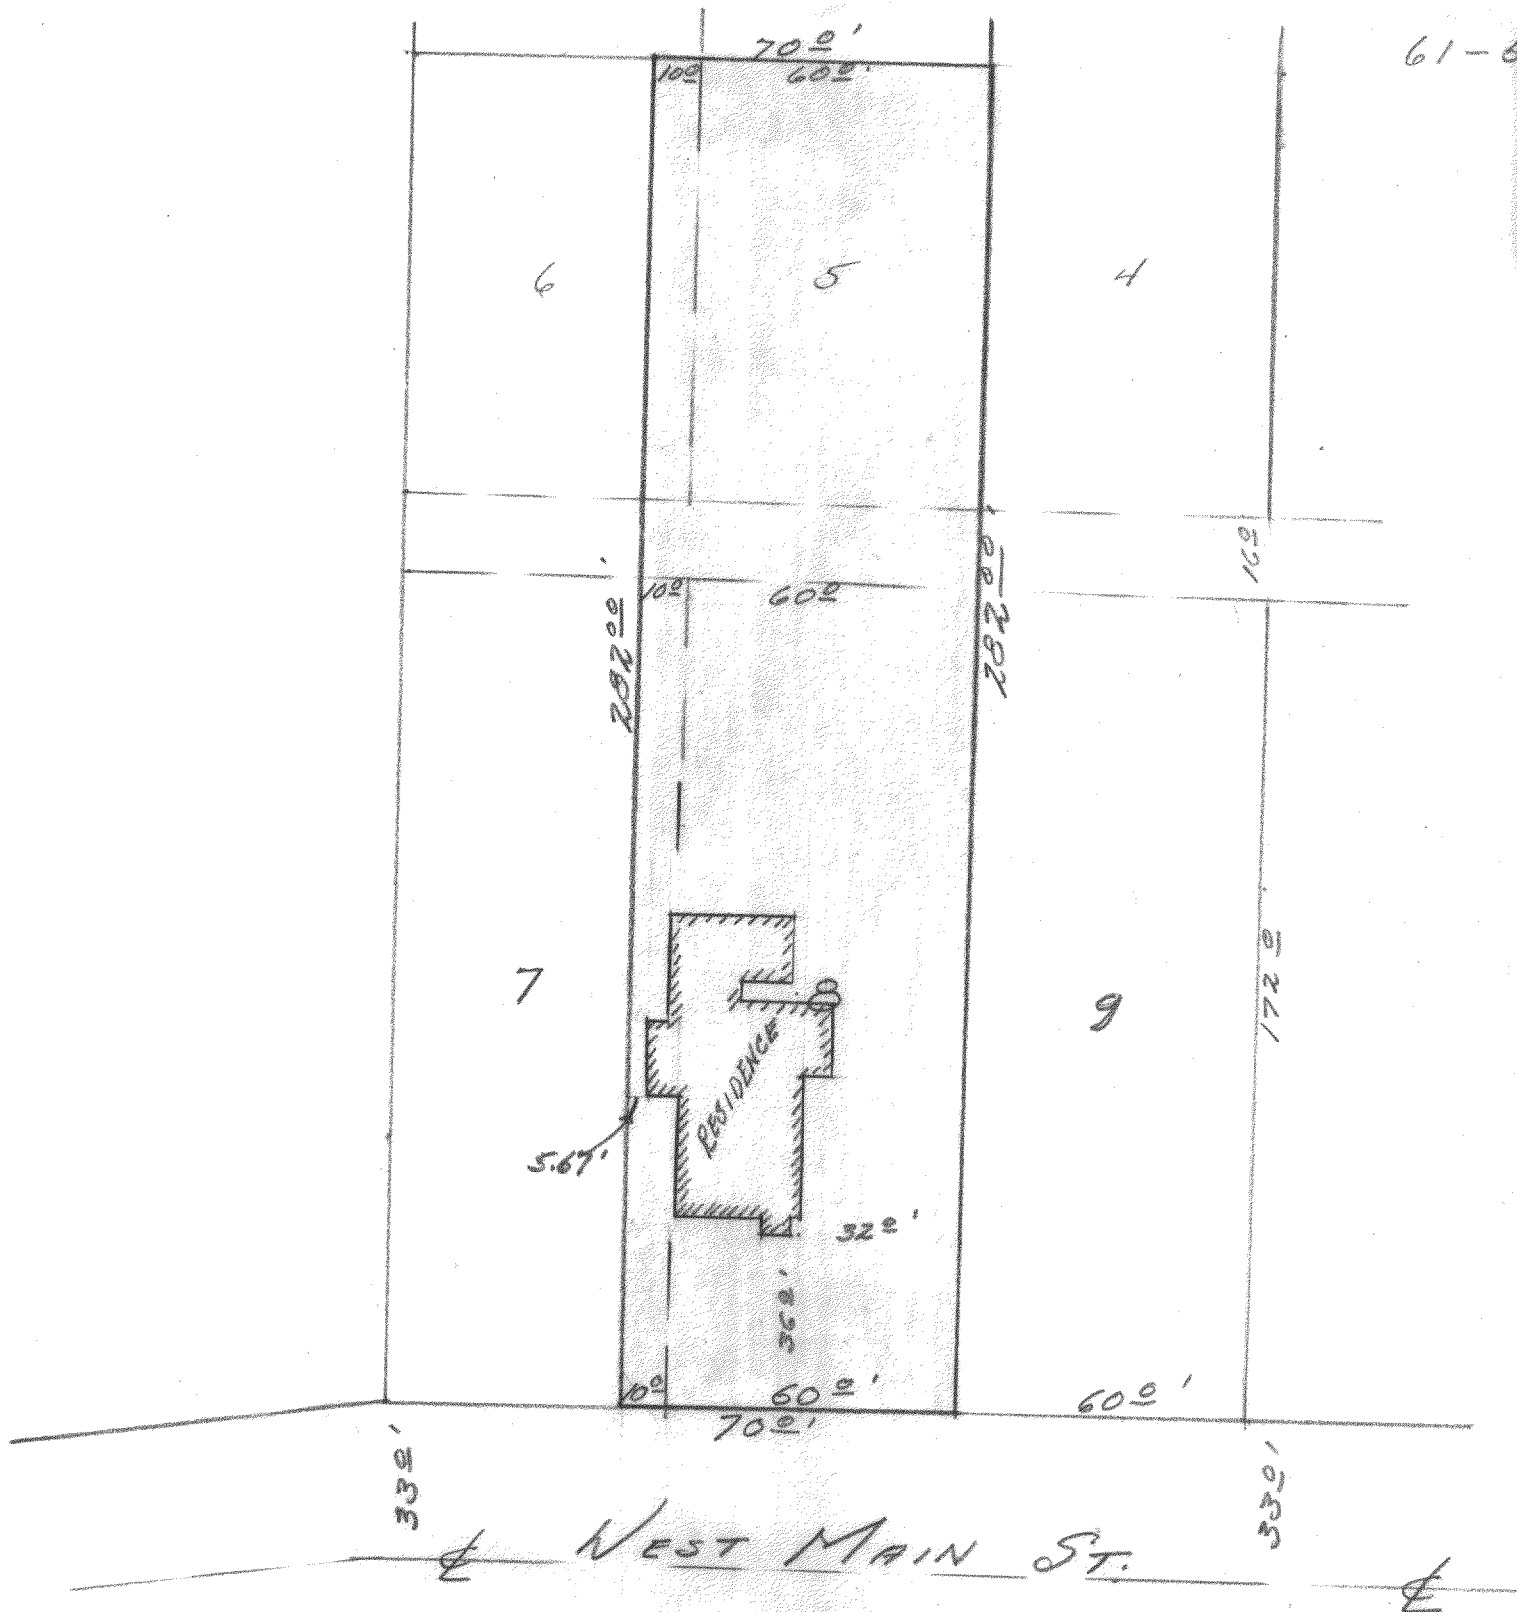

DESCRIPTION: The South $\frac{1}{2}$ of Lot 5, the east 10.00 feet of the south $\frac{1}{2}$ of Lot 6, the east 10.00 feet of Lot 7 and Lot 8 and the vacated alley adjacent to Lot 8 and the east 10.00 feet of Lot 7; all in Block 22 of the Original Plat of the City of Lake Geneva, Walworth County, Wisconsin.

CERTIFICATE: I, James F. Biagi, surveyor, do hereby certify that I have on this the 7th day of March, 1961, surveyed the above described property, and find that no encroachments exist and that the building located on said property is within the legal boundaries of said property as shown above.

SIGNED AND SEALED ON THIS THE 7TH DAY OF MARCH, 1961.

James F. Biagi
James F. Biagi, R.L.S. 272
ELKHORN WISCONSIN.