


52-28

PARK ROW.

100 S.

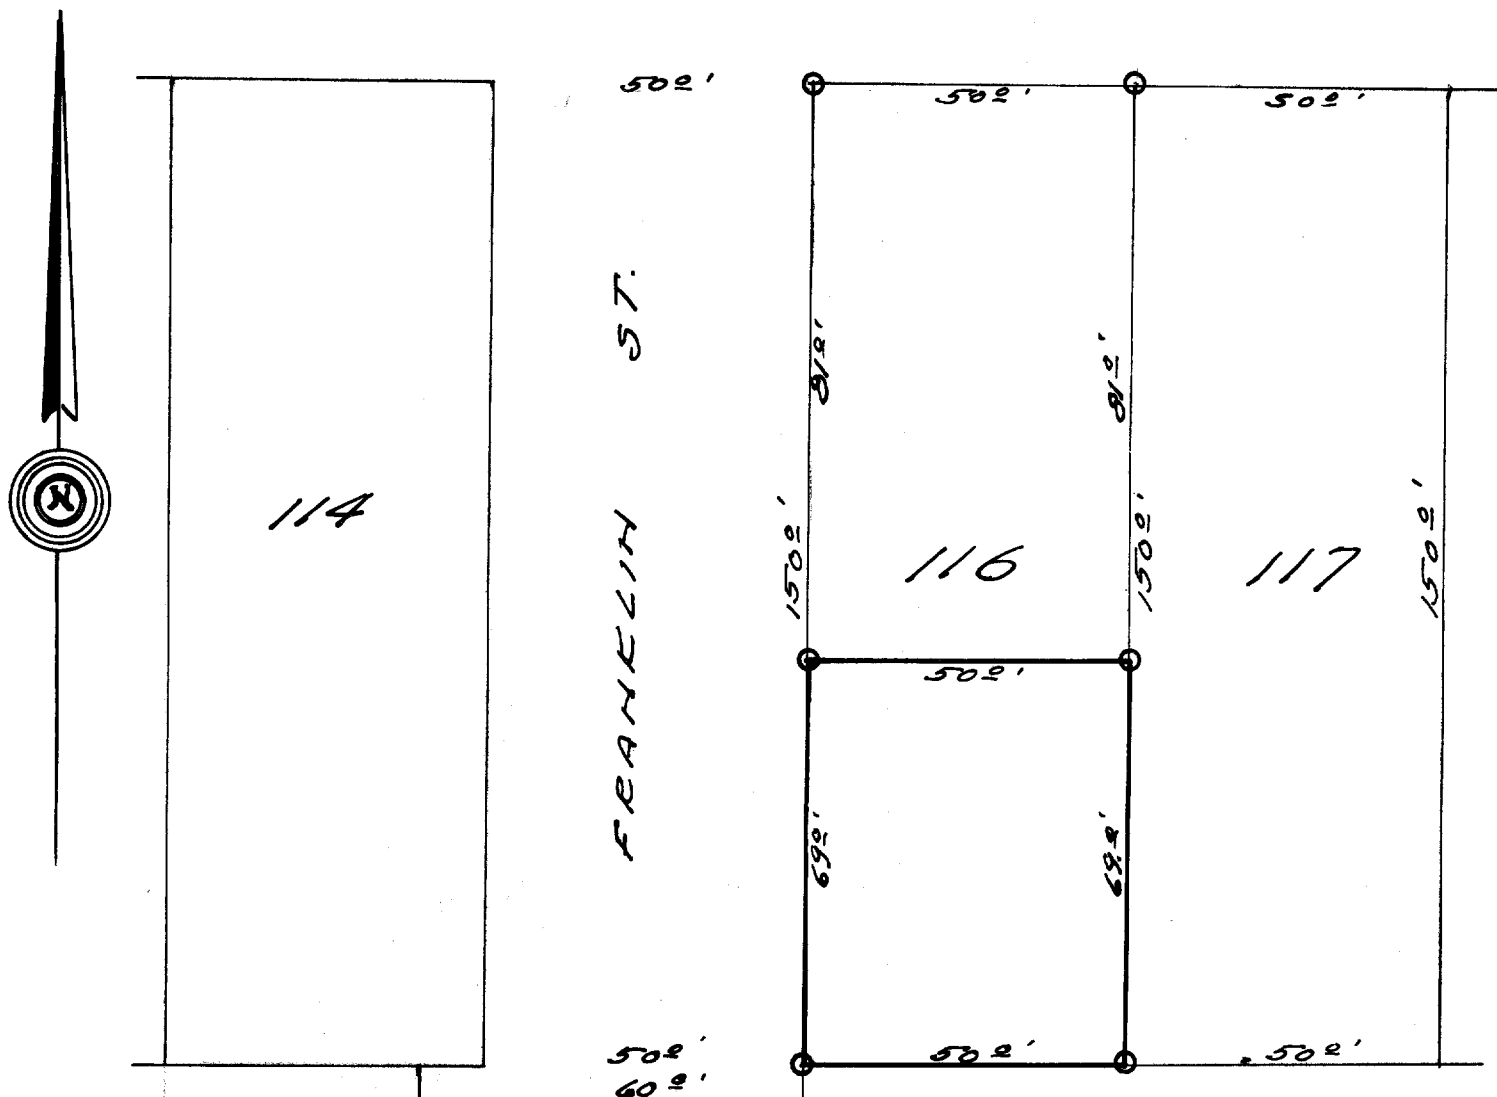

DESCRIPTION: The south 69.0 feet of Lot 116 Columbian Subdivision of a portion of the City of Lake Geneva, Walworth County, Wisconsin.

Certificate:

I, hereby certify that I have on this the 3rd day of May 1952, surveyed the above described property, and that the above is a true and correct representation of said survey and that no encroachments exist.

SIGNED AND SEALED ON THIS THE 7TH DAY OF MAY 1952.

Joseph M. Biagi, Professional Engineer
Elkhorn Wisconsin.

CL-88

7-17B.1