


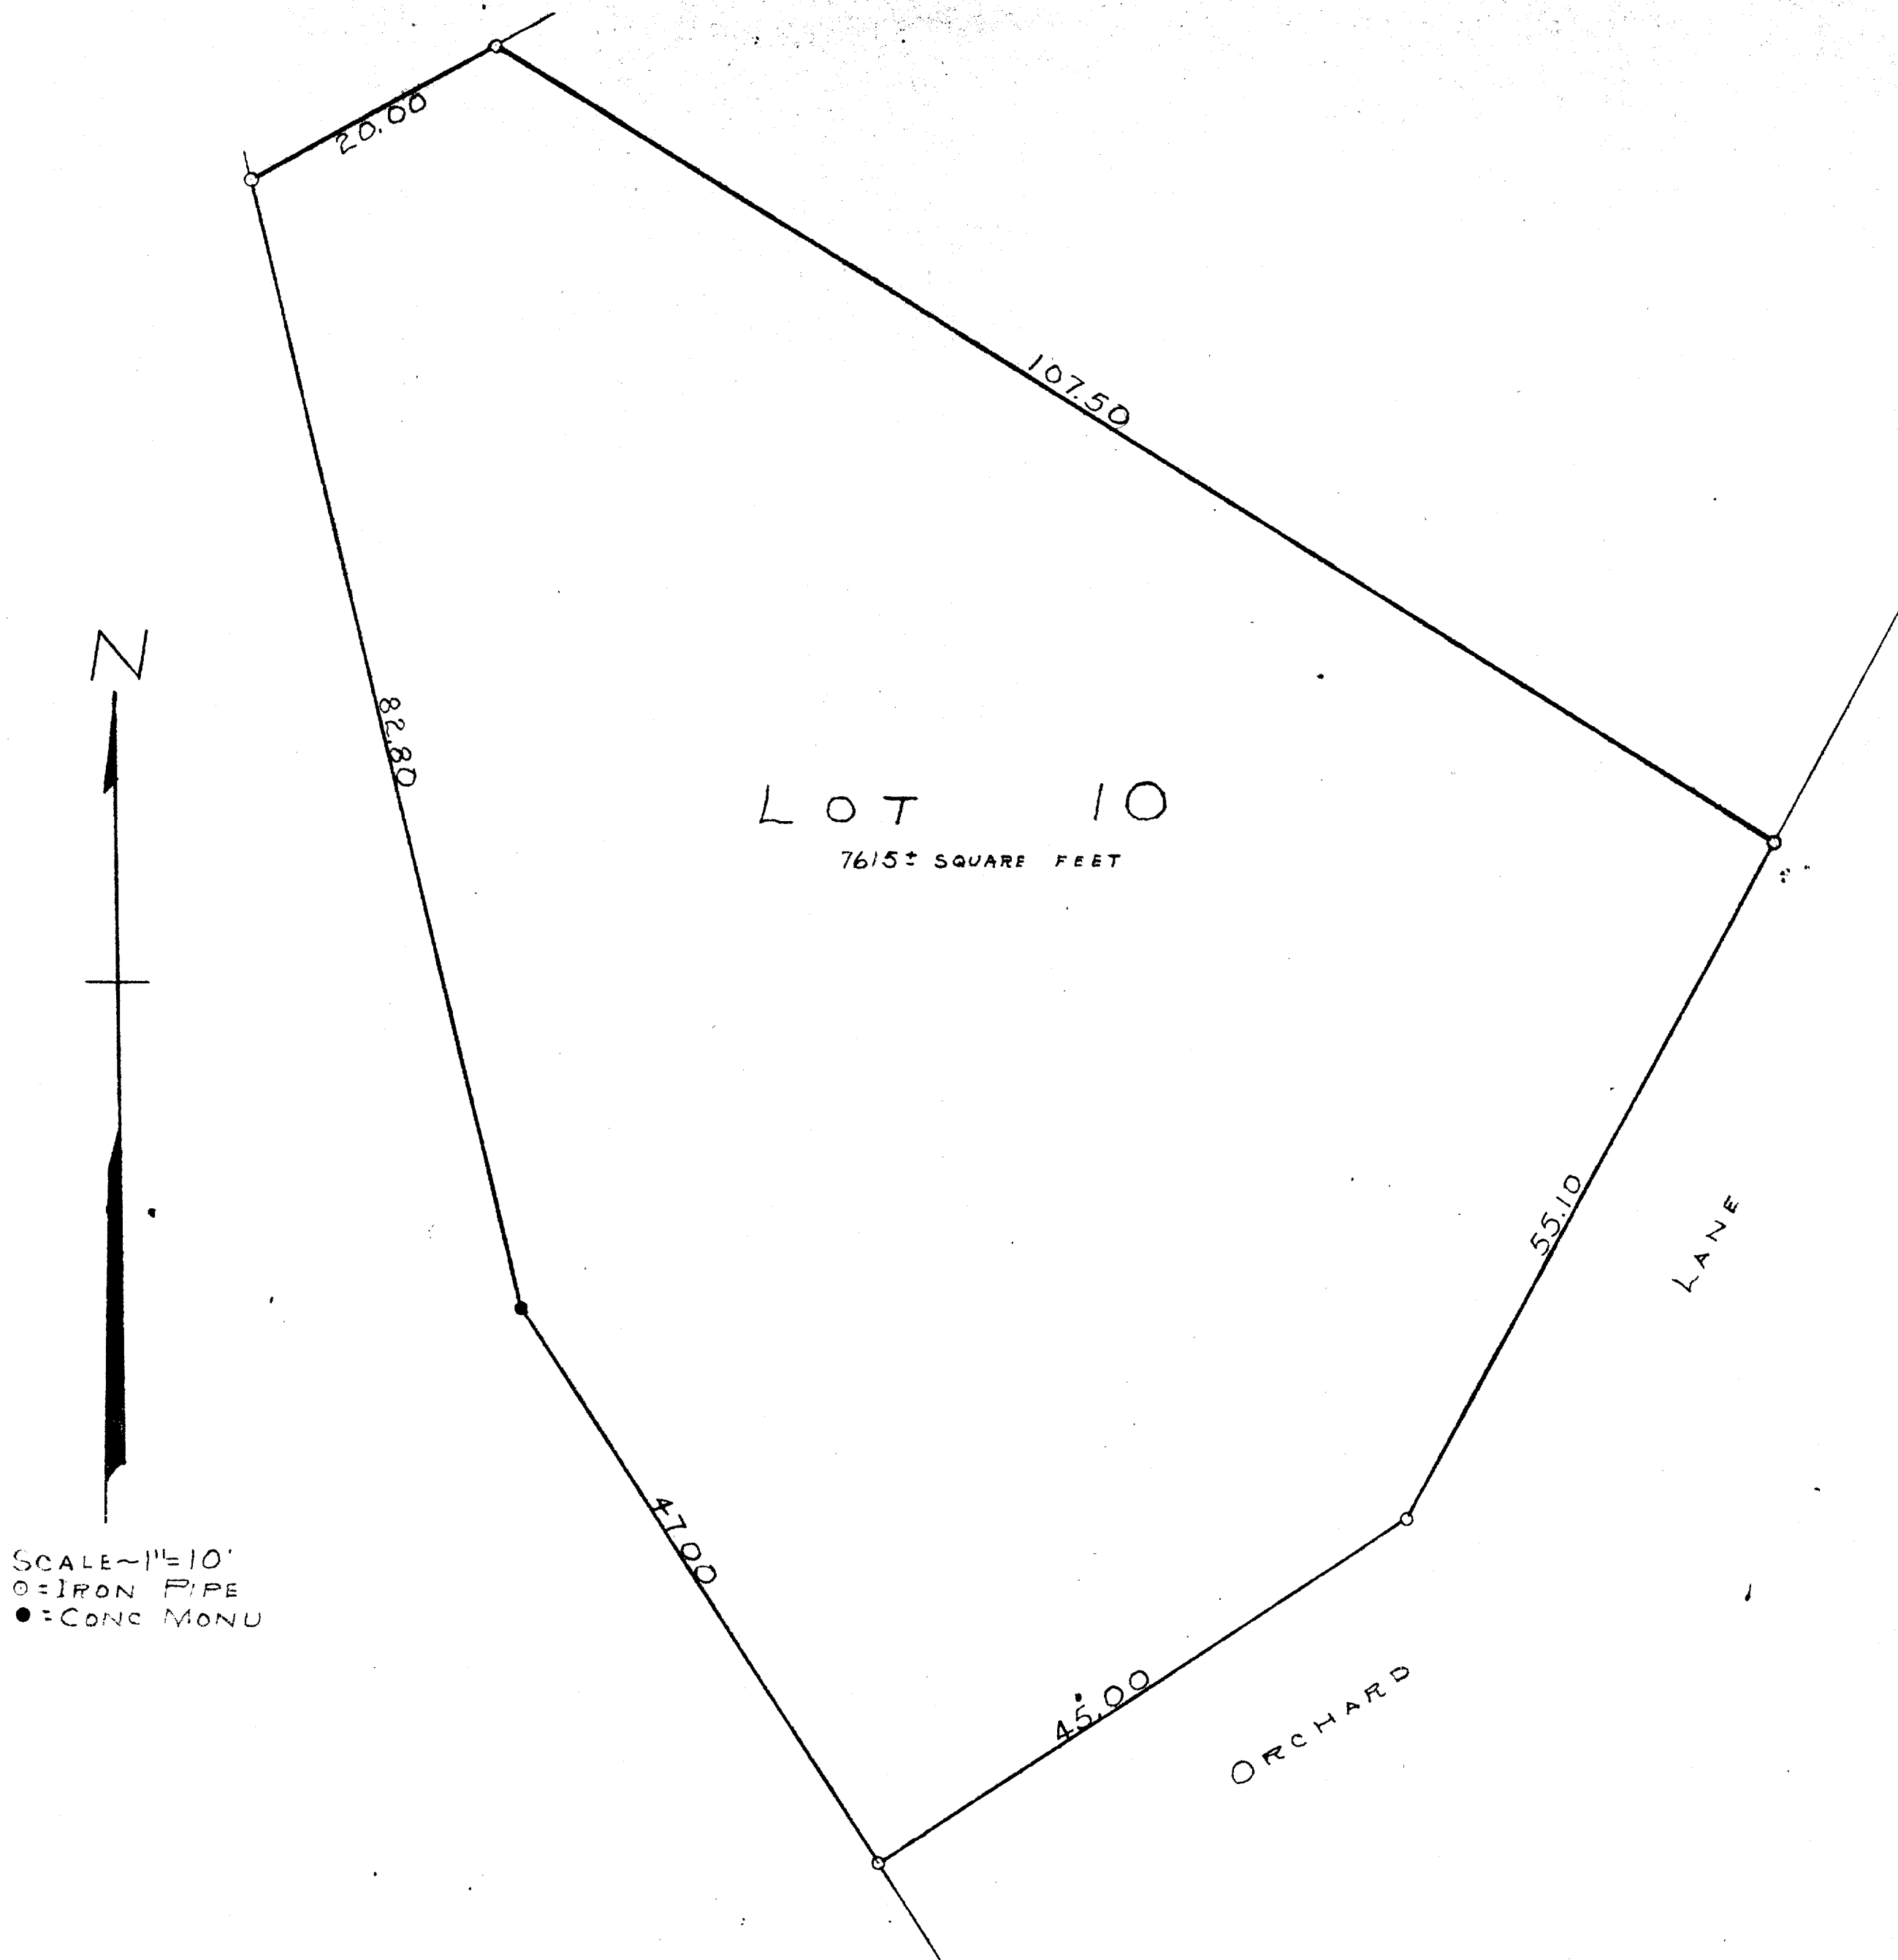

PLAT OF SURVEY OF LOT 10, BLOCK 10, LAKE GENEVA MANOR
TRACT NO. 17 LOCATED IN THE CITY OF LAKE GENEVA, WALWORTH
COUNTY, WISCONSIN
JUNE 1, 1953

George T. Dunham
GEORGE T. DUNHAM SURVEYOR
DELAYAN, WISCONSIN

LM-2

7-18